


FINAL	SURVEYED	BY	DATE
NOTE BOOK	TEMPLATE		
NO.	AREAS		
	CHUCKALD		

ORIGINAL	SURVEYED	BY	DATE
NOTE BOOK	TEMPLATE		
NO.	AREAS		
	CHUCKALD		

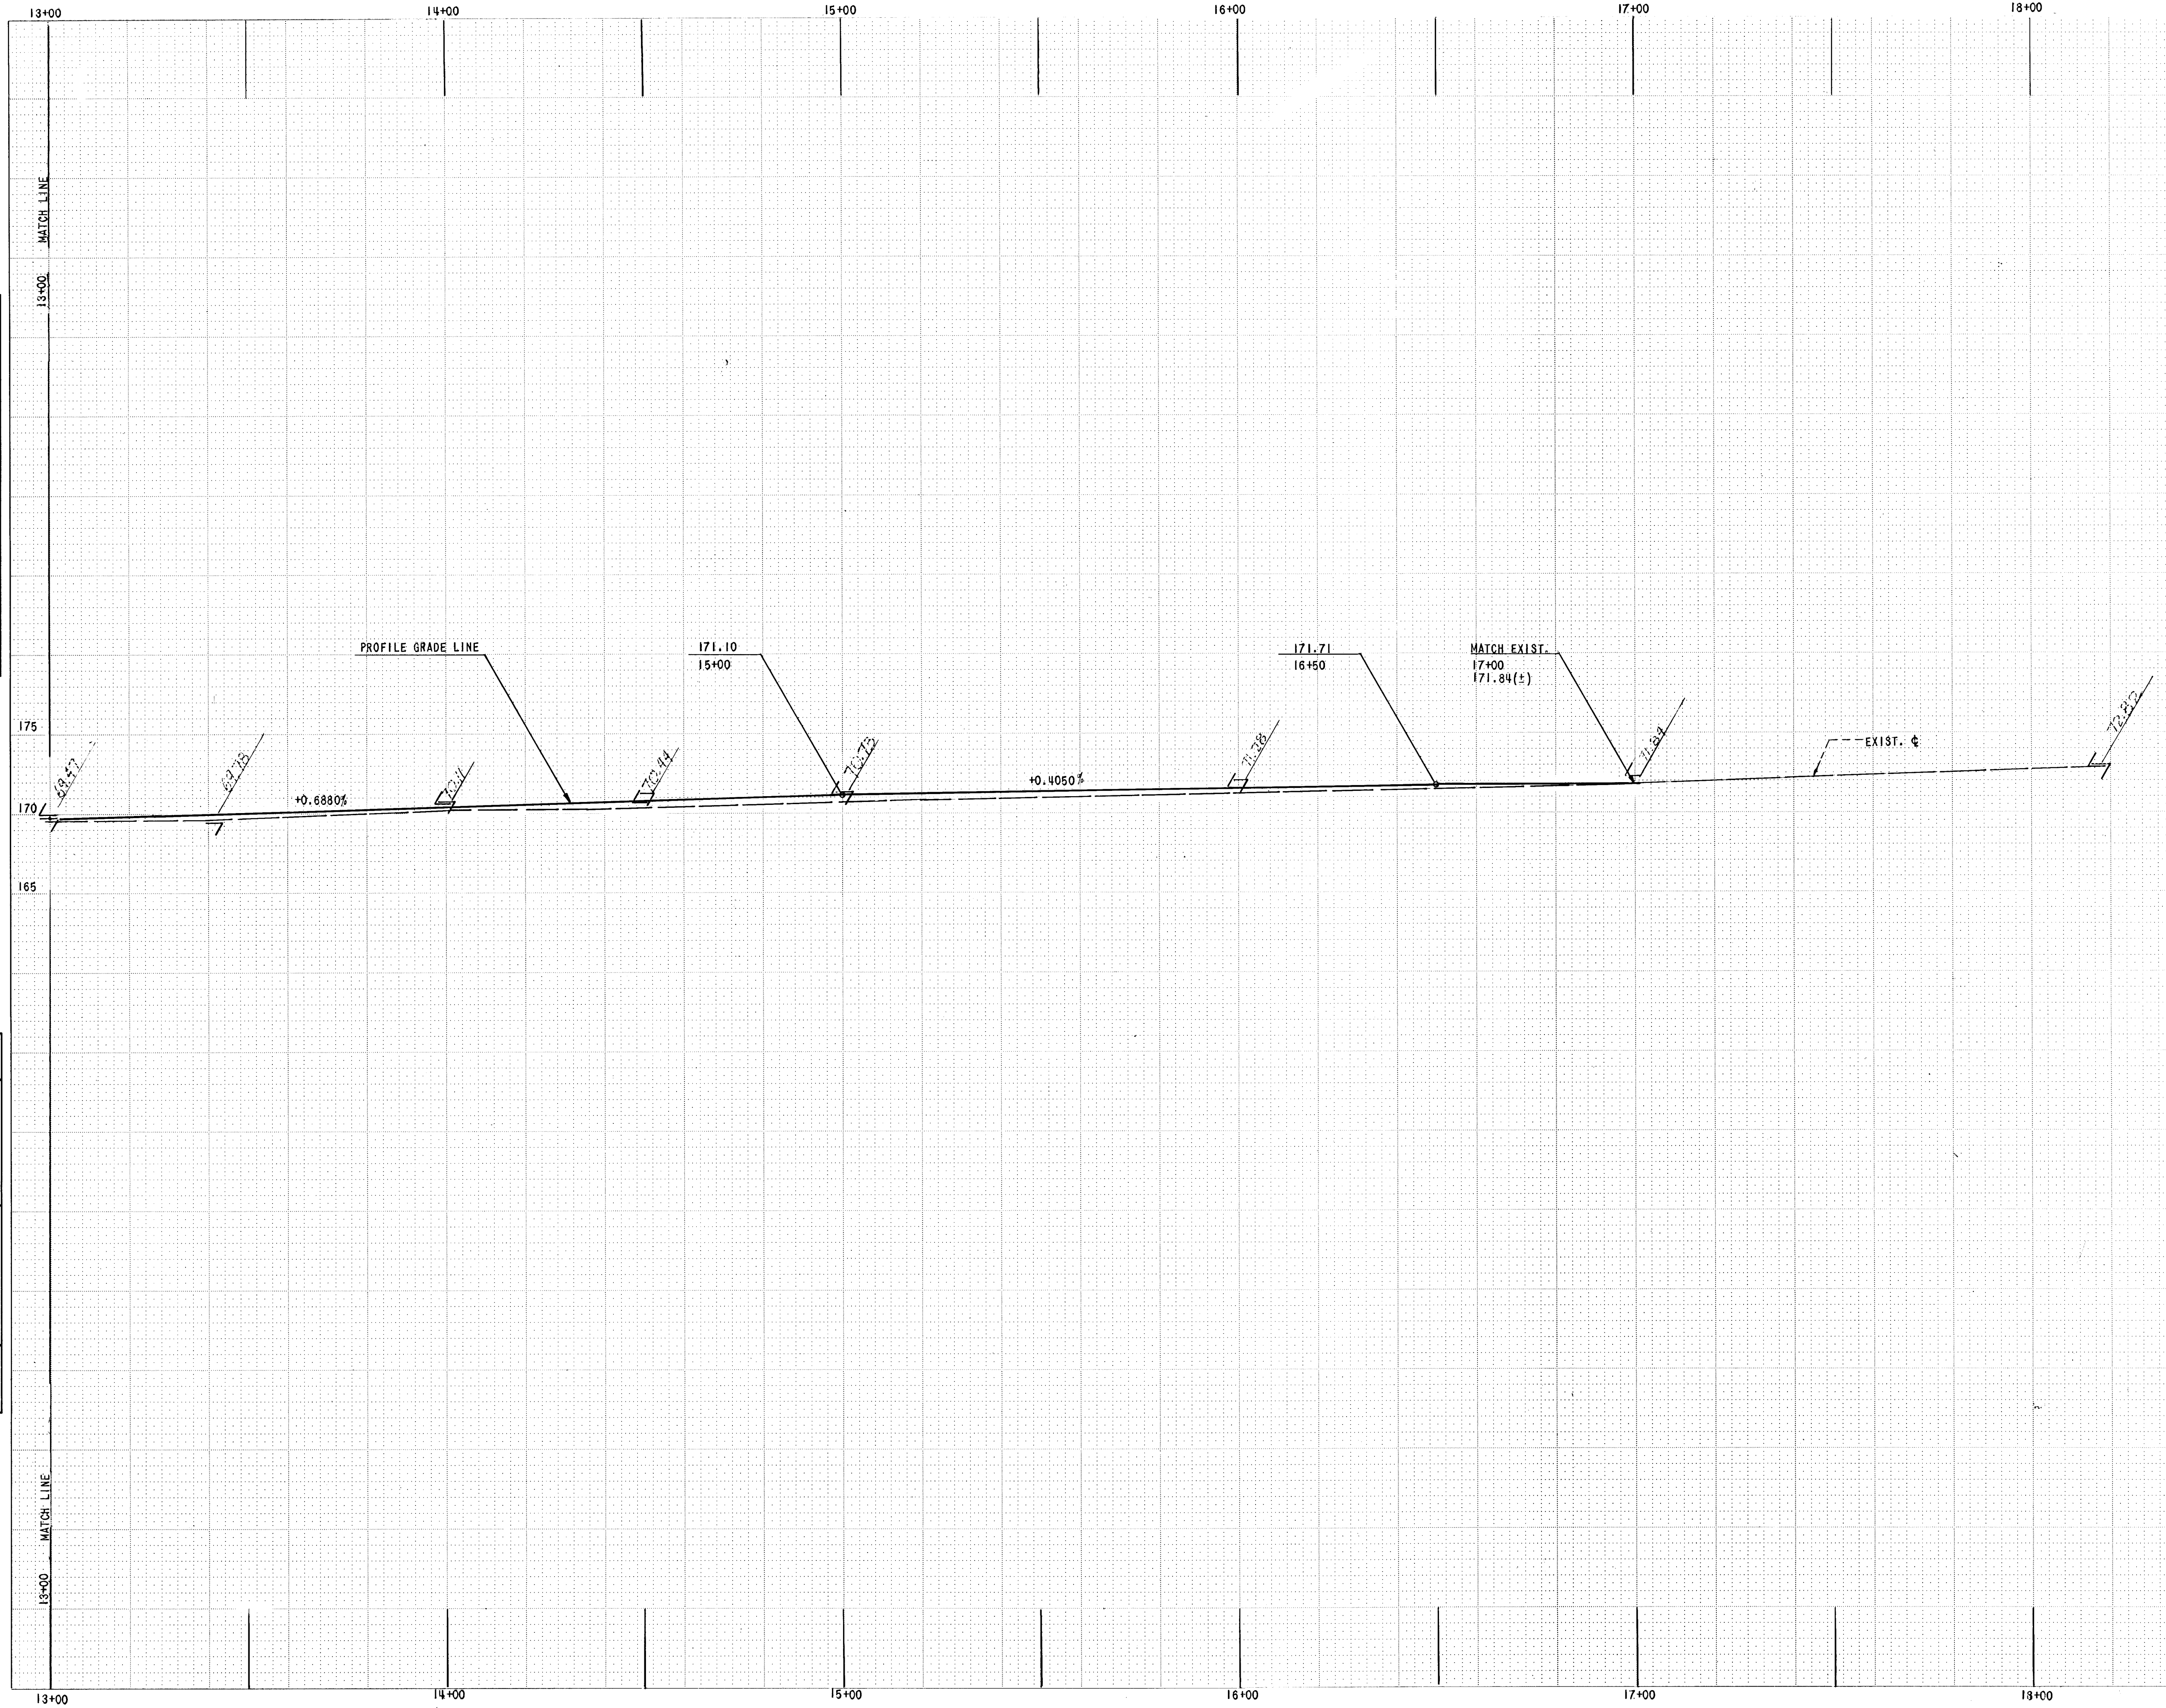

CITY	STATE	PROJECT NO.	FISCAL YEAR	SHEET NO.	TOTAL SHEETS
WICHITA	KANSAS	*	1982	10	22

* 472-76-245-81101-000-000-001

SCALE:
1" = 20' H
1" = 5' V

7 WEST PROPERTY LINE (EXIST.)
L EAST PROPERTY LINE (EXIST.)