





Emerald Bay Estates

RESERVE C

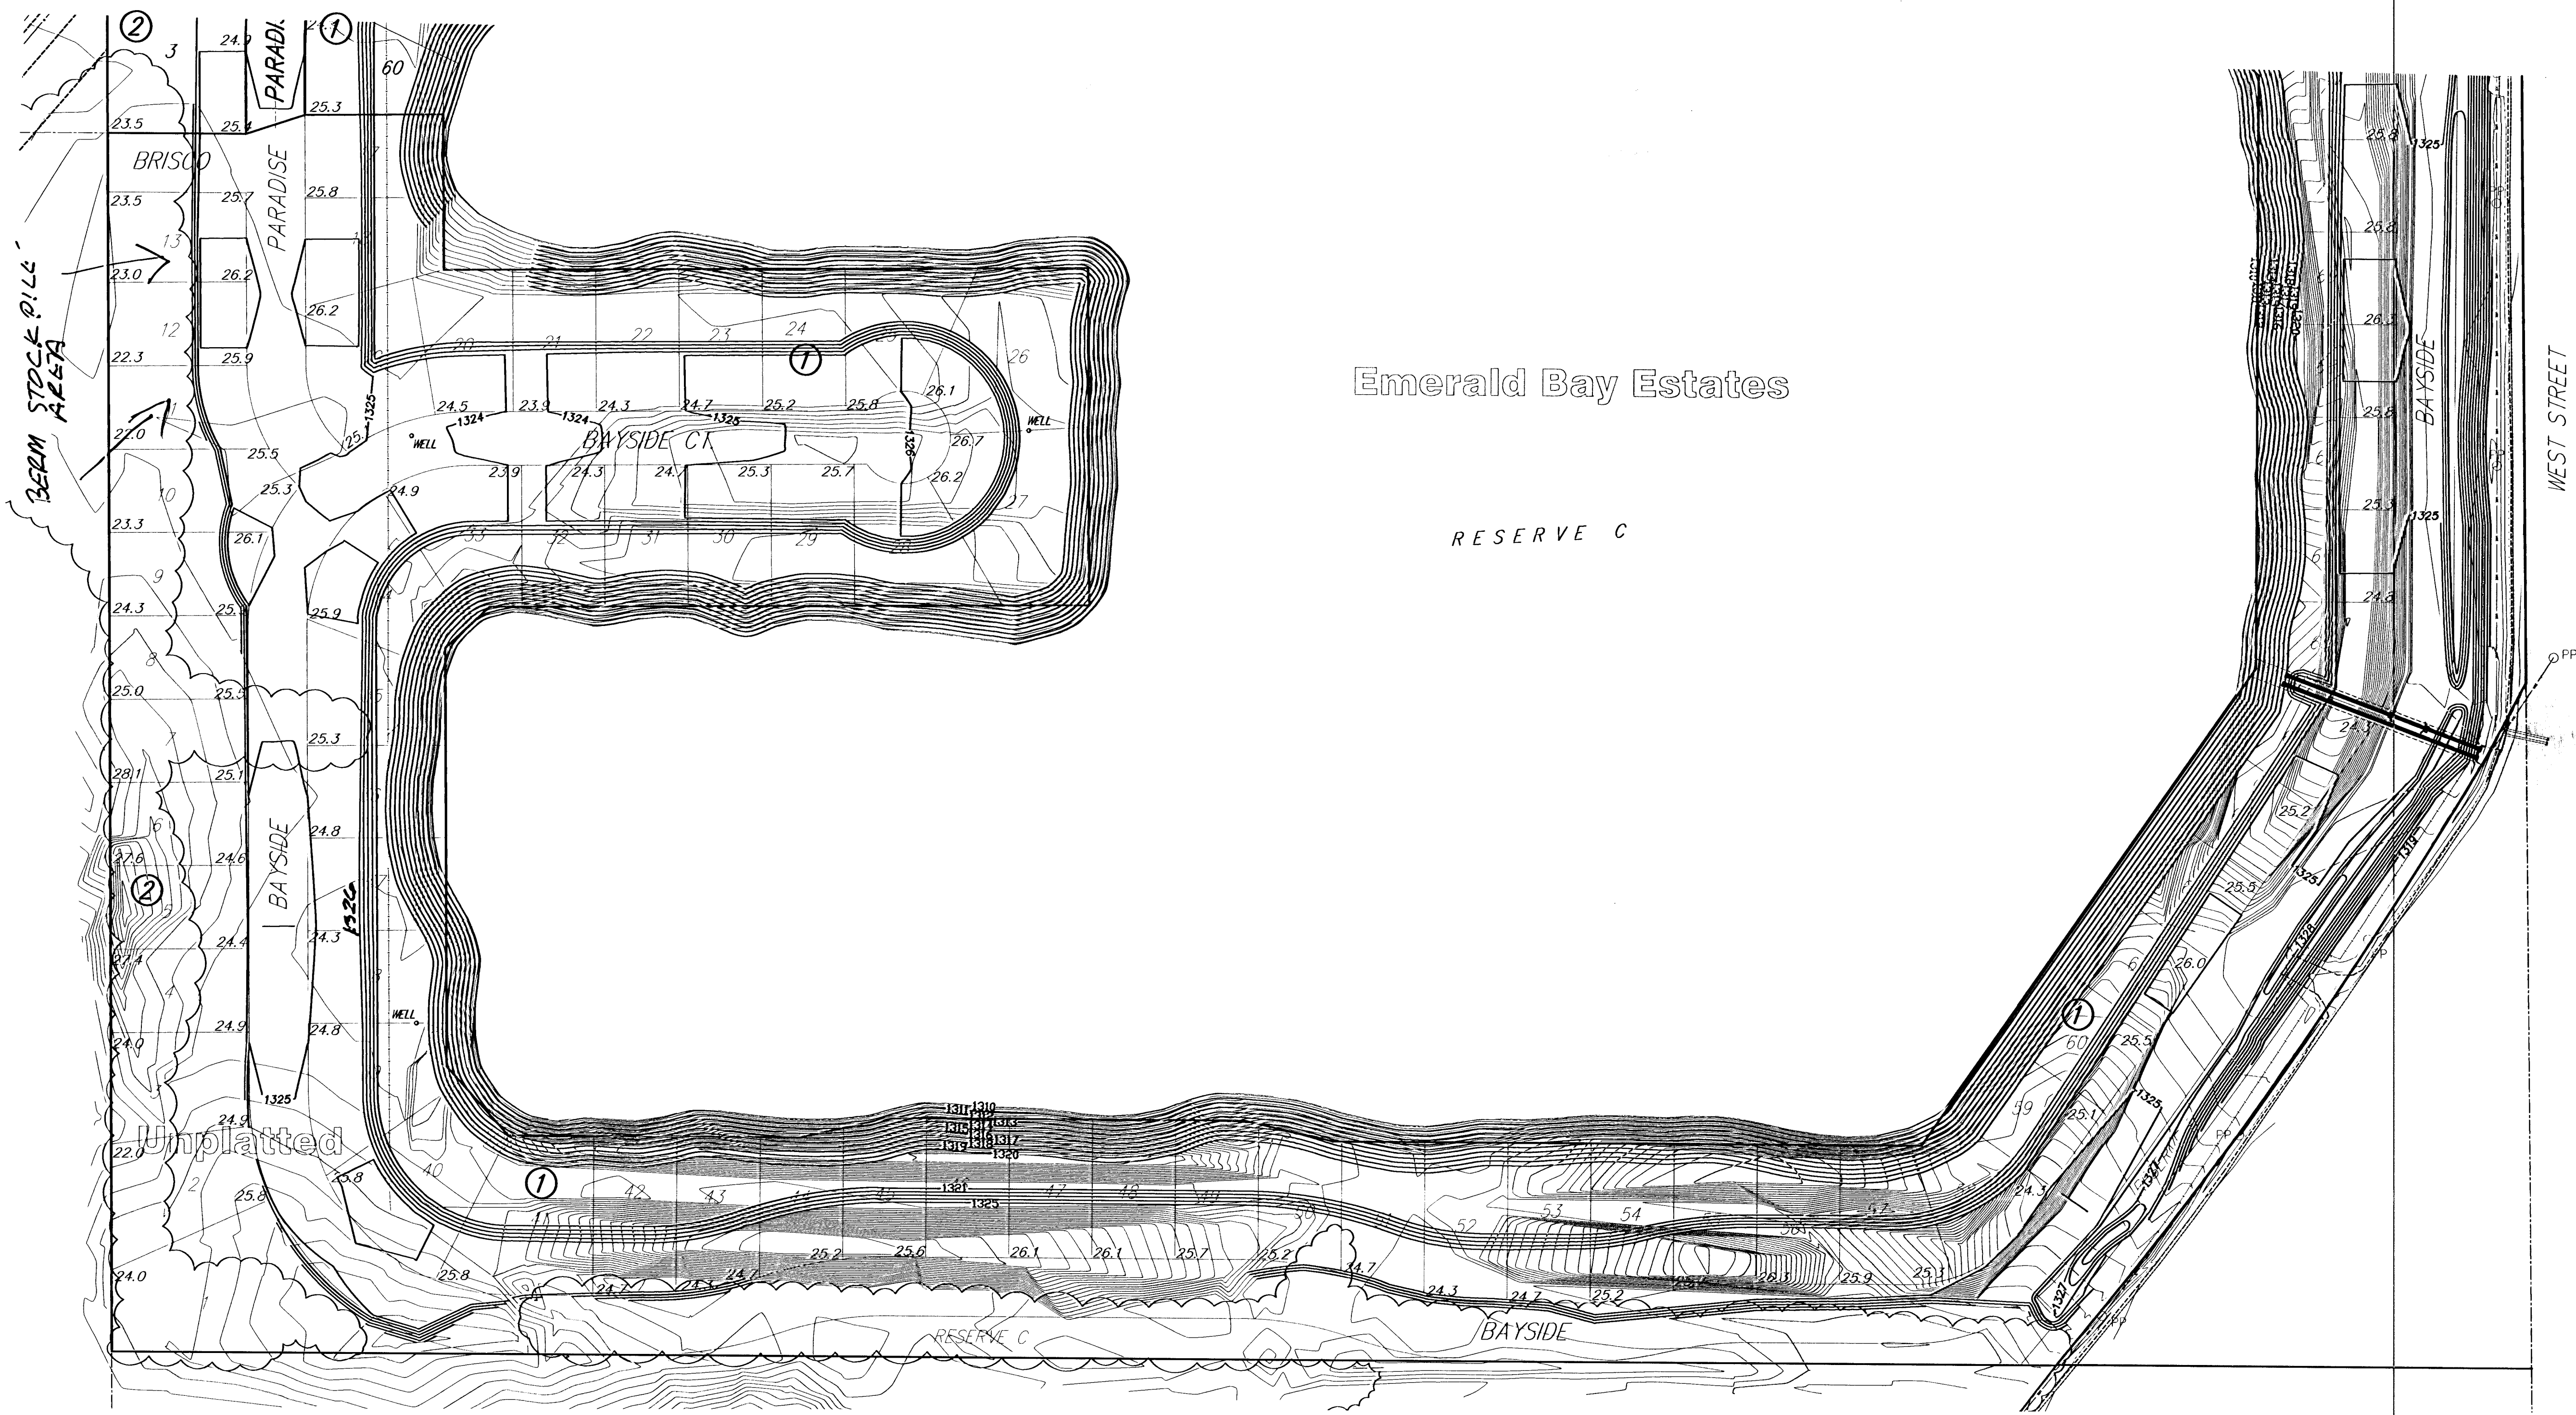

SCALE: 1" = 100'

Emerald Bay Estates  
Lot Grading Plan  
WICHITA, KANSAS

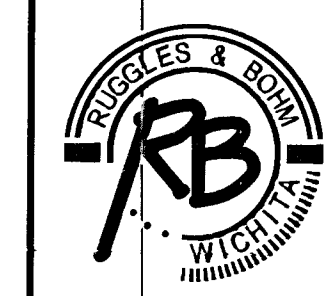

Ruggles & Bohm, P.A.  
Engineering, Surveying, Land Planning  
924 North Main  
Wichita, Kansas 67203  
www.rbkansas.com  
(318) 264-8008  
(318) 264-4621 fax  
E-mail: info@rbkansas.com

DRAWING FILE  
Grading [Four...02]

PROJECT NUMBER  
468-84140

|         |               |
|---------|---------------|
| DESIGN  | AML           |
| DRAWN   | AML           |
| REVIEW  |               |
| UTILITY |               |
| DATE    | Jan. 18, 2005 |
| SHEET   | 8             |
| OF      | 16            |