

Benchmarks:

"C" Cut on Top of Curb at West Line of Lot 7, Block A, Auburn Hills 5th Addition.
Elevation = 207.73 (City Datum)

Disc in Back of Curb, North of Front Corner Common to Lots 23 and 24, Block D, Auburn Hills 12th Addition.
Elevation = 191.84 (City Datum)

"C" Cut on Center of Catch Basin North of Lot Corner Common to Lots 1 and 15, Block B, Auburn Hills 14th Addition.
Elevation = 193.65 (City Datum)

Sta. 0+00, Begin Line 2
Remove Existing 4" Stub from Manhole and Core for 8" Pipe. Extend 8" Pipe North. Contractor to Verify Depth and Location of Existing Stub Prior to Construction.

Sta. 1+79.3, Line 2
Construct Standard Manhole.
Top Elev. = 203.70

Sta. 4+21.6, Line 2
= Sta. 0+00, Line 2A
Construct Standard Manhole.
Top Elev. = 203.20

Sta. 5+54.8, Line 2
Construct Standard Manhole.
Top Elev. = 206.90

Sta. 5+98.4 to Sta. 6+31.4
Install 33.0 L.F. Flowable Fill Per City Specifications.

Sta. 9+29.6, Line 2
Construct Standard Manhole.
Top Elev. = 203.00


Sta. 11+61.7, End Line 2
Construct Standard Manhole.
1 - 4" Stub (E)
Top Elev. = 205.30

Scale:
1" = 40' Horizontal
1" = 5' Vertical
• = Iron

SEWER SERVICE TABLE

NUMBER	TYPE	LOCATION			STATION DIRECTION	FOR INFORMATION ONLY APPROXIMATE LENGTH 4" PIPE	
		LOT NO.	BLOCK NO.	LINE NO.		VERTICAL	HORIZONTAL
2	8" x 4" Tee Saddle	6	C	2	0+92/Rt.	13.5'	16'
3	8" x 4" Tee Saddle	15	D	2	3+42/Lt.	10'	6.5'
4	8" x 4" Tee Saddle	14	D	2	3+67/Rt.	9.5'	13.5'
5	8" x 4" Tee Saddle	13	D	2	4+94/Rt.	10'	7'
6	8" x 4" Tee Saddle	12	D	2	5+07/Lt.	10.5'	13'
7	8" x 4" Tee Saddle	6	D	2	6+55/Rt.	10.5'	13'
8	8" x 4" Tee Saddle	7	D	2	7+38/Lt.	7'	7'
9	8" x 4" Tee Saddle	5	D	2	7+92/Rt.	6'	13'

NOTE: Vertical Riser Pipe shall be extended to 2' minimum above ground water elevation and 4' maximum below proposed ground elevation.

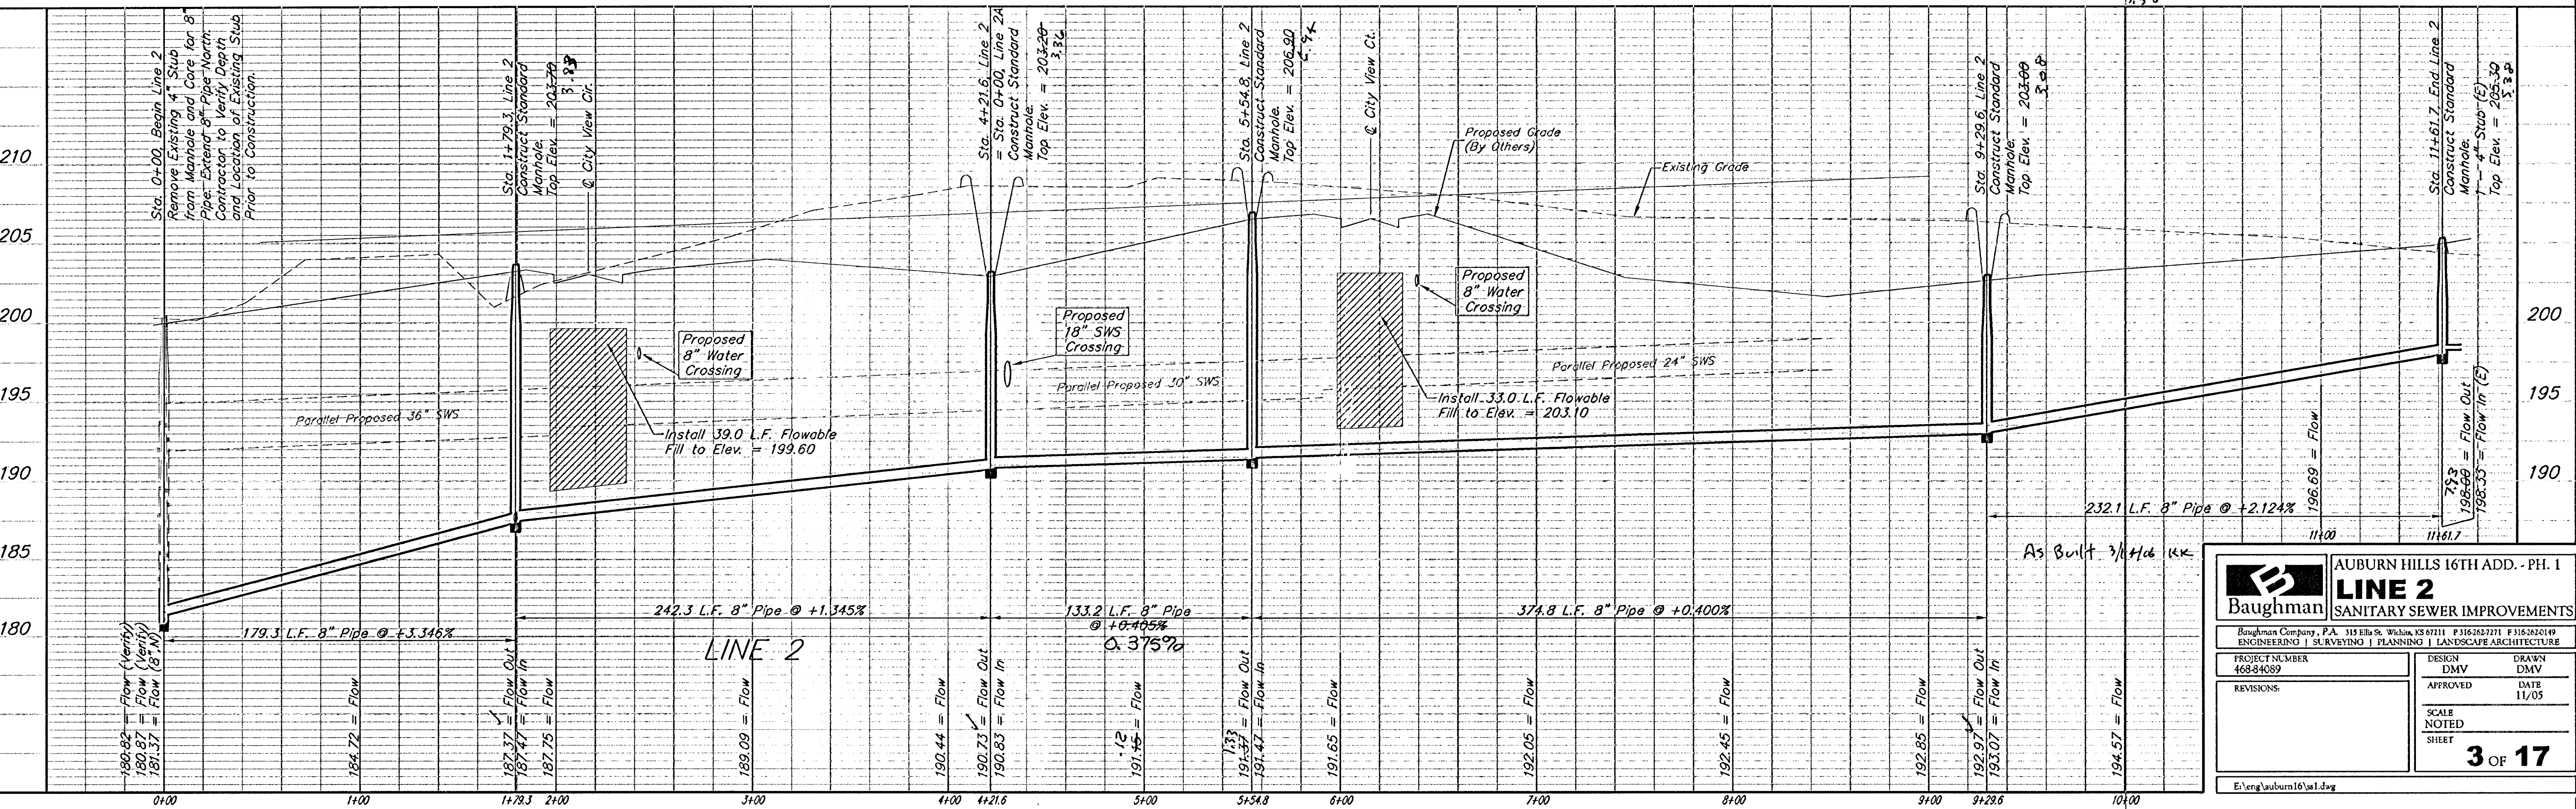

Baughman

ENGINEERING | SURVEYING | PLANNING | LANDSCAPE ARCHITECTURE

PROJECT NUMBER
468-84089

REVISIONS

DESIGN
DMV

APPROVED

DRAWN
DMV

DATE
11/05

SCALE
NOTED

SHEET
3 OF 17

E:\eng\auburn16\w1.dwg