


Benchmarks:

"C" Cut on Top of Curb at West Line of Lot 7, Block A, Auburn Hills 5th Addition.
Elevation = 207.73 (City Datum)

Disc in Back of Curb, North of Front Corner Common to Lots 23 and 24, Block D, Auburn Hills 12th Addition.
Elevation = 191.84 (City Datum)

"C" Cut on Center of Catch Basin North of Lot Corner Common to Lots 1 and 15, Block B, Auburn Hills 14th Addition.
Elevation = 193.65 (City Datum)

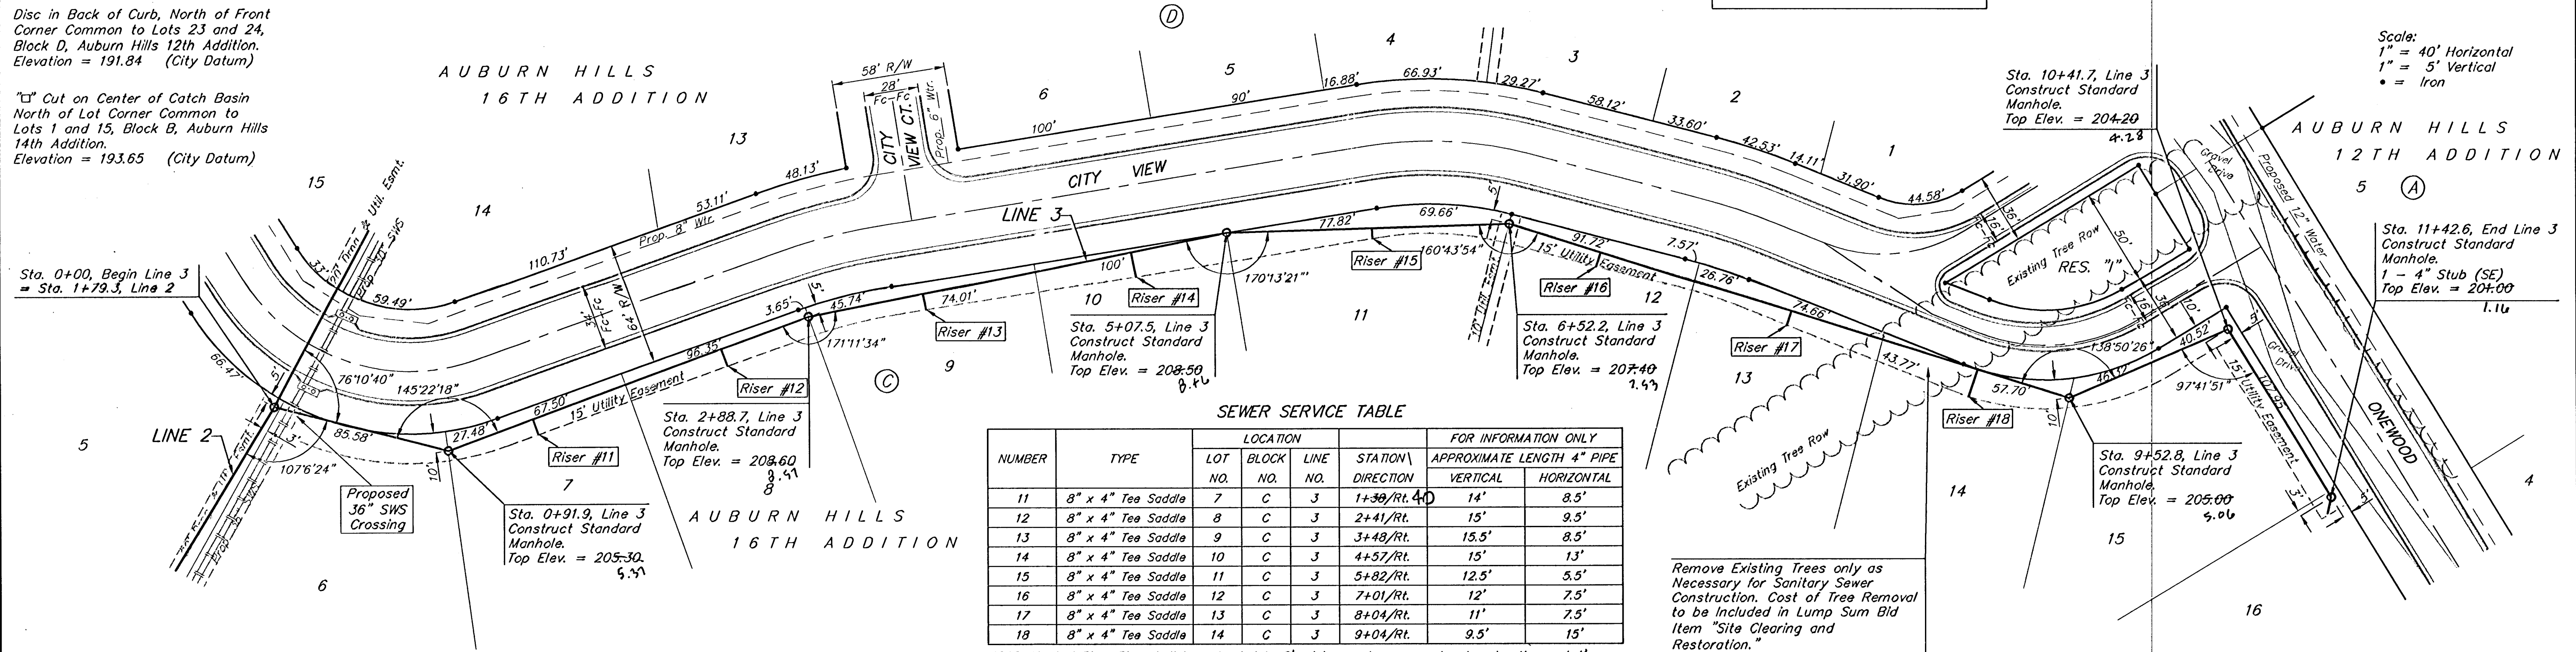

The contractor shall be required to backfill trench with sand from Sta. 0+00 to Sta. 11+42.6, Line 3 Sand Backfill shall be bid per L.F. as "Sand Backfill Jetted and Vibrated."


Scale:
1" = 40' Horizontal
1" = 5' Vertical
• = Iron

SEWER SERVICE TABLE

NUMBER	TYPE	LOCATION			FOR INFORMATION ONLY	
		LOT NO.	BLOCK NO.	LINE NO.	STATION\ DIRECTION	APPROXIMATE LENGTH 4" PIPE VERTICAL HORIZONTAL
11	8" x 4" Tee Saddle	7	C	3	1+39/Rt. 40'	14' 8.5'
12	8" x 4" Tee Saddle	8	C	3	2+41/Rt. 15'	9.5'
13	8" x 4" Tee Saddle	9	C	3	3+43/Rt. 15.5'	8.5'
14	8" x 4" Tee Saddle	10	C	3	4+57/Rt. 15'	13'
15	8" x 4" Tee Saddle	11	C	3	5+82/Rt. 12.5'	5.5'
16	8" x 4" Tee Saddle	12	C	3	7+01/Rt. 12'	7.5'
17	8" x 4" Tee Saddle	13	C	3	8+04/Rt. 11'	7.5'
18	8" x 4" Tee Saddle	14	C	3	9+04/Rt. 9.5'	15'

NOTE: Vertical Riser Pipe shall be extended to 2' minimum above ground water elevation and 4' maximum below proposed ground elevation.

Remove Existing Trees only as Necessary for Sanitary Sewer Construction. Cost of Tree Removal to be Included in Lump Sum Bid Item "Site Clearing and Restoration."

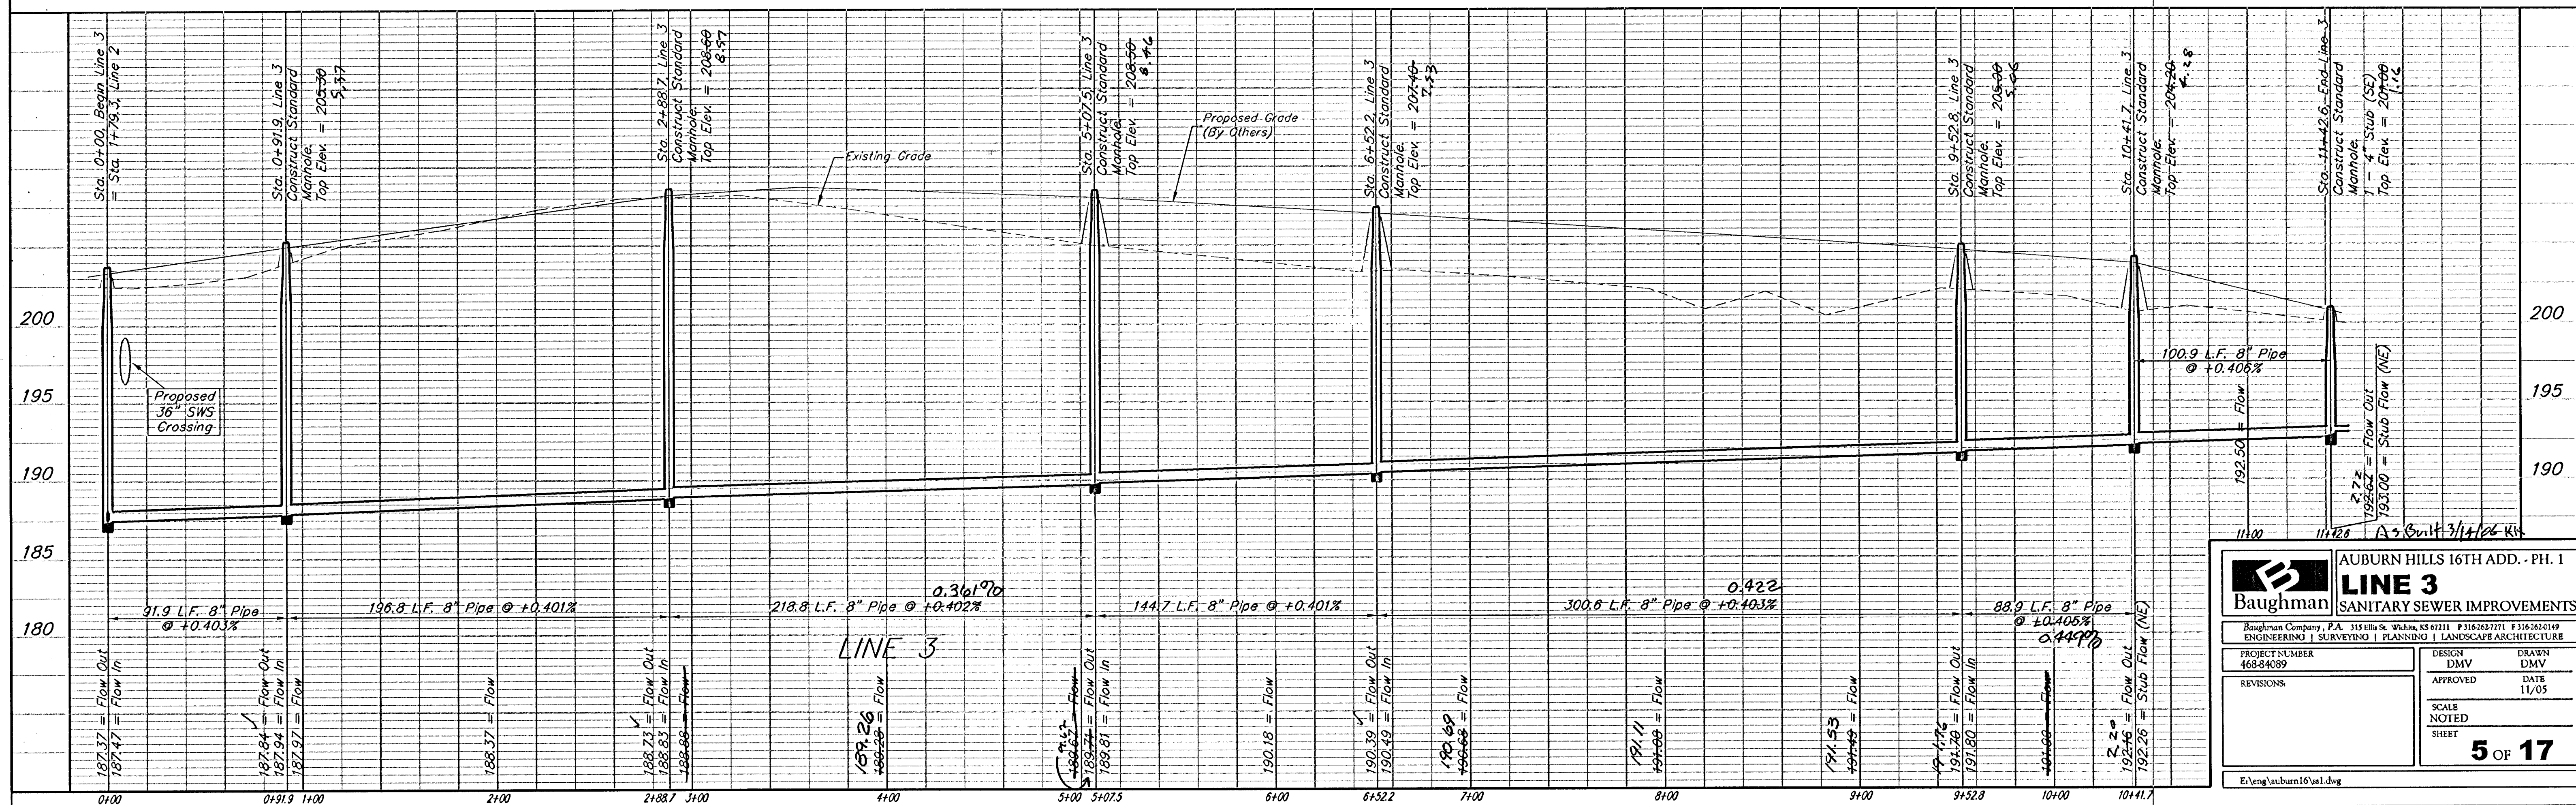

Baughman AUBURN HILLS 16TH ADD. - PH. 1
LINE 3
SANITARY SEWER IMPROVEMENTS

PROJECT NUMBER: 468-84089
DESIGN: DMV
APPROVED: DATE: 11/05
SCALE: NOTED
SHEET: 5 OF 17

REVISIONS:

E:\eng\auburn16\sl.dwg