


AUBURN HILLS 16TH ADDITION

WICHITA, SEDGWICK COUNTY, KANSAS

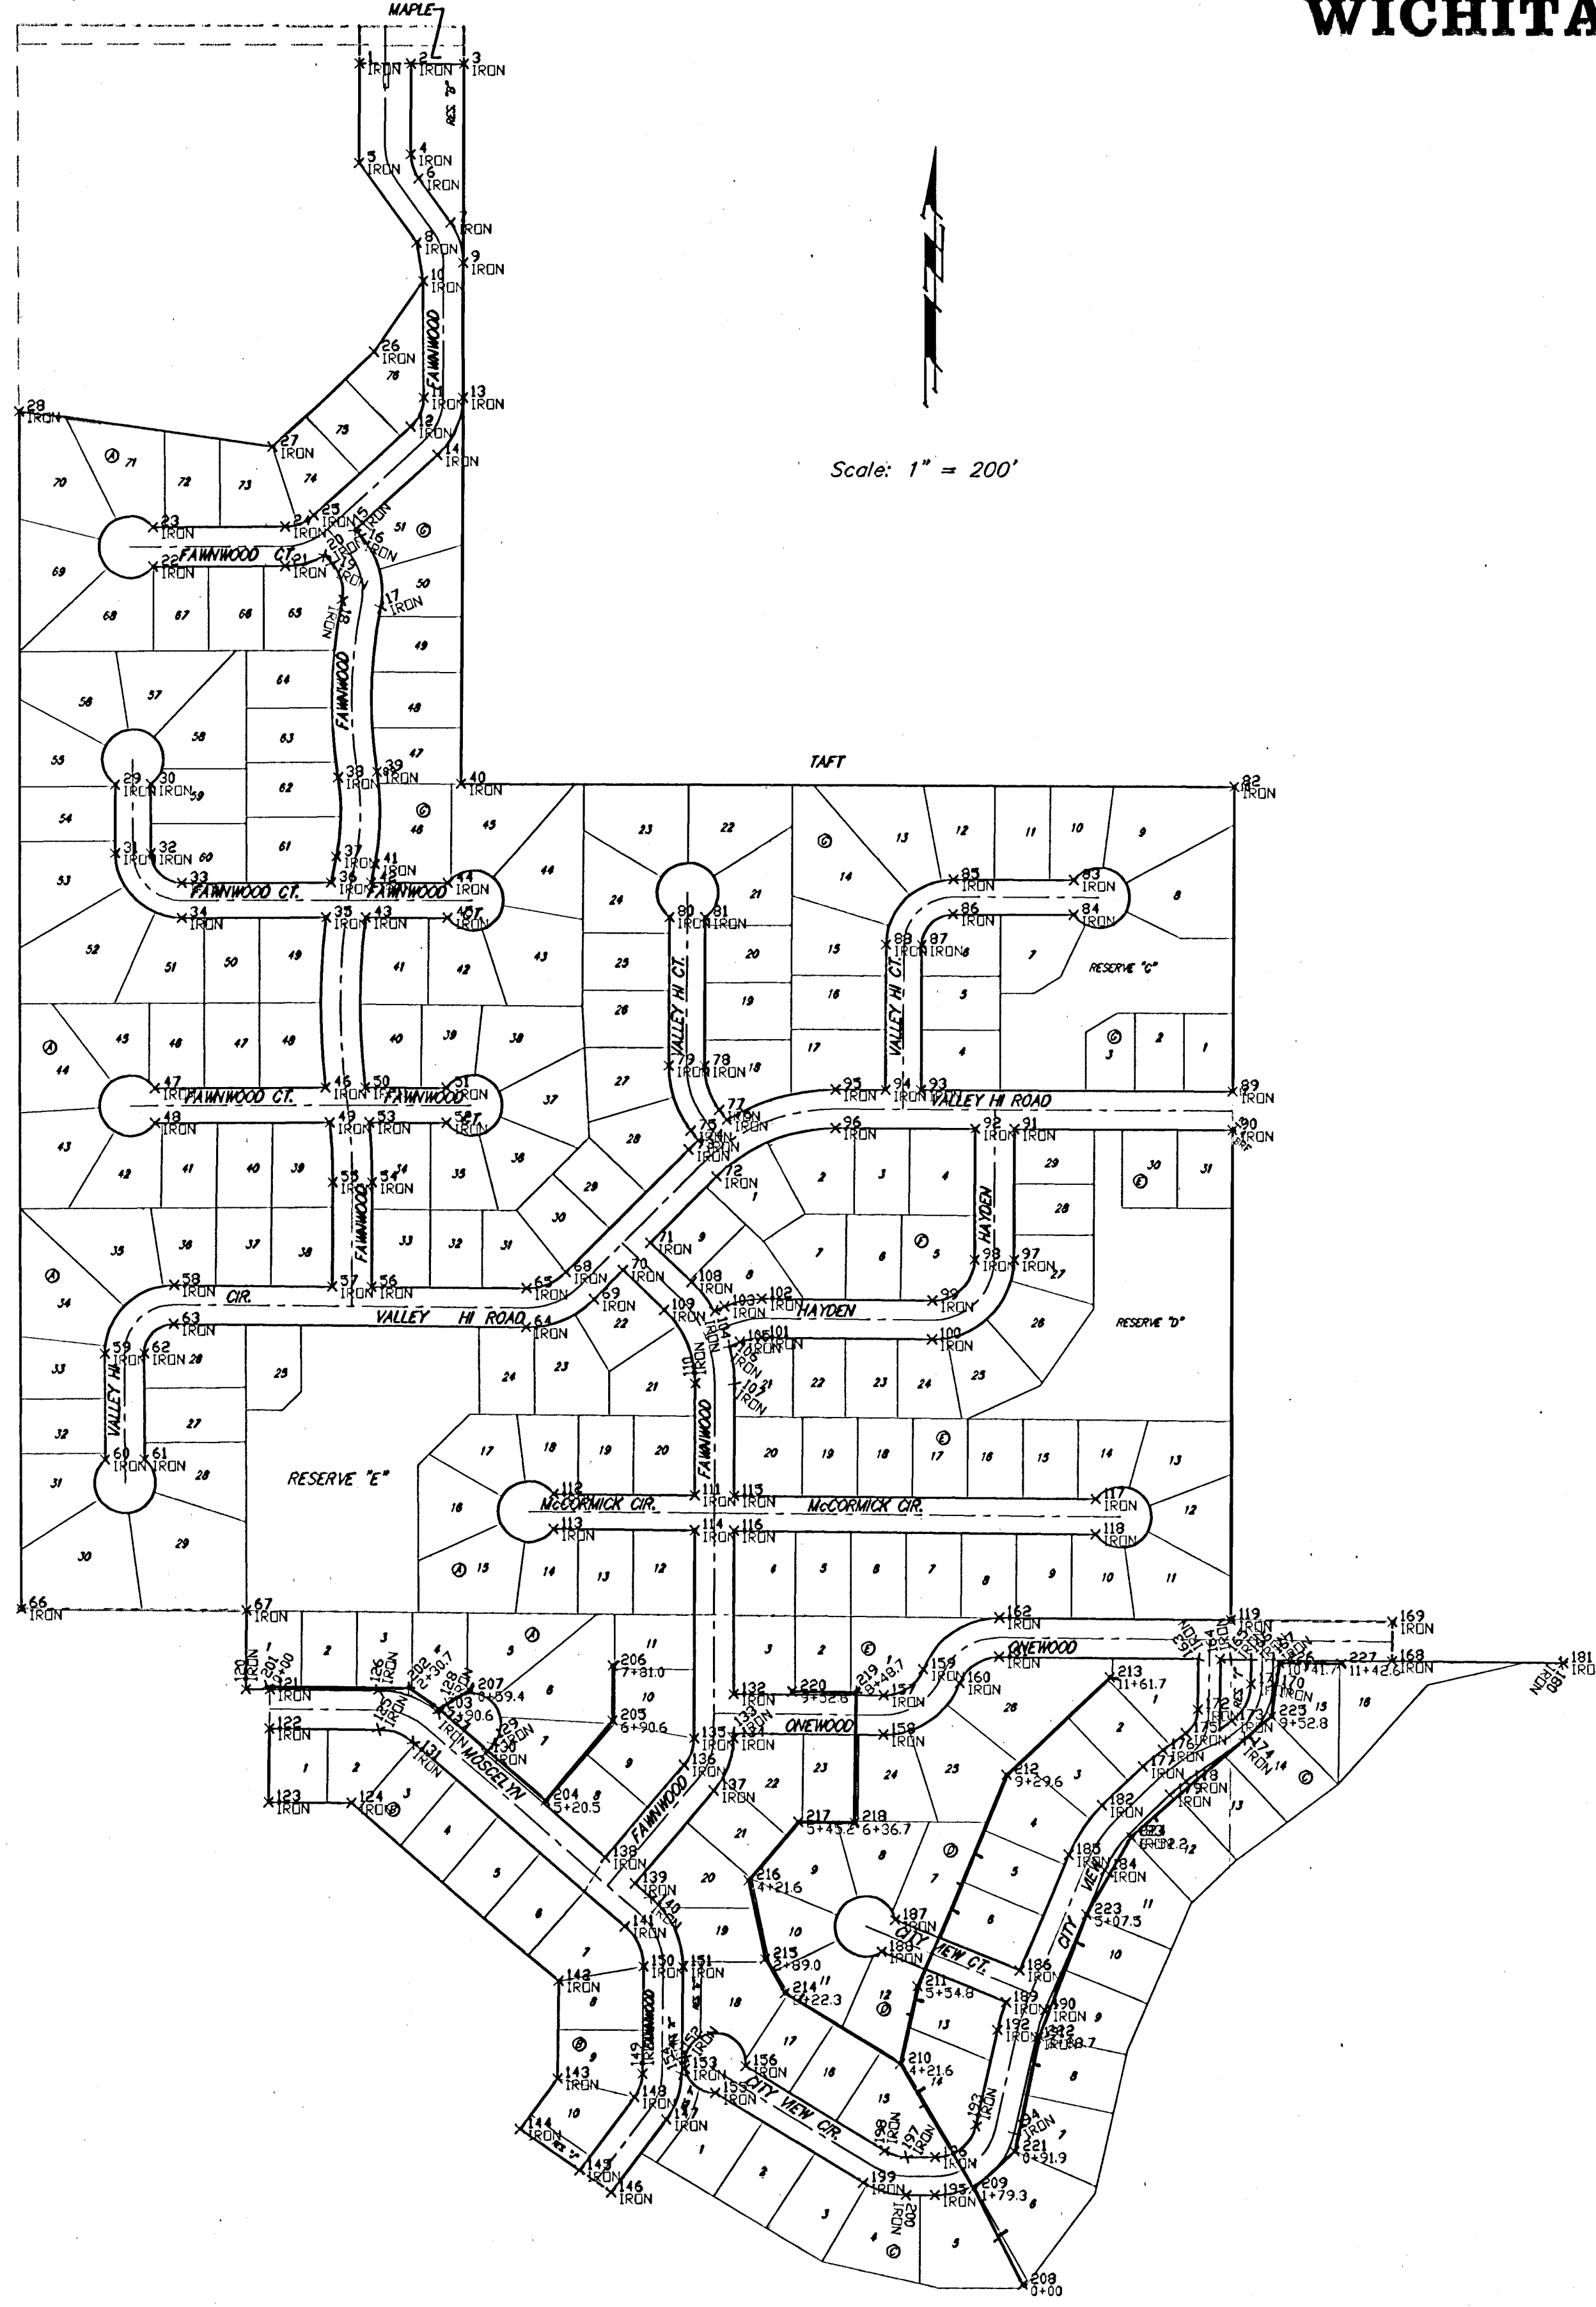

COORDINATE INFORMATION - IRONS			
PT	NORTHING	EASTING	DESC

COORDINATE INFORMATION - IRONS			
PT	NORTHING	EASTING	DESC

COORDINATE INFORMATION - SANITARY SEWER			
PT	NORTHING	EASTING	DESC



Auburn Hills Addition Phase 1
COORDINATE
INFORMATION

Baughman Company, P.A. 315 Ellis St. Wichita, KS 67211 P 316-262-7271 F 316-262-0149

PROJECT NUMBER 102-2022

DESIGN	DRAWN
--------	-------

REVISIONS

APPROVED DATE

SCALE

Noted

16 OF 17

E:\eng\Auburn Hills 16th\SSCoords

05-10-E387