


BENCHMARKS:

BM #1: "□" on west end of median approx. 1020' west of intersection of Hillside and 45th St. N.
Elev. = 1348.19 MSL

BM #2: "□" on hub guard at the SE corner of bridge approx. 2130' west of intersection of Hillside and 45th St. N.
Elev. = 1346.24 MSL


Sta 0+00, Begin Line 1
Remove existing stub from manhole and extend 8" pipe south west. Seal & grout around pipe and reshape invert. Adjust SSMH from 1350.4 to 1348.1.
Cost to be incidental to "8" Pipe."

Remove trees only as necessary for sanitary sewer construction and only with permission of Developer or Baughman Co. Cost of removal to be incidental to lump sum bid item "Site Clearing & Restoration".

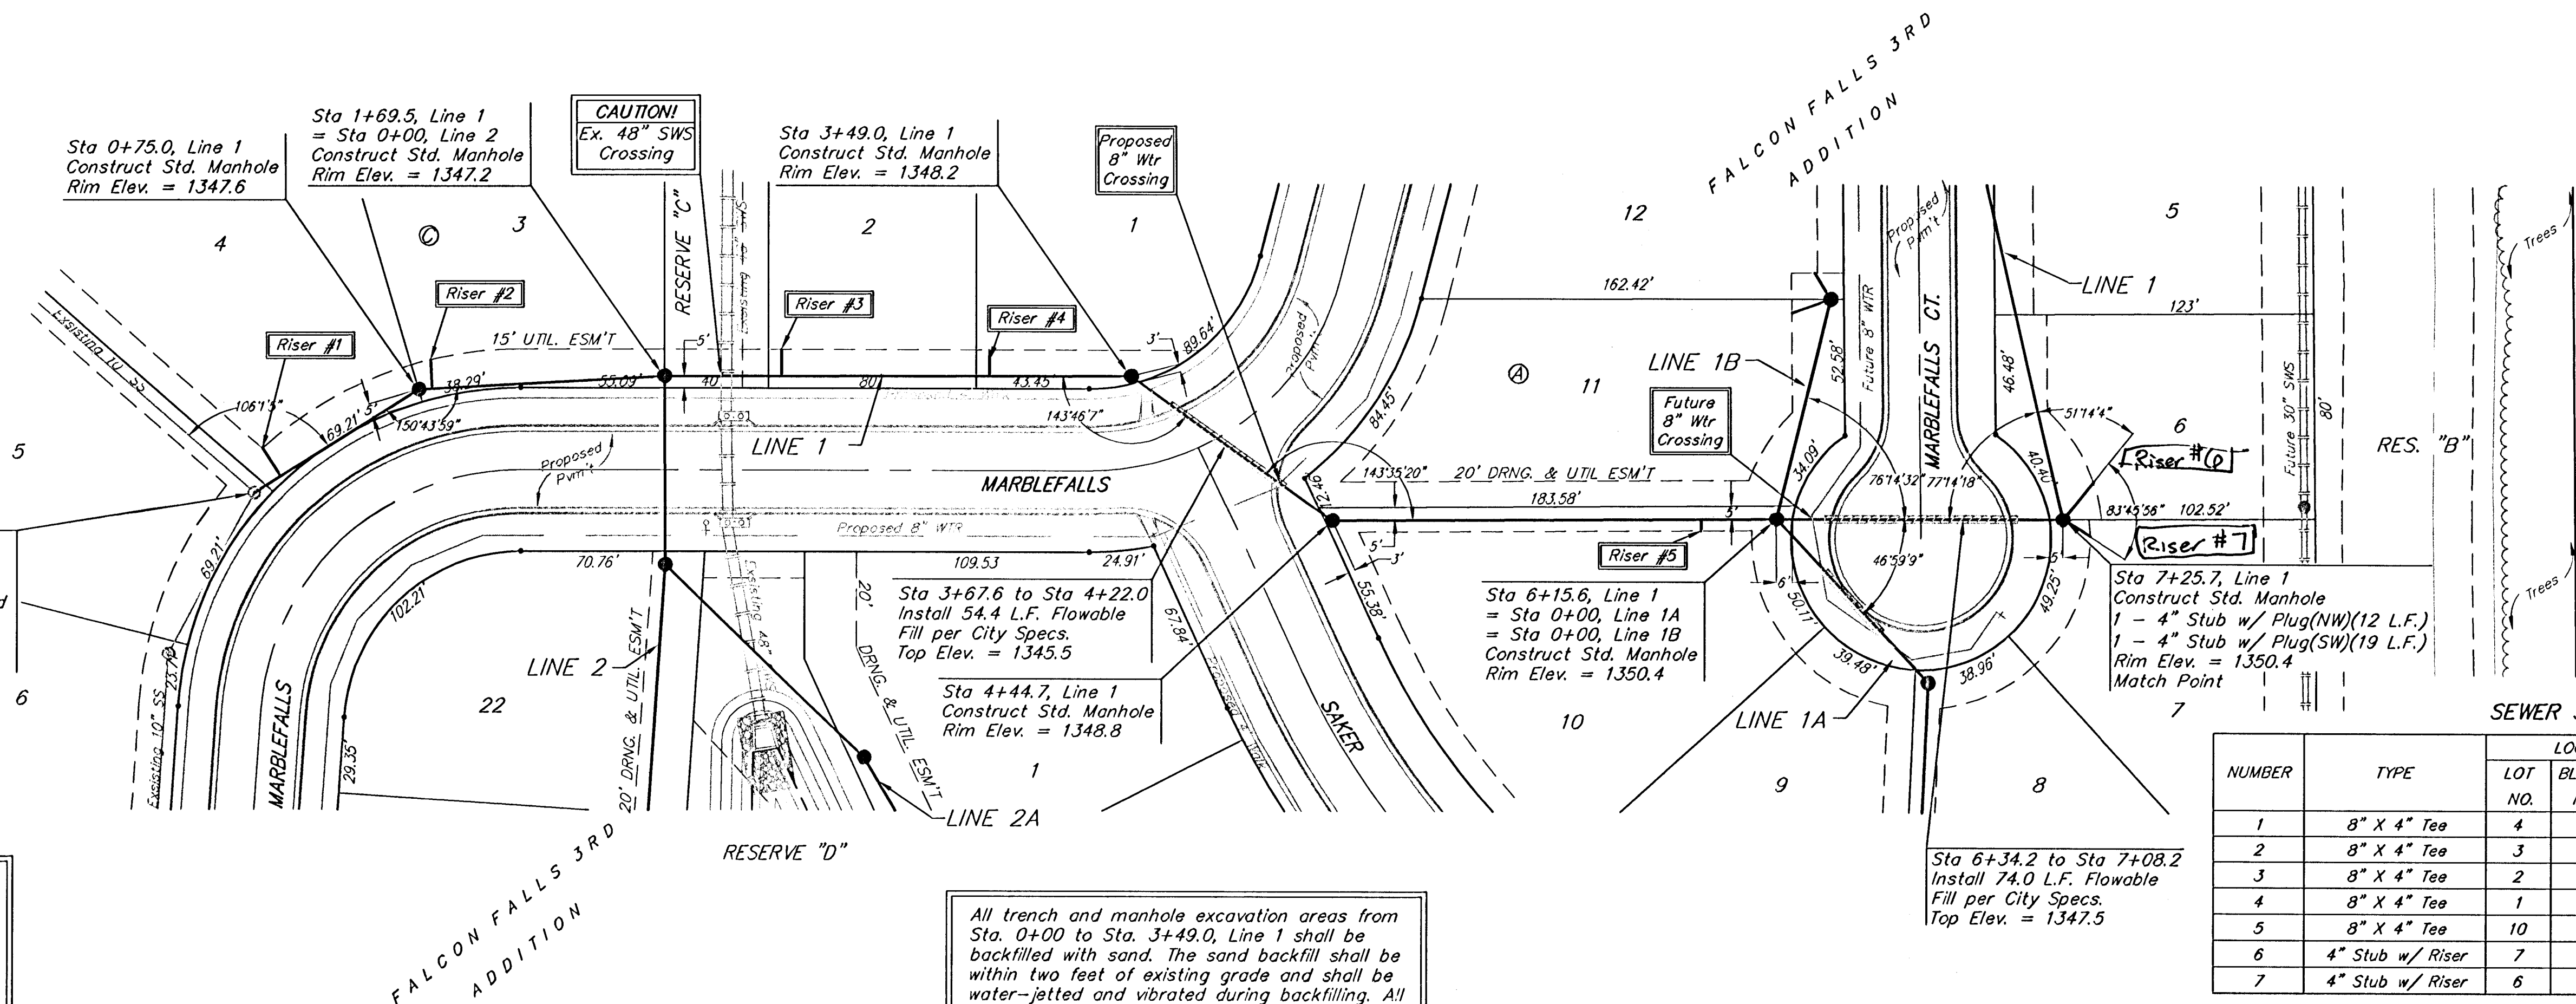

NUMBER	TYPE	LOCATION			STATION\ DIRECTION	FOR INFORMATION ONLY	
		LOT NO.	BLOCK NO.	LINE NO.		APPROXIMATE LENGTH 4" PIPE	
1	8" X 4" Tee	4	C	1	0+12.0/Lt.	16'	13'
2	8" X 4" Tee	3	C	1	0+80.0/Lt.	14'	11'
3	8" X 4" Tee	2	C	1	2+14.5/Lt.	13'	10'
4	8" X 4" Tee	1	C	1	2+94.5/Lt.	12'	10'
5	8" X 4" Tee	10	A	1	5+86.6/Rt.	11'	5'
6	4" Stub w/ Riser	7	A	1	7+25.7/Rt.	12'	12'
7	4" Stub w/ Riser	6	A	1	7+25.7/Rt.	12'	19'

NOTE: Vertical Riser Pipe shall be extended to 2' minimum above ground water elevation and 4' maximum below proposed ground elevation.

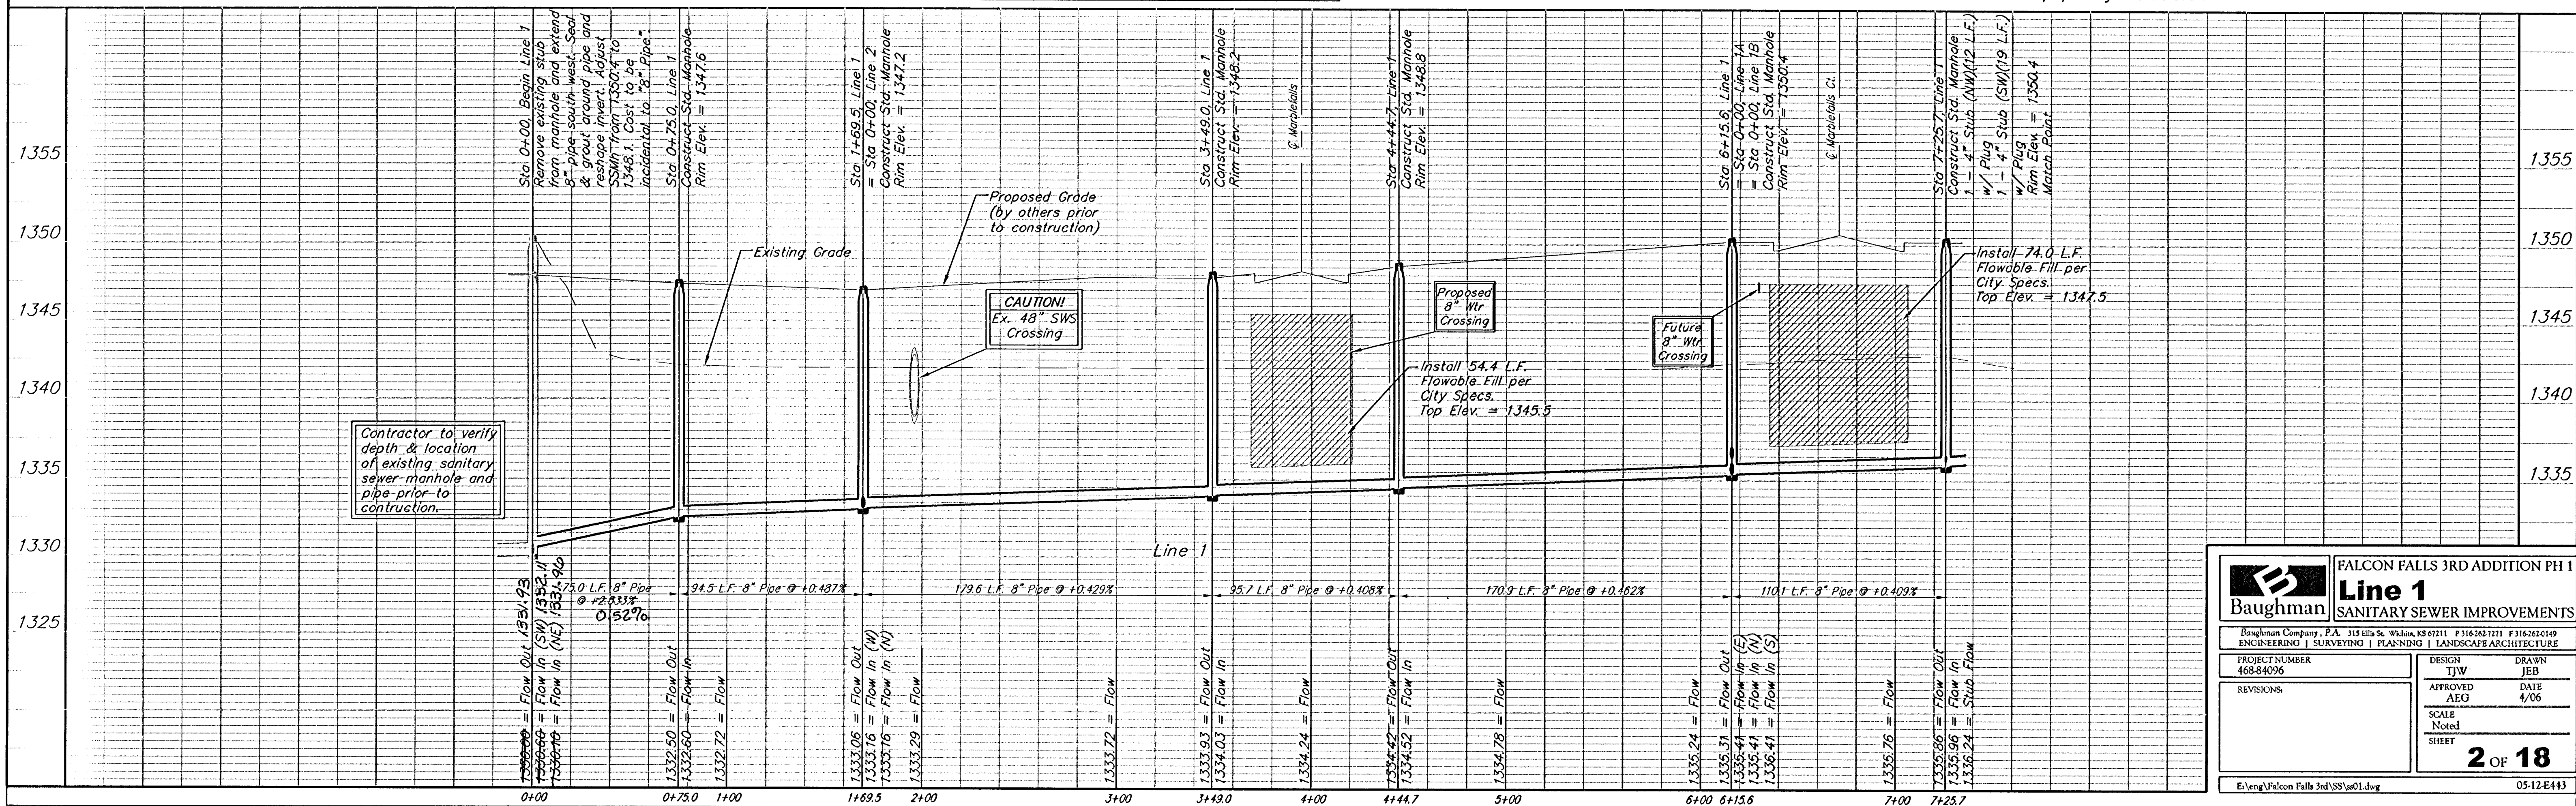



FALCON FALLS 3RD ADDITION PH 1
Line 1
SANITARY SEWER IMPROVEMENTS

Baughman Company, P.A. 315 E. 11th St. Wichita, KS 67211 P 316.262.7271 F 316.262.0149

ENGINEERING | SURVEYING | PLANNING | LANDSCAPE ARCHITECTURE

PROJECT NUMBER
46834096

DESIGN
TJW

APPROVED
AEG

DATE
4/06

REVISIONS

SCALE
Noted

SHEET
2 OF 18

E:\eng\Falcon Falls 3rd\SS\ss01.dwg

05-12-E443