

NORTH RIDGE VILLAGE ADDITION

NE CORNER, SE 1/4, SEC. 28
T26S, R1W, 6TH P.M. =
Q RIDGE RD. STA. 115+32.44
(PROJ. NO. 811-L & S 1/2 K)

Q RIDGE RD. STA.
109+66.65, 28.1' LT.

INSTALL 20 L.F. CONCRETE SLOPE DRAIN
W/ 62.9 S.Y. OF 6"x9" RIPRAP, 12" (MIN.)
DEPTH. STONE FOR RIPRAP SHALL CONFIRM
TO CURRENT KDOT MATERIAL SPECIFICATION

INSTALL STREET NAME SIGN
RIDGE RD 7100 W
VILLAGE CIR 7200-7700

EXIST. DRIVE & CULVERT TO BE
REMOVED BY OTHERS

@ VILLAGE CIRCLE DR., STA. 26+07.85 =
 @ RIDGE RD. STA. 108+65.15
 (PROJ. NO. 811-L & S 1/2 K)

~~INSTALL R4-7 &
OM1-3 SIGNS~~

	INSTALL R1-1 SIGN
--	-------------------

END OF RETURN
 @ RIDGE RD. STA.
 108+14.20, 40.1' LT.


INSTALL 20 L.F. CONCRETE SLOPE DRAIN
W/ 32.3 S.Y. OF 6"x9" RIPRAP, 12" (MIN.)
DEPTH. STONE FOR RIPRAP SHALL CONFIRM
TO CURRENT KDOT MATERIAL SPECIFICATION

Q RIDGE RD. STA.
107+57.65, 25.3' LT.

EXIST. A.C. DRIVE & CULVERT
TO BE REMOVED BY OTHERS

NOTE:

1. TOP OF CURB ELEVATIONS SHOWN ARE FOR FULL OR NON-MOUNTABLE CURB. THE TOP OF CURB ELEVATIONS FOR AREAS TO BE CONSTRUCTED AS ROLL-TYPE CURB ARE SHOWN FOR FULL CURB. CONSTRUCT CURB AS NOTED.
2. ALL DIMENSIONS AND RADII ARE SHOWN TO BACK OF CURB UNLESS OTHERWISE NOTED.
3. PVC SLEEVES CAN BE ADJUSTED IF CONFLICTS WITH OTHER UTILITY LINES. MINIMUM DEPTHS OF COVER SHALL BE 18".
4. CONTRACTOR TO VERIFY LOCATION AND ELEVATION OF EXISTING UTILITIES PRIOR TO CONSTRUCTION.

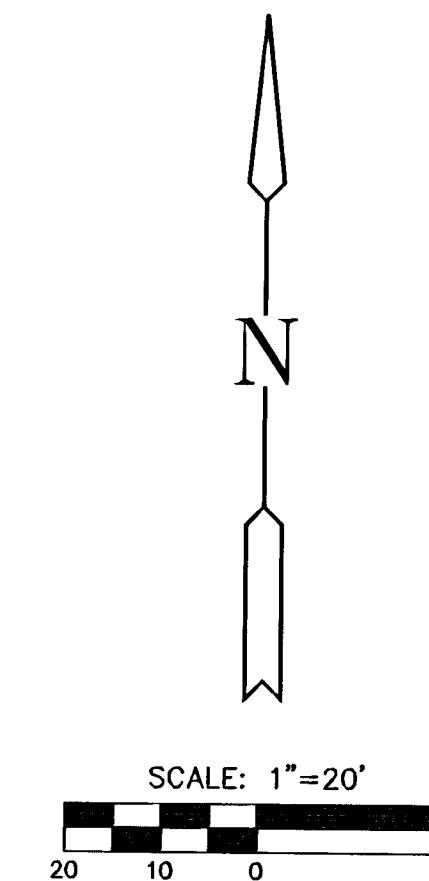

MKEC
ENGINEERING
CONSULTANTS
411 N. WEBB ROAD
WICHITA, KS. 672
316 - 684 - 960

NORTH RIDGE VILLAGE ADDITION
PROJECT NAME

VILLAGE CIRCLE
SHEET TITLE

MAB KWS MAB/DFL
DESIGN BY: DRAWN BY: CHECKED BY:

JANUARY 2006 04394 12 / 34
DATE JOB NO. SHEET/OF