


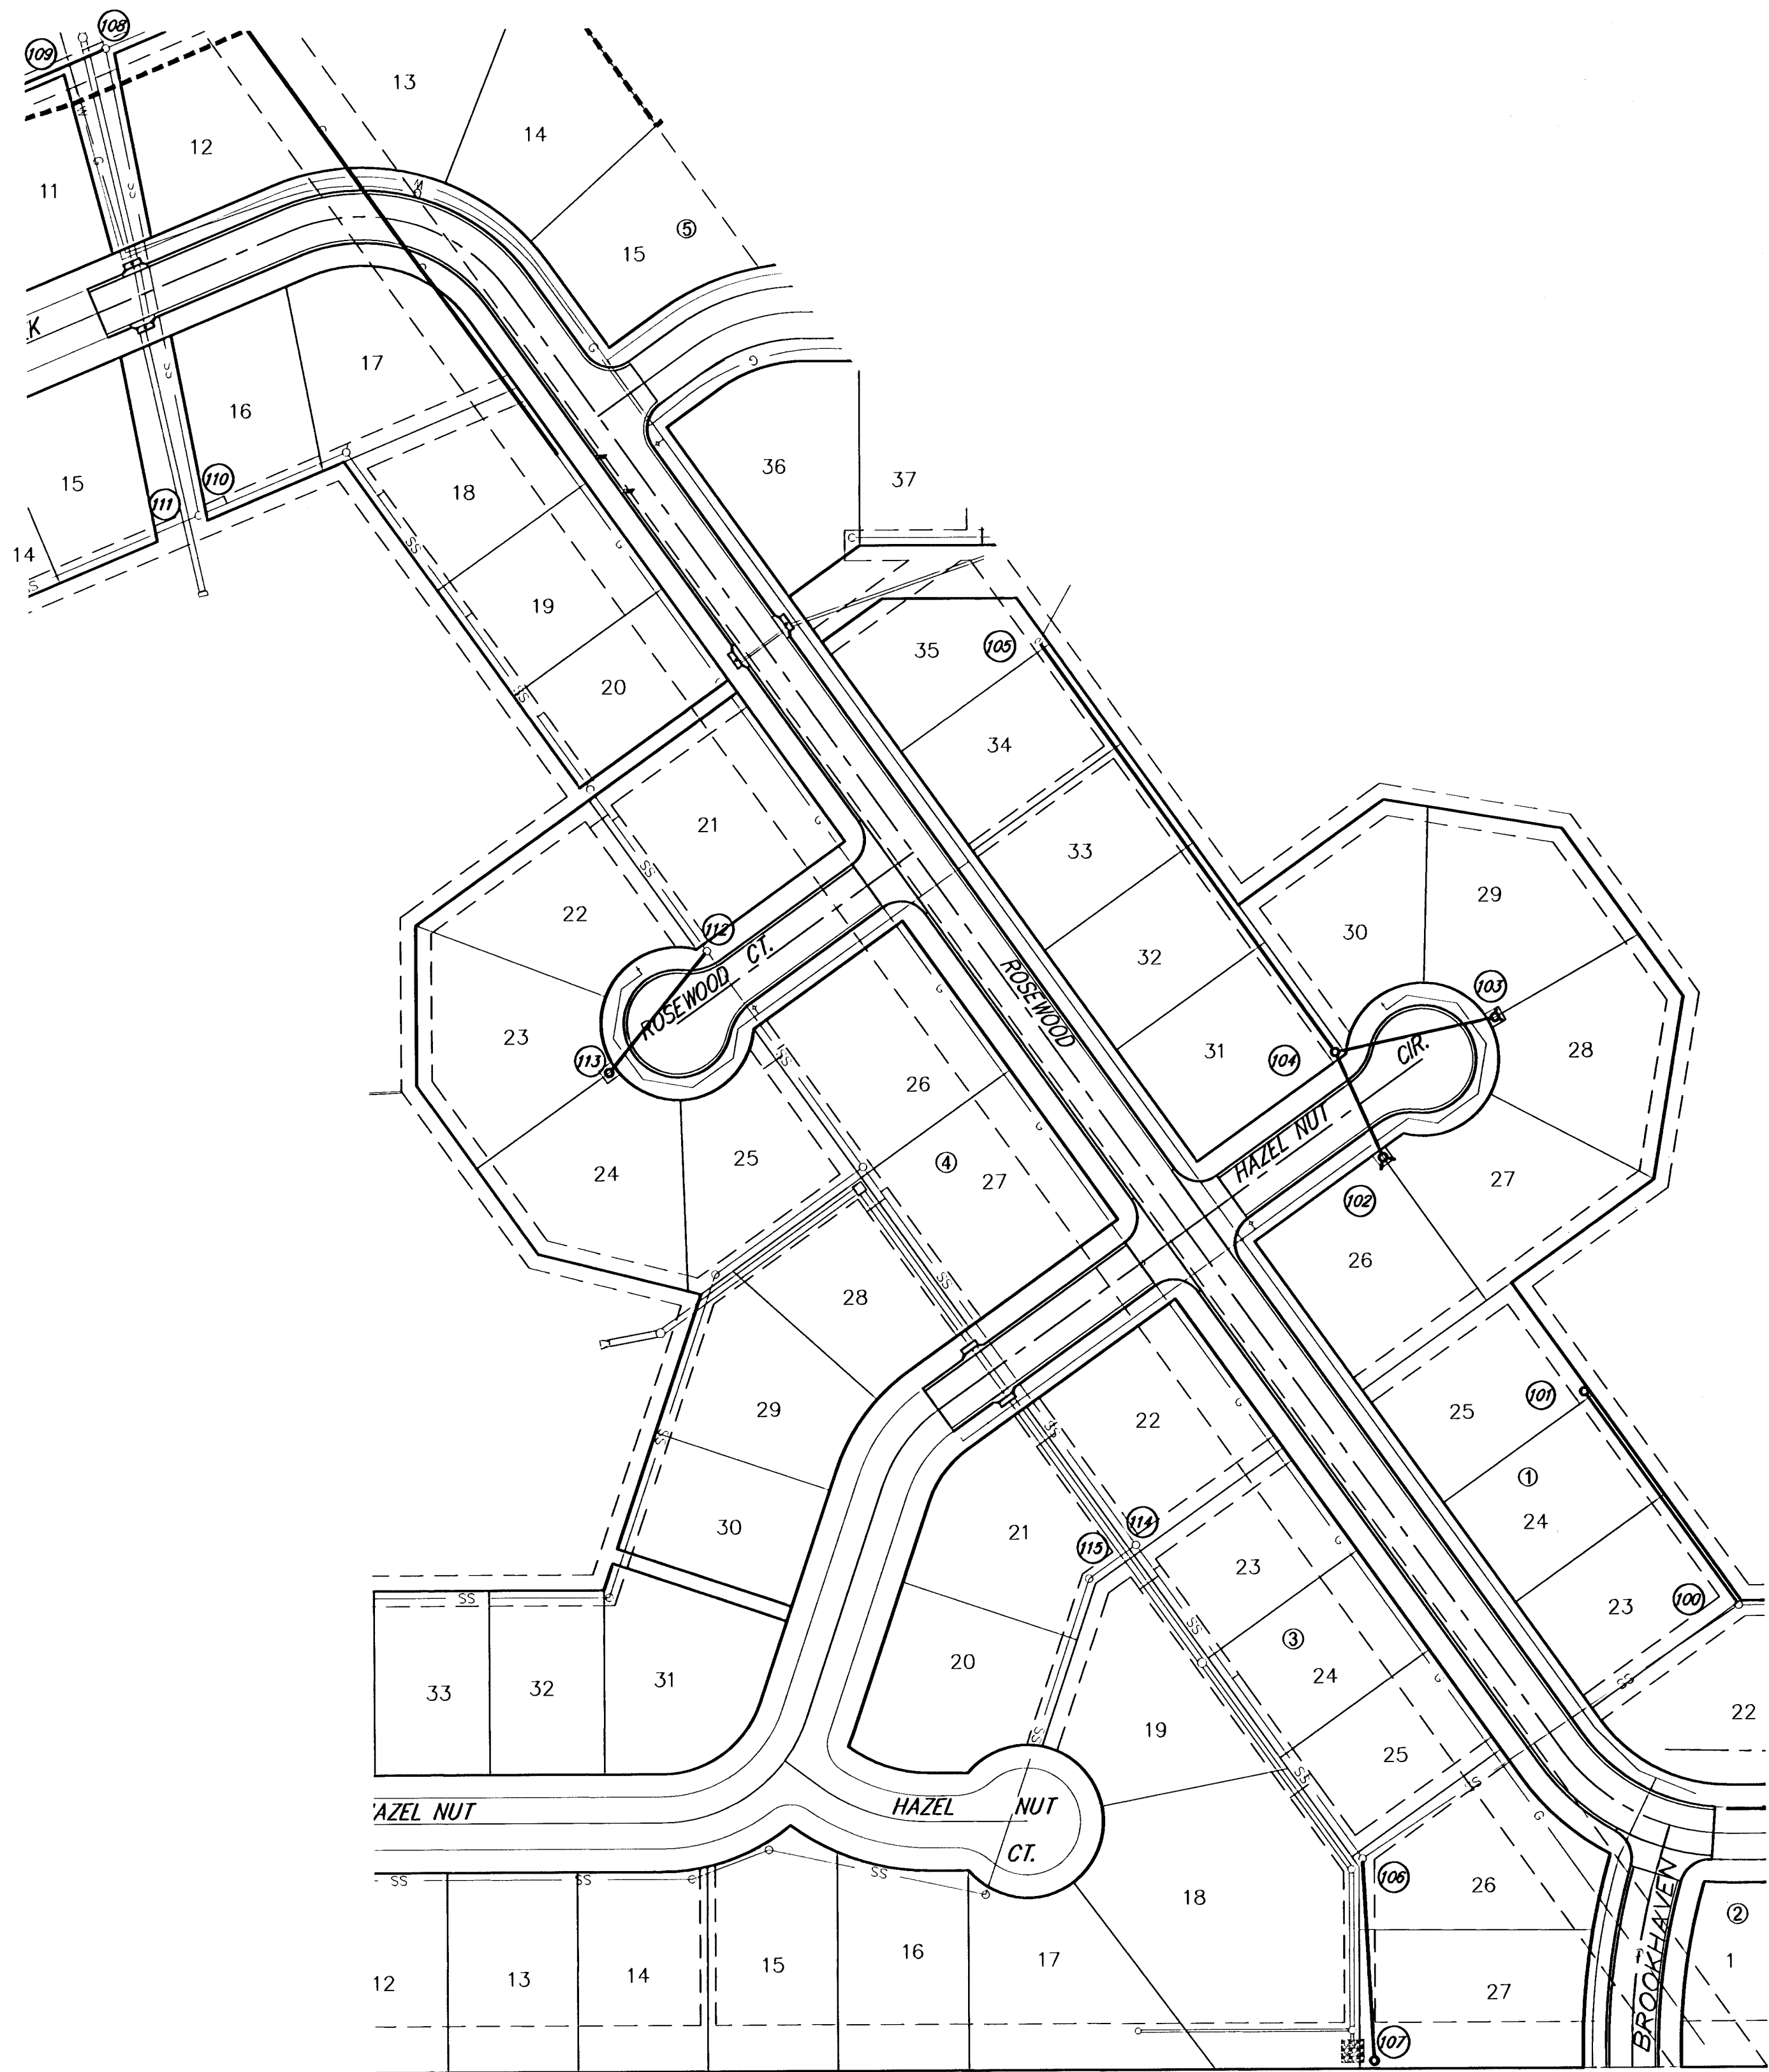


100	N 17646.65	E 18869.45	CENTER OF EXISTING MH
101	N 17786.51	E 18769.61	CENTER OF MH
102	N 17939.76	E 18639.20	CENTER OF MH
103	N 18713.07	E 18030.99	CENTER OF MH
104	N 18008.70	E 18608.41	CENTER OF MH
105	N 18277.28	E 18416.67	CENTER OF EXISTING MH
106	N 17482.62	E 18622.75	CENTER OF EXISTING MH
107	N 17351.00	E 18625.25	CENTER OF MH
108	N 18668.54	E 17809.47	CENTER OF MH
109	N 18656.99	E 17781.78	END OF STUB
110	N 18363.68	E 17868.29	CENTER OF MH
111	N 18355.98	E 17849.83	END OF STUB
112	N 18077.15	E 18198.31	CENTER OF MH
113	N 17998.00	E 18133.89	CENTER OF MH
114	N 17688.12	E 18476.04	CENTER OF MH
115	N 17676.50	E 18459.76	END OF STUB



SCALE 1" = 60'

Whispering Lakes Addition
SS Bubble Map
WICHITA, KANSAS

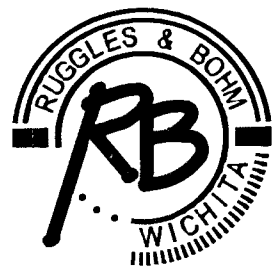

Ruggles & Bohm, P.A.
Engineering, Surveying, Land Planning

924 North Main
Wichita, Kansas 67203
www.rbkansas.com

(316) 264-8008
(316) 264-4621 fax
E-mail: info@rbkansas.com

DESIGN
DRAWN
REVIEW

RLS
RLS
RLS

DRAWING FILE
Details (Sanitary Sewer Bubble)

PROJECT NUMBER
468-84142

DATE
Jan. 11, 2006

RB JOB
2732E

SHEET
12
OF
13