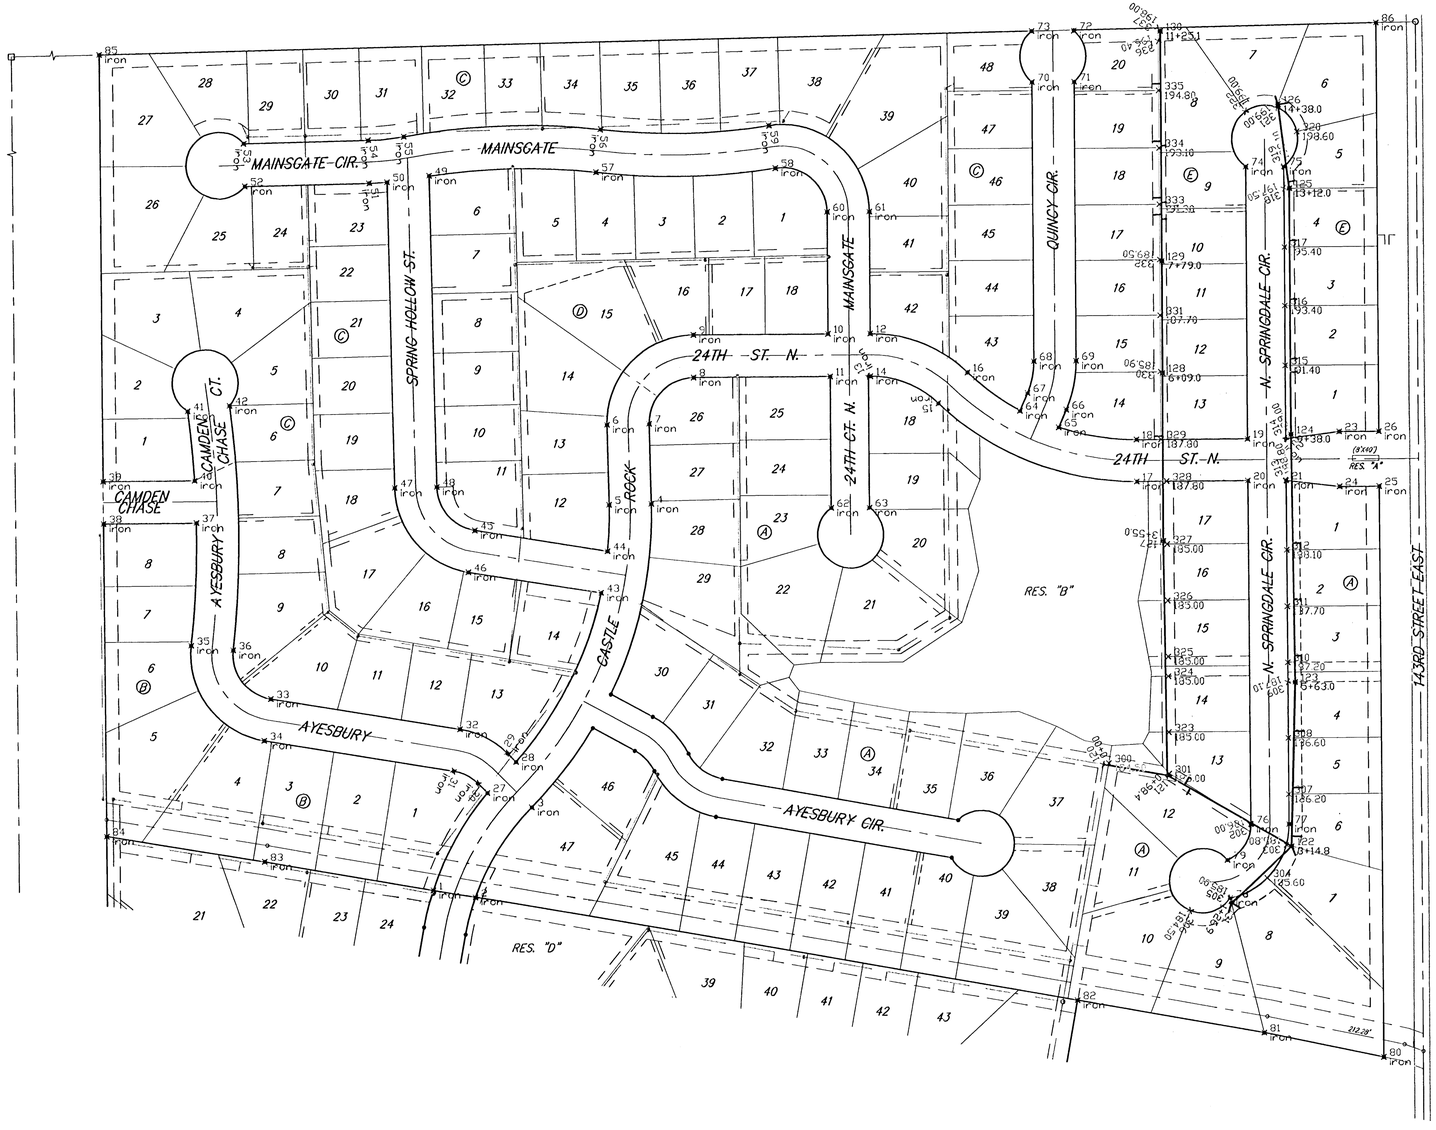


Scale: 1" = 100'

IRONS

PT. #	NORTHING	EASTING	DESC
1	21407.04	11137.48	iron
2	21396.06	11201.28	iron
3	21533.60	11286.73	iron
4	21992.73	11468.21	iron
5	21991.14	11404.23	iron
6	22113.25	11401.20	iron
7	22114.84	11465.18	iron
8	22184.52	11532.67	iron
9	22248.52	11532.22	iron
10	22249.98	11736.34	iron
11	22186.00	11739.80	iron
12	22250.44	11800.34	iron
13	22186.42	11797.80	iron
14	22186.44	11800.80	iron
15	22145.68	11903.86	iron
16	22192.05	11947.97	iron
17	22036.71	12204.68	iron
18	22090.71	12204.22	iron
19	22091.91	12372.49	iron
20	22027.91	12372.95	iron
21	22028.33	12430.95	iron
22	22092.33	12430.49	iron
23	22102.91	12511.41	iron
24	22018.91	12512.01	iron
25	22019.34	12572.01	iron
26	22103.34	12571.41	iron
27	21554.87	11219.52	iron
28	21601.94	11262.93	iron
29	21614.73	11249.94	iron
30	21569.13	11205.04	iron
31	21597.84	11167.98	iron
32	21651.05	11178.02	iron
33	21696.57	10891.22	iron
34	21633.36	10881.19	iron
35	21777.92	10770.65	iron
36	21771.04	10834.28	iron
37	21964.05	10778.89	iron
38	21962.76	10638.05	iron
39	22026.76	10637.47	iron
40	22028.03	10776.26	iron
41	22133.45	10765.80	iron
42	22142.06	10829.22	iron
43	21858.30	11391.86	iron
44	21921.54	11401.69	iron
45	21982.74	11201.01	iron
46	21889.50	11191.18	iron
47	22016.65	11079.50	iron
48	22018.24	11143.48	iron
49	22491.31	11131.73	iron
50	22481.76	11367.95	iron
51	22480.20	11040.85	iron
52	22475.52	10852.30	iron
53	22539.50	10850.71	iron
54	22544.18	11039.26	iron
55	22549.74	11093.31	iron
56	22560.32	11391.28	iron
57	22496.70	11384.28	iron
58	22502.91	11656.51	iron
59	22566.14	11646.62	iron
60	22436.22	11735.01	iron
61	22436.67	11799.01	iron
62	21986.74	11741.23	iron
63	21987.15	11799.22	iron
64	22134.47	12027.53	iron
65	22109.21	12086.34	iron
66	22136.10	12097.88	iron
67	22161.35	12039.07	iron
68	22208.76	12048.65	iron
69	22209.21	12112.64	iron
70	22630.36	12045.63	iron
71	22630.82	12109.63	iron
72	22707.66	12109.08	iron
73	22707.20	12045.08	iron
74	22504.98	12369.54	iron
75	22505.39	12427.53	iron
76	21508.34	12376.66	iron
77	21508.75	12434.66	iron
78	21394.66	12345.34	iron
79	21454.17	12341.29	iron
80	21153.51	12578.20	iron
81	21190.40	12397.10	iron
82	21239.09	12114.01	iron
83	21451.01	10881.81	iron
84	21489.17	10642.38	iron
85	22672.10	10631.57	iron
86	22720.16	12567.00	iron

SANITARY SEWER

PT. #	NORTHING	EASTING	DESC
120	21598.72	12153.16	0+00
121	21582.02	12250.13	0+98.4
122	21475.25	12438.30	3+14.8
123	21723.42	12444.13	5+63.0
124	22098.41	12438.45	9+38.0
125	22472.37	12435.77	13+12.0
126	22597.13	12418.31	14+38.0
127	21936.99	12244.59	3+55.0
128	22190.99	12243.78	6+09.0
129	22360.99	12242.56	7+79.0
130	22707.04	12240.09	11+25.1
131	21386.87	12347.31	1+26.9

SANITARY SEWER ESMTS

PT. #	NORTHING	EASTING	ELEV
300	21600.3211	12161.5579	184.50
301	21584.5523	12253.1148	185.00
302	21508.3397	12376.6629	186.00
303	21477.3454	12430.5814	185.80
304	21426.6102	12401.6114	185.60
305	21394.6208	12345.3424	185.00
306	21375.0364	12285.2622	184.50
307	21553.3410	12434.3426	186.20
308	21638.3388	12433.7348	186.60
309	21723.3366	12433.1270	187.10
310	21753.3359	12432.9125	187.20
311	21838.3337	12432.3047	187.70
312	21923.3315	12431.6969	188.10
313	22028.3288	12430.9460	188.80
314	22092.3272	12430.4884	189.00
315	22202.3244	12429.7018	191.40
316	22232.3221	12429.0583	193.40
317	22382.3198	12428.4134	195.40
318	22472.3175	12427.7712	197.50
319	22505.3944	12427.5346	198.10
320	22557.0599	12446.9866	198.60
321	22592.4697	12416.4875	199.00
322	22586.6742	12369.2815	199.00
323	21647.0443	12252.6679	185.00
324	21732.0421	12252.0601	185.00
325	21762.0413	12251.8456	185.00
326	21847.0392	12251.2378	185.00
327	21932.0370	12250.6300	185.00
328	22027.0346	12249.9507	187.80
329	22090.9757	12241.4932	187.80
330	22192.7584	12240.7654	185.90
331	22277.7562	12240.1576	187.70
332	22362.7540	12239.5498	189.50
333	22447.7518	12238.9420	191.30
334	22532.7497	12238.3342	193.10
335	22617.7475	12237.7264	194.80
336	22691.9636	12237.1957	196.40
337	22711.9662	12237.0526	198.00

Baughman

KRUG NORTH 2ND ADD. - PH. IV

COORDINATE SHEET

SANITARY SEWER IMPROVEMENTS

Baughman Company, P.A. 315 Ellis St. Wichita, KS 67211 P 316.262.2771 F 316.262.0149
ENGINEERING | SURVEYING | PLANNING | LANDSCAPE ARCHITECTURE

PROJECT NUMBER 46884055

REVISIONS

DESIGN ATD | DRAWN TMS

APPROVED | DATE 03/06

SCALE Noted

SHEET **9** OF **15**

KrugNorth2nd\PhaseIV\SSCoords | 05-12-E147