


BM #1: "□" Cut on Top of Curb
at West Line of Lot 7, Block A,
Auburn Hills 5th Addition.
Elev. = 207.73 (City Datum)

BM #2: Disc in Back of Curb,
North of Front Corner Common
to Lots 23 and 24, Block D,
Auburn Hills 12th Addition.
Elev. = 191.84 (City Datum)

BM #3: "□" Cut in Middle of Curb
Inlet Top Adjacent to the South
Corner of Lot 15, Block B.
Elev. = 193.65 (City Datum)

Contractor to Verify Depth & Location of Existing 8" Sewer Line Prior to Construction.


Remove trees only as necessary for sanitary sewer construction and only with permission of Developer or Baughman Co. Cost of removal to be incidental to lump sum bid item "Site Clearing & Restoration".

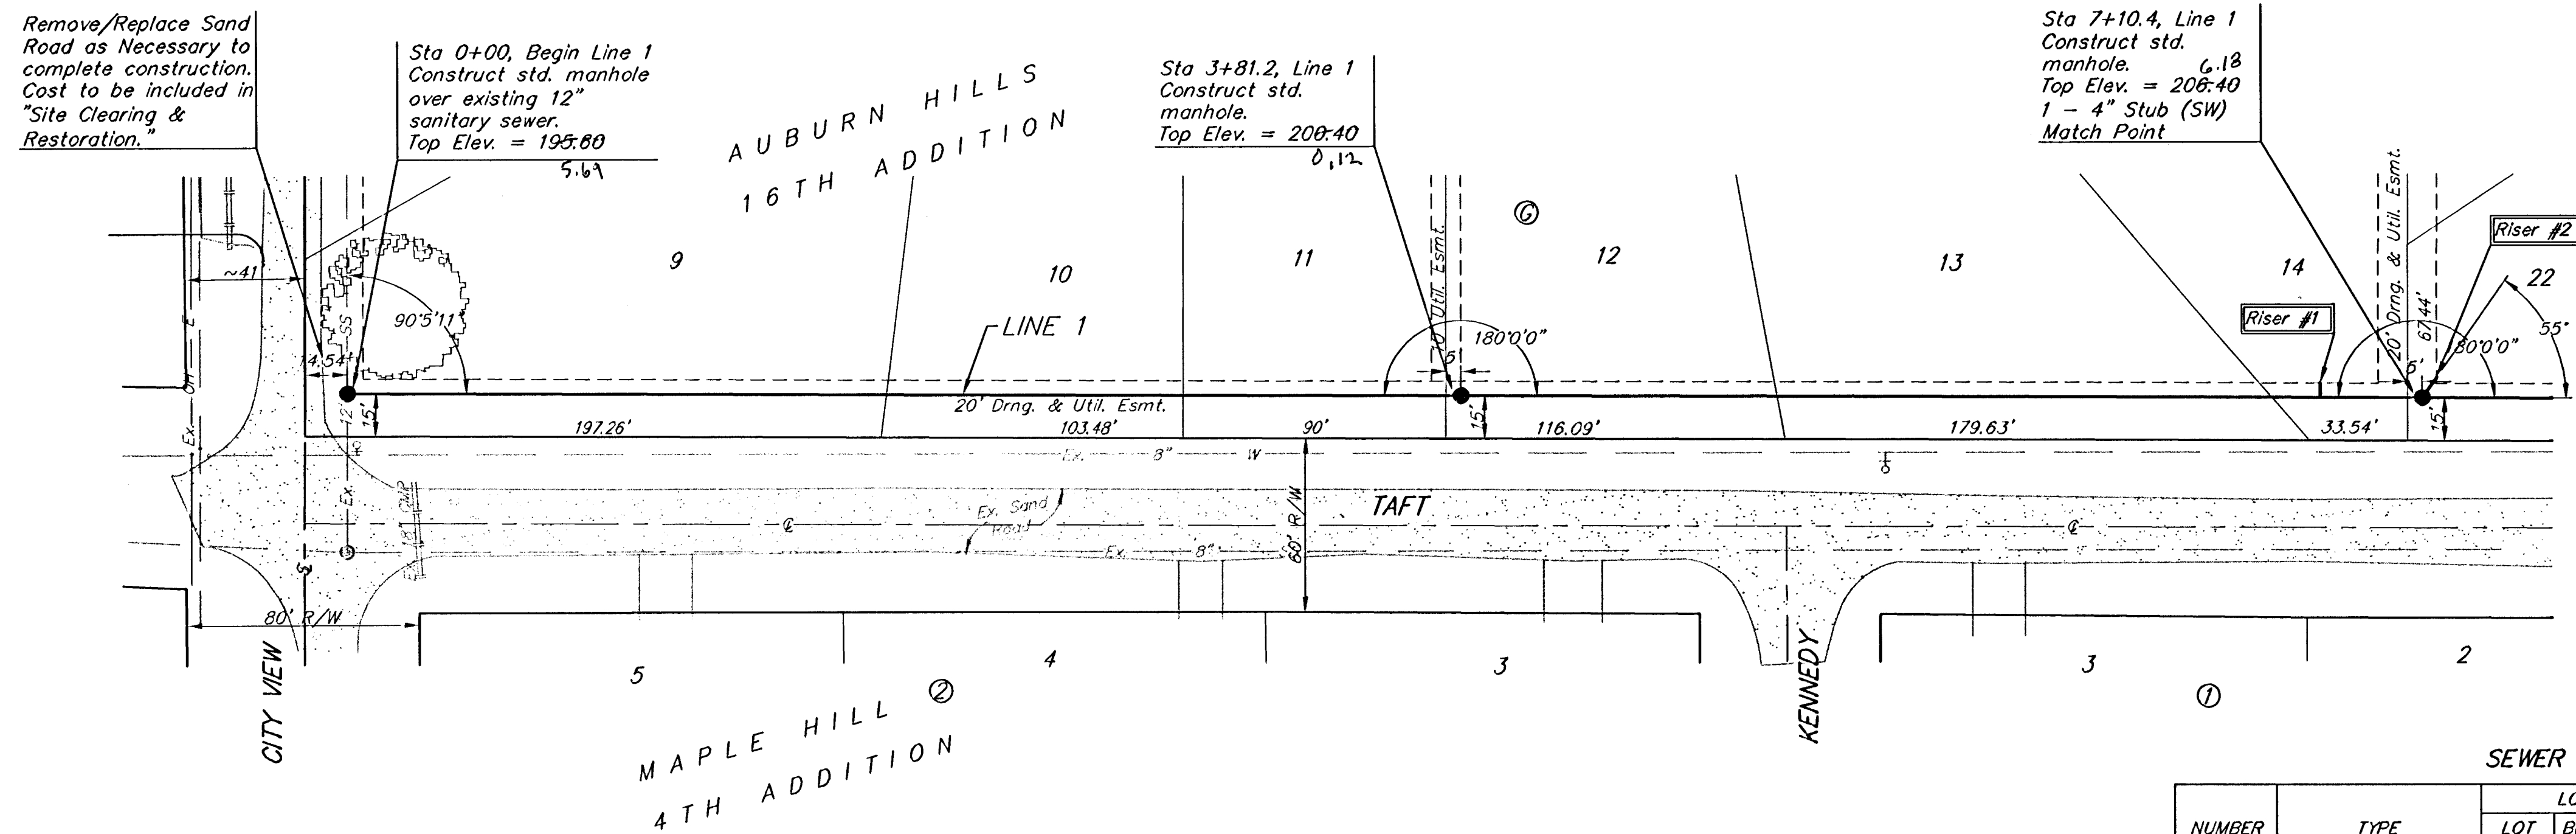

Scale: 1" = 40' Horizontal
1" = 5' Vertical
• = Iron

NUMBER	TYPE	LOCATION			STATION \ DIRECTION	FOR INFORMATION ONLY	
		LOT NO.	BLOCK NO.	LINE NO.		APPROXIMATE LENGTH 4" PIPE VERTICAL	HORIZONTAL
1 ✓	8" X 4" Tee	14	G	1	6+74/Lt.	9.5'	5'
2 ✓	4" Stub	22	G	1	7+10.4/Lt.	10.0'	5'

NOTE: Vertical Riser Pipe shall be extended to 2' minimum above ground water elevation and 4' maximum below proposed ground elevation.

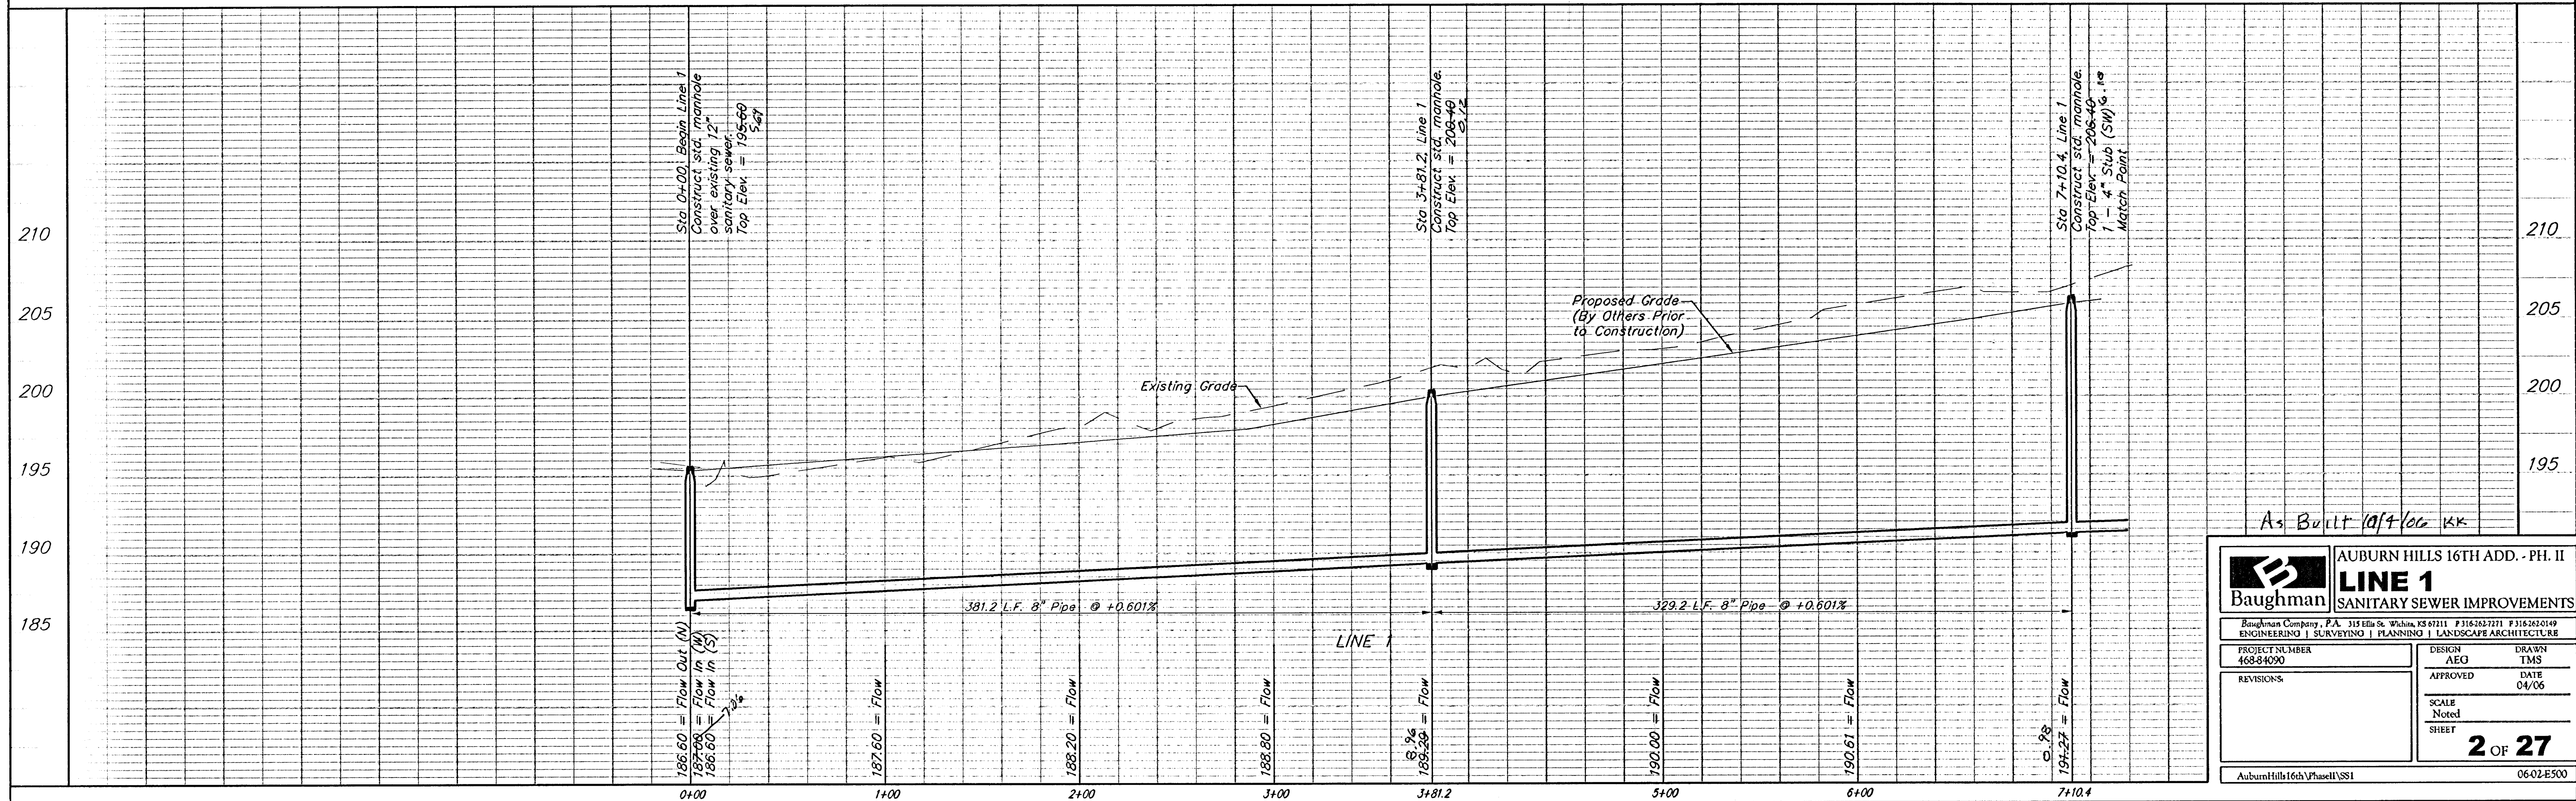

 Baughman	AUBURN HILLS 16TH ADD. - PH. II LINE 1 SANITARY SEWER IMPROVEMENTS										
PROJECT NUMBER 469-84000 REVISIONS:	<table border="1" style="width: 100%; border-collapse: collapse;"> <tr> <td style="width: 50%;">DESIGN AEG</td> <td style="width: 50%;">DRAWN TMS</td> </tr> <tr> <td>APPROVED</td> <td>DATE 04/06</td> </tr> <tr> <td colspan="2">SCALE Noted</td> </tr> <tr> <td colspan="2">SHEET</td> </tr> <tr> <td colspan="2" style="text-align: center;"> 2 OF 27 </td> </tr> </table>	DESIGN AEG	DRAWN TMS	APPROVED	DATE 04/06	SCALE Noted		SHEET		2 OF 27	
DESIGN AEG	DRAWN TMS										
APPROVED	DATE 04/06										
SCALE Noted											
SHEET											
2 OF 27											
Auburn Hills 16th Phase II SS1											
06-02-E500											