

BENCHMARKS:


BM #1: "C" Cut on Top of Curb
at West Line of Lot 7, Block A,
Auburn Hills 5th Addition.
Elev. = 207.73 (City Datum)

BM #2: Disc in Back of Curb,
North of Front Corner Common
to Lots 23 and 24, Block D,
Auburn Hills 12th Addition.
Elev. = 191.84 (City Datum)

BM #3: "C" Cut in Middle of Curb
Inlet Top Adjacent to the South
Corner of Lot 15, Block B.
Elev. = 193.65 (City Datum)

Remove trees only as necessary
for sanitary sewer construction
and only with permission of
Developer or Baughman Co.
Cost of removal to be incidental
to lump sum bid item "Site
Clearing & Restoration".


Scale: 1" = 40' Horizontal
1" = 5' Vertical
• = Iron

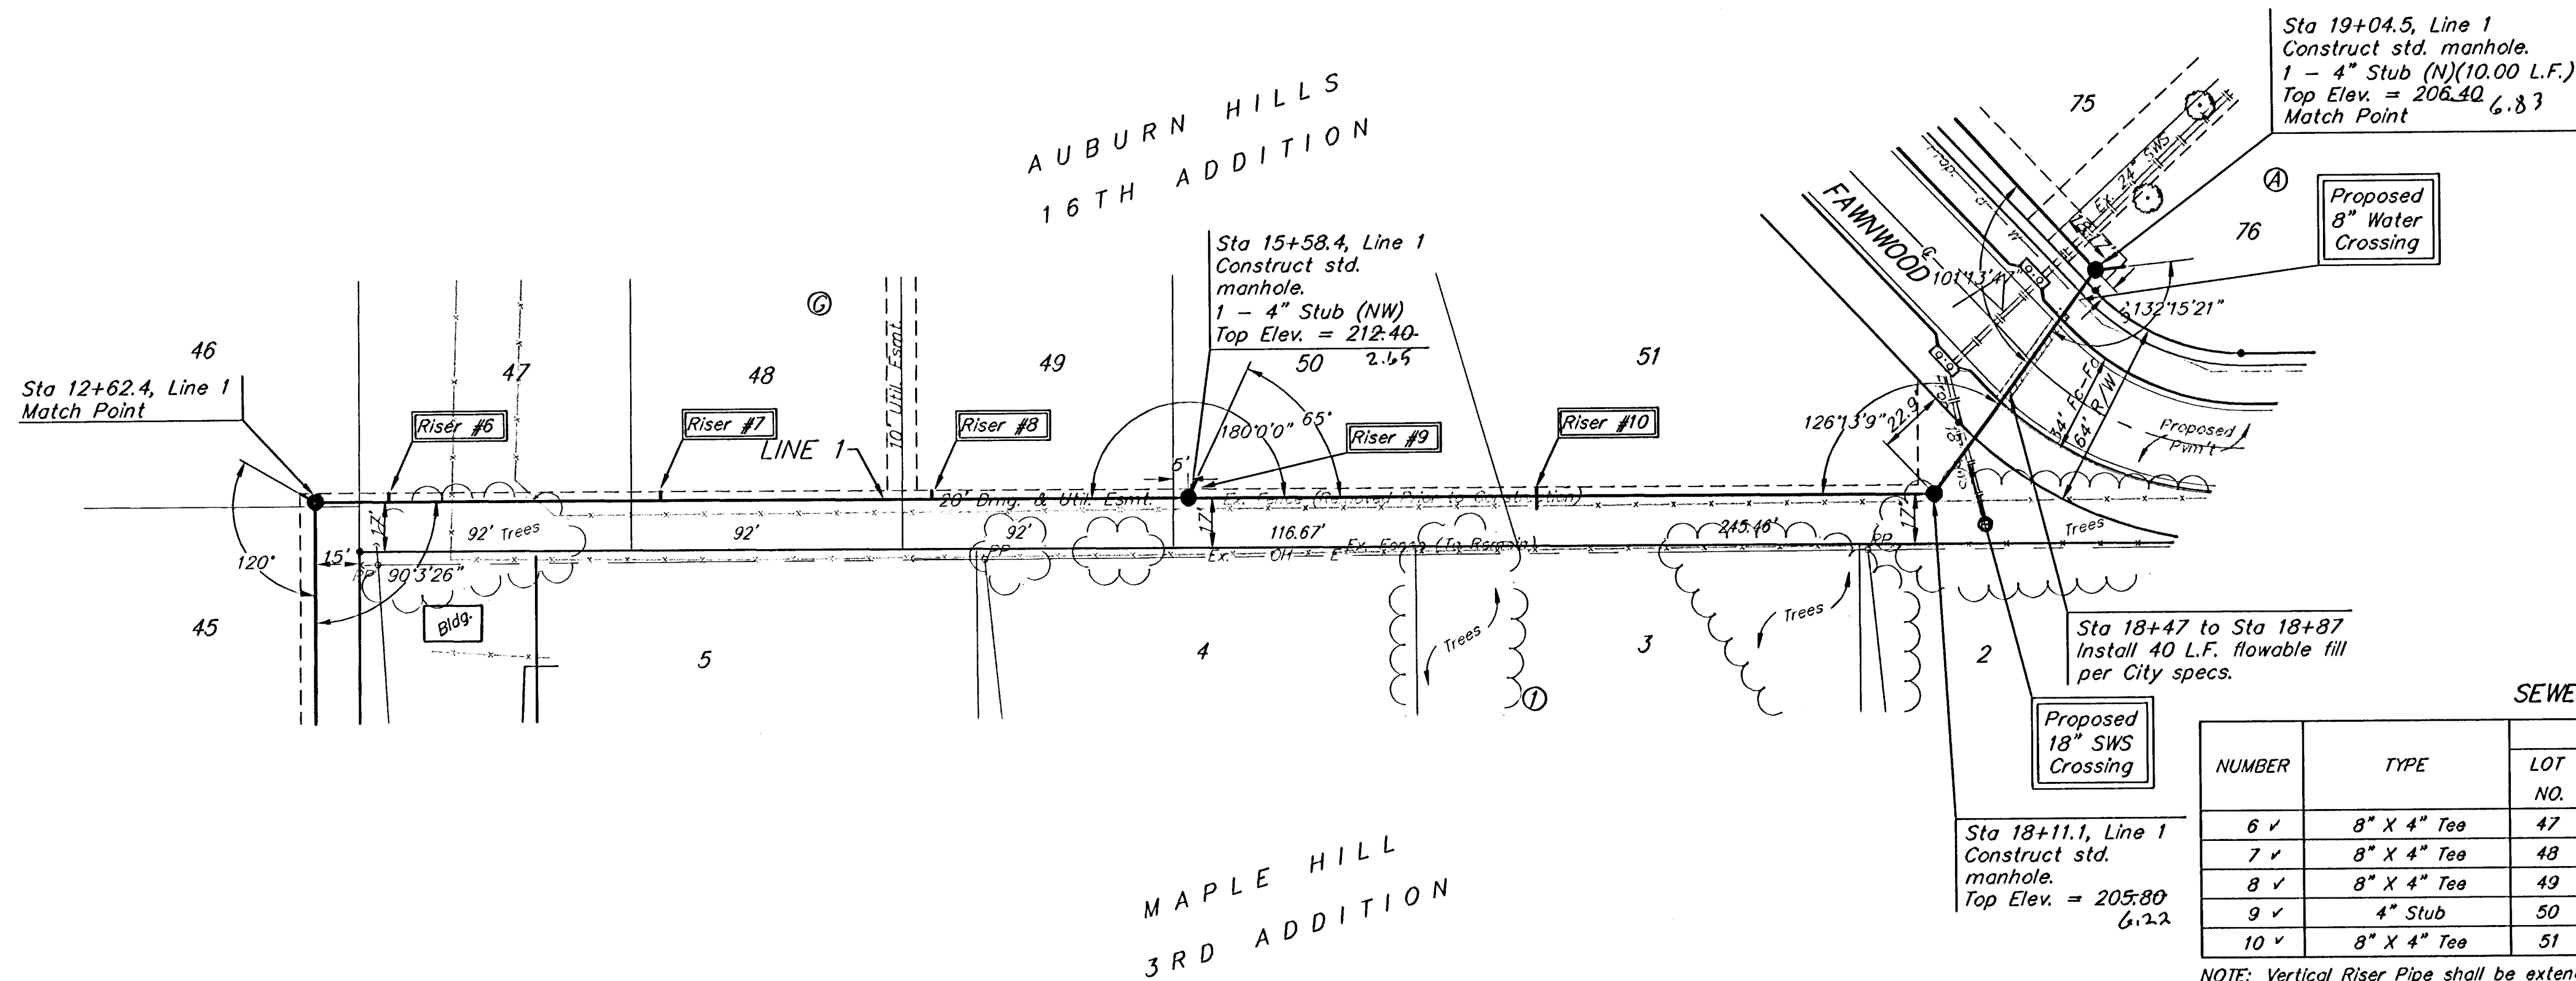

SEWER SERVICE TABLE

NUMBER	TYPE	LOCATION			STATION DIRECTION	FOR INFORMATION ONLY APPROXIMATE LENGTH 4" PIPE	
		LOT NO.	BLOCK NO.	LINE NO.		VERTICAL	HORIZONTAL
6 ✓	8" X 4" Tee	47	G	1	12+84/Lt.	19.5'	5'
7 ✓	8" X 4" Tee	48	G	1	13+76/Lt.	18.0'	5'
8 ✓	8" X 4" Tee	49	G	1	14+68/Lt.	15.5'	5'
9 ✓	4" Stub	50	G	1	15+54.4/Lt.	12.5'	5'
10 ✓	8" X 4" Tee	51	G	1	16+72/Lt.	9.0'	5'

NOTE: Vertical Riser Pipe shall be extended to 2' minimum above ground water elevation and 4' maximum below proposed ground elevation.

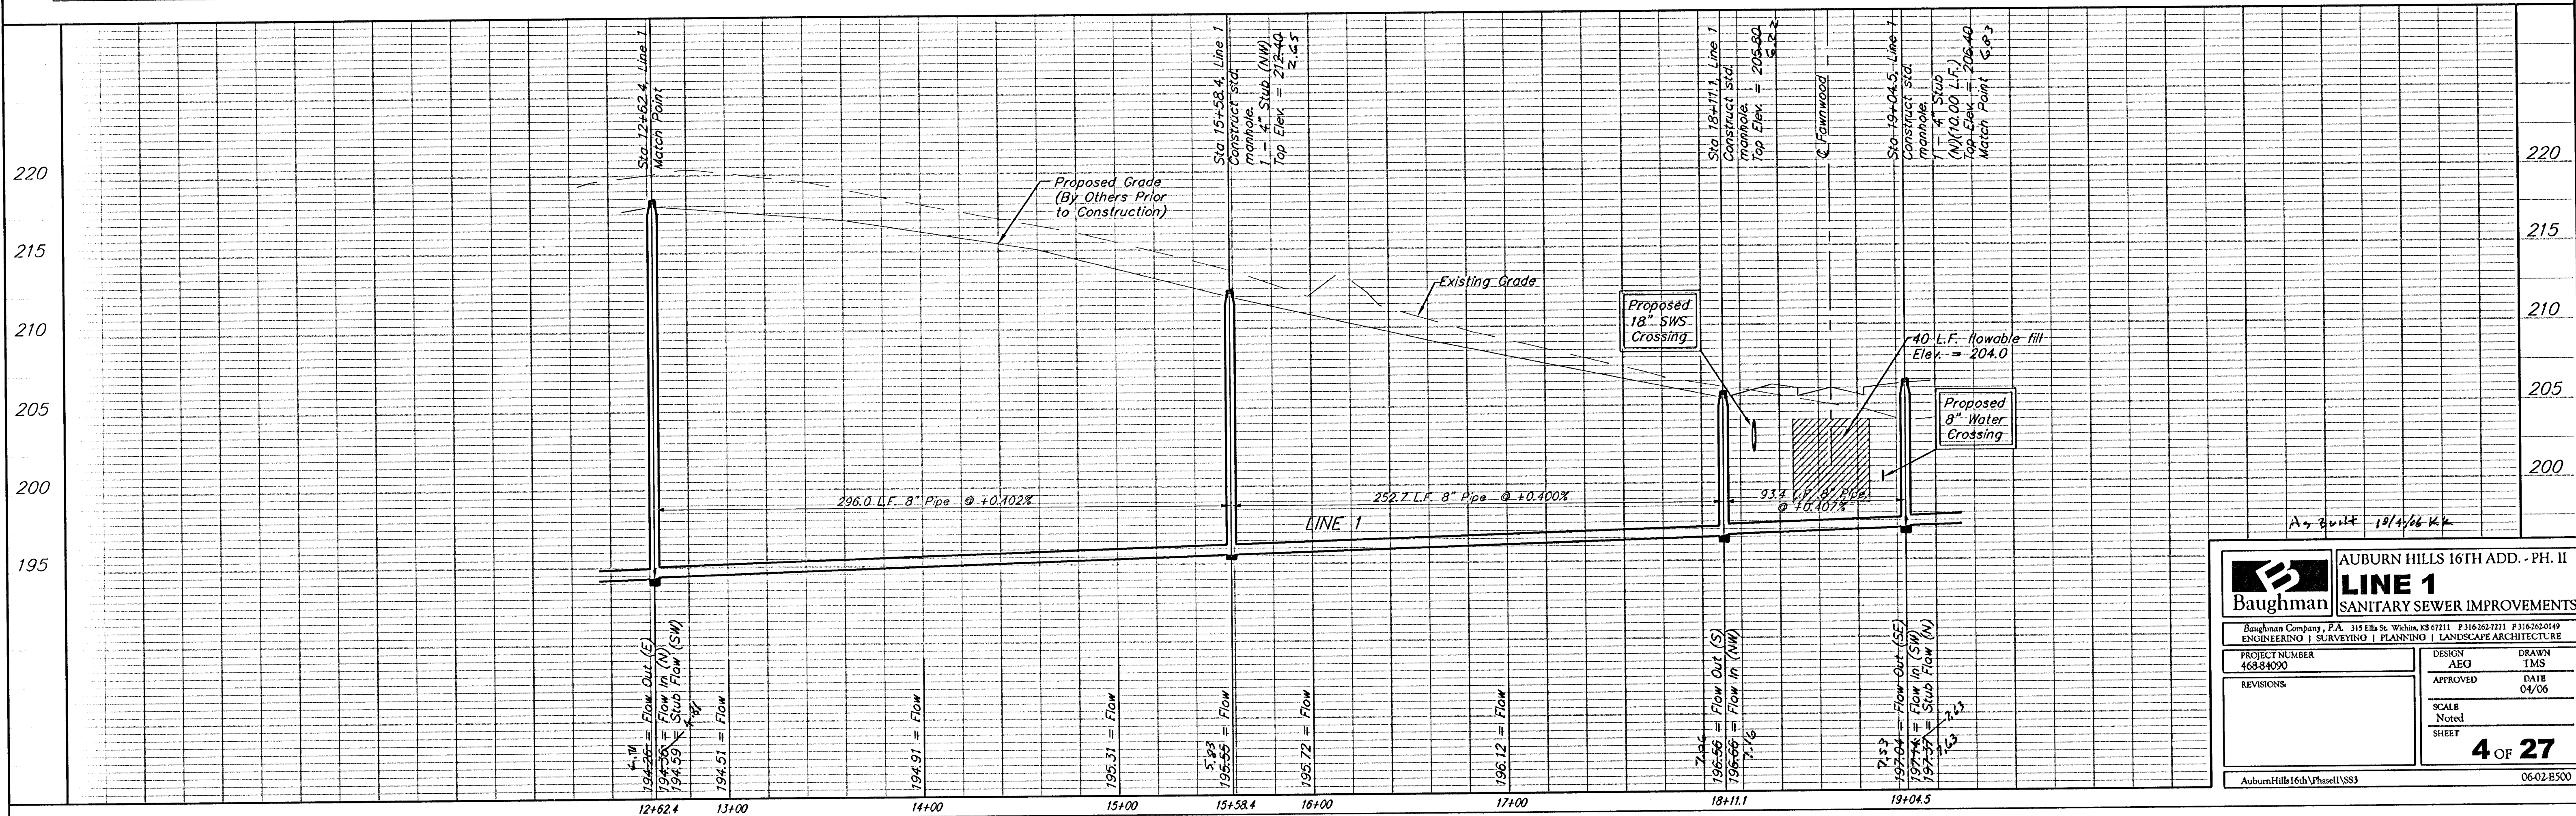

Baughman

AUBURN HILLS 16TH ADD. - PH. II

LINE 1

SANITARY SEWER IMPROVEMENTS

PROJECT NUMBER
4684090

DESIGN
AEO

DRAWN
TMS

APPROVED
DATE
04/06

SCALE
Noted

SHEET
4 OF 27

Auburn Hills 16th Phase II SWS

06-02-E500