


BENCHMARKS:

BM #1: "Cut on Top of Curb
at West Line of Lot 7, Block A,
Auburn Hills 5th Addition.
Elev. = 207.73 (City Datum)

BM #2: Disc in Back of Curb,
North of Front Corner Common
to Lots 23 and 24, Block D,
Auburn Hills 12th Addition.
Elev. = 191.84 (City Datum)

BM #3: "Cut in Middle of Curb
Inlet Top Adjacent to the South
Corner of Lot 15, Block B.
Elev. = 193.65 (City Datum)


Scale: 1" = 40' Horizontal
1" = 5' Vertical
• = Iron

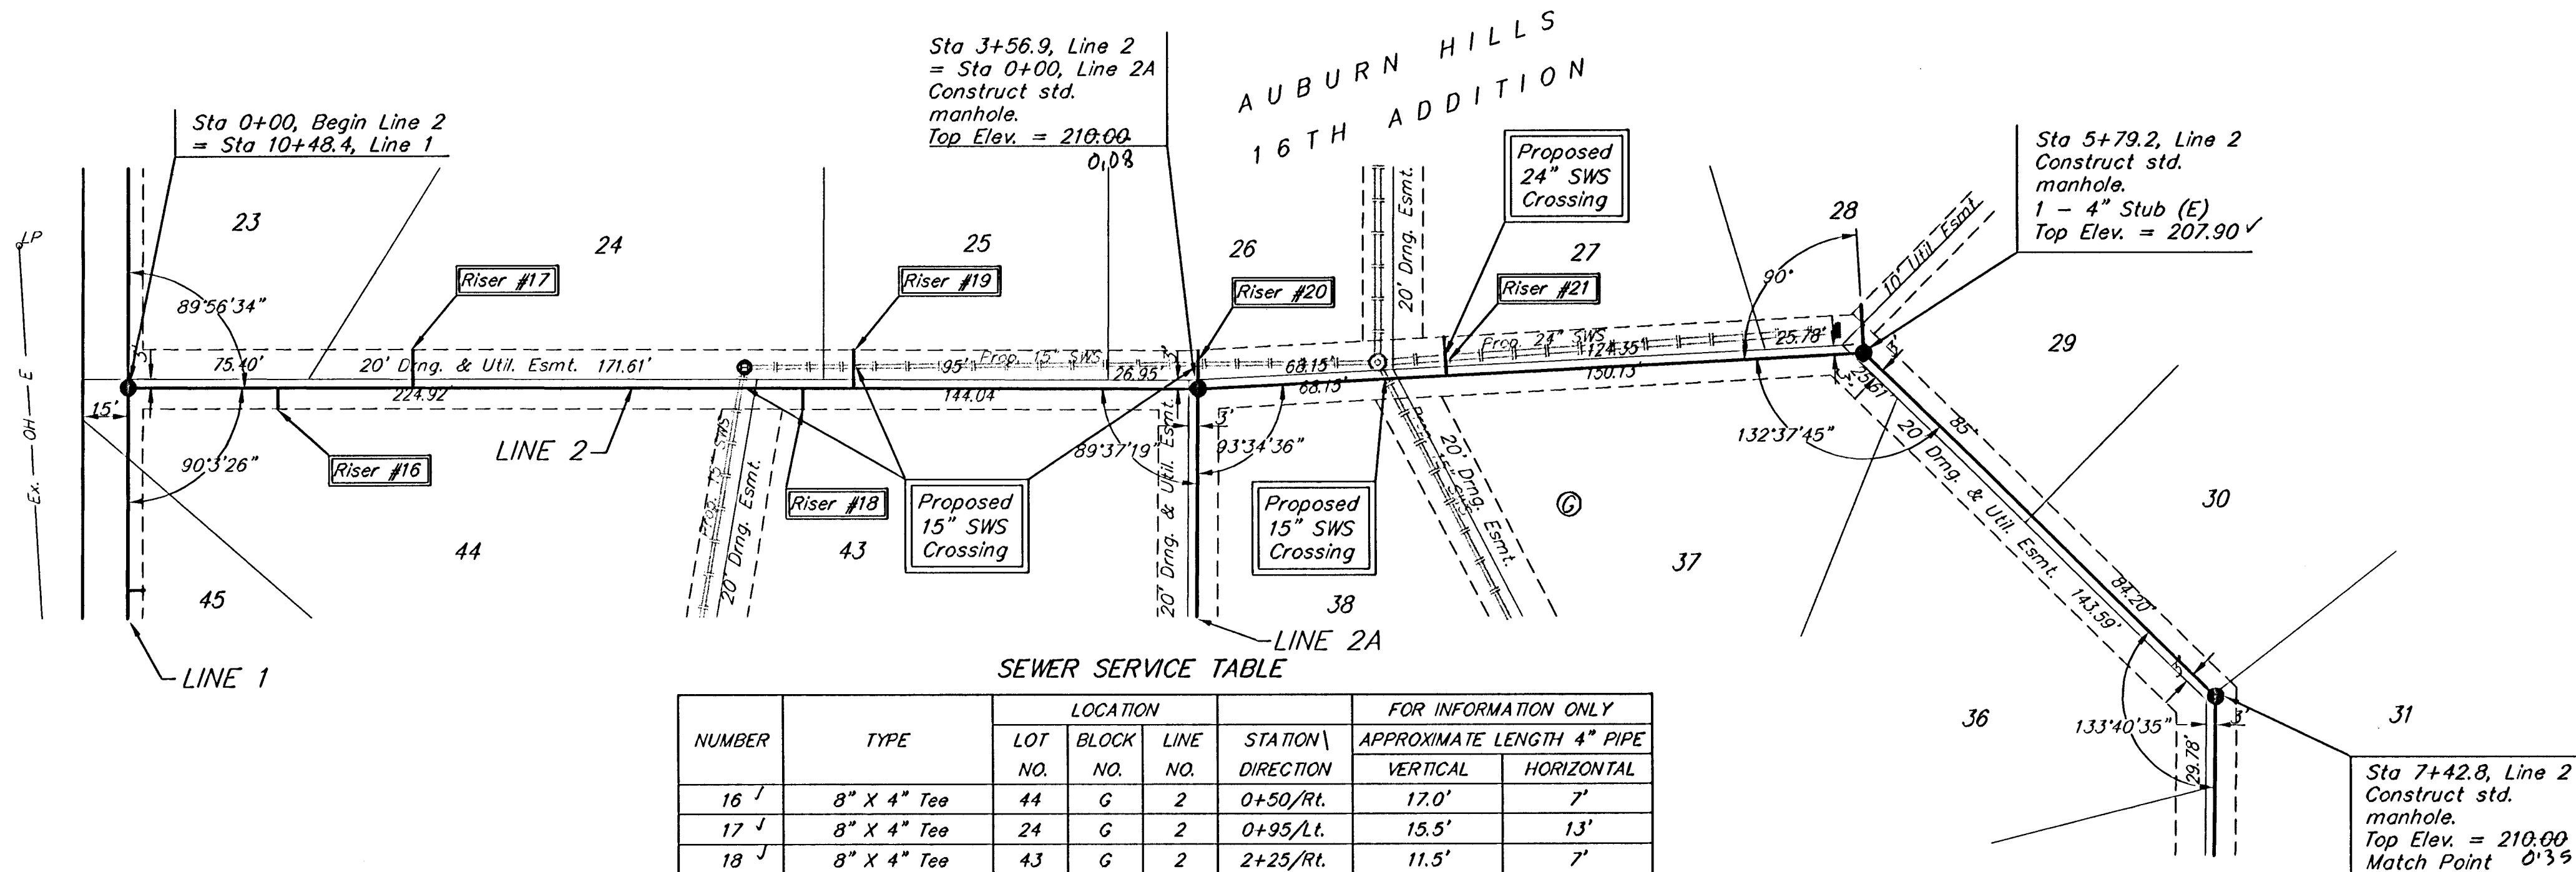

NUMBER	TYPE	LOCATION			FOR INFORMATION ONLY	
		LOT NO.	BLOCK NO.	LINE NO.	STATION DIRECTION	APPROXIMATE LENGTH 4" PIPE
16	8" X 4" Tee	44	G	2	0+50/Rt.	17.0' 7'
17	8" X 4" Tee	24	G	2	0+95/Lt.	15.5' 13'
18	8" X 4" Tee	43	G	2	2+25/Rt.	11.5' 7'
19	8" X 4" Tee	25	G	2	2+42/Lt.	11.0' 13'
20	4" Stub	26	G	2	3+56.9/Lt.	8.5' 13'
21	8" X 4" Tee	27	G	2	4+40/Lt.	6.5' 13'

NOTE: Vertical Riser Pipe shall be extended to 2' minimum above ground water elevation and 4' maximum below proposed ground elevation.

Remove trees only as necessary
for sanitary sewer construction
and only with permission of
Developer or Baughman Co.
Cost of removal to be incidental
to lump sum bid item "Site
Clearing & Restoration".

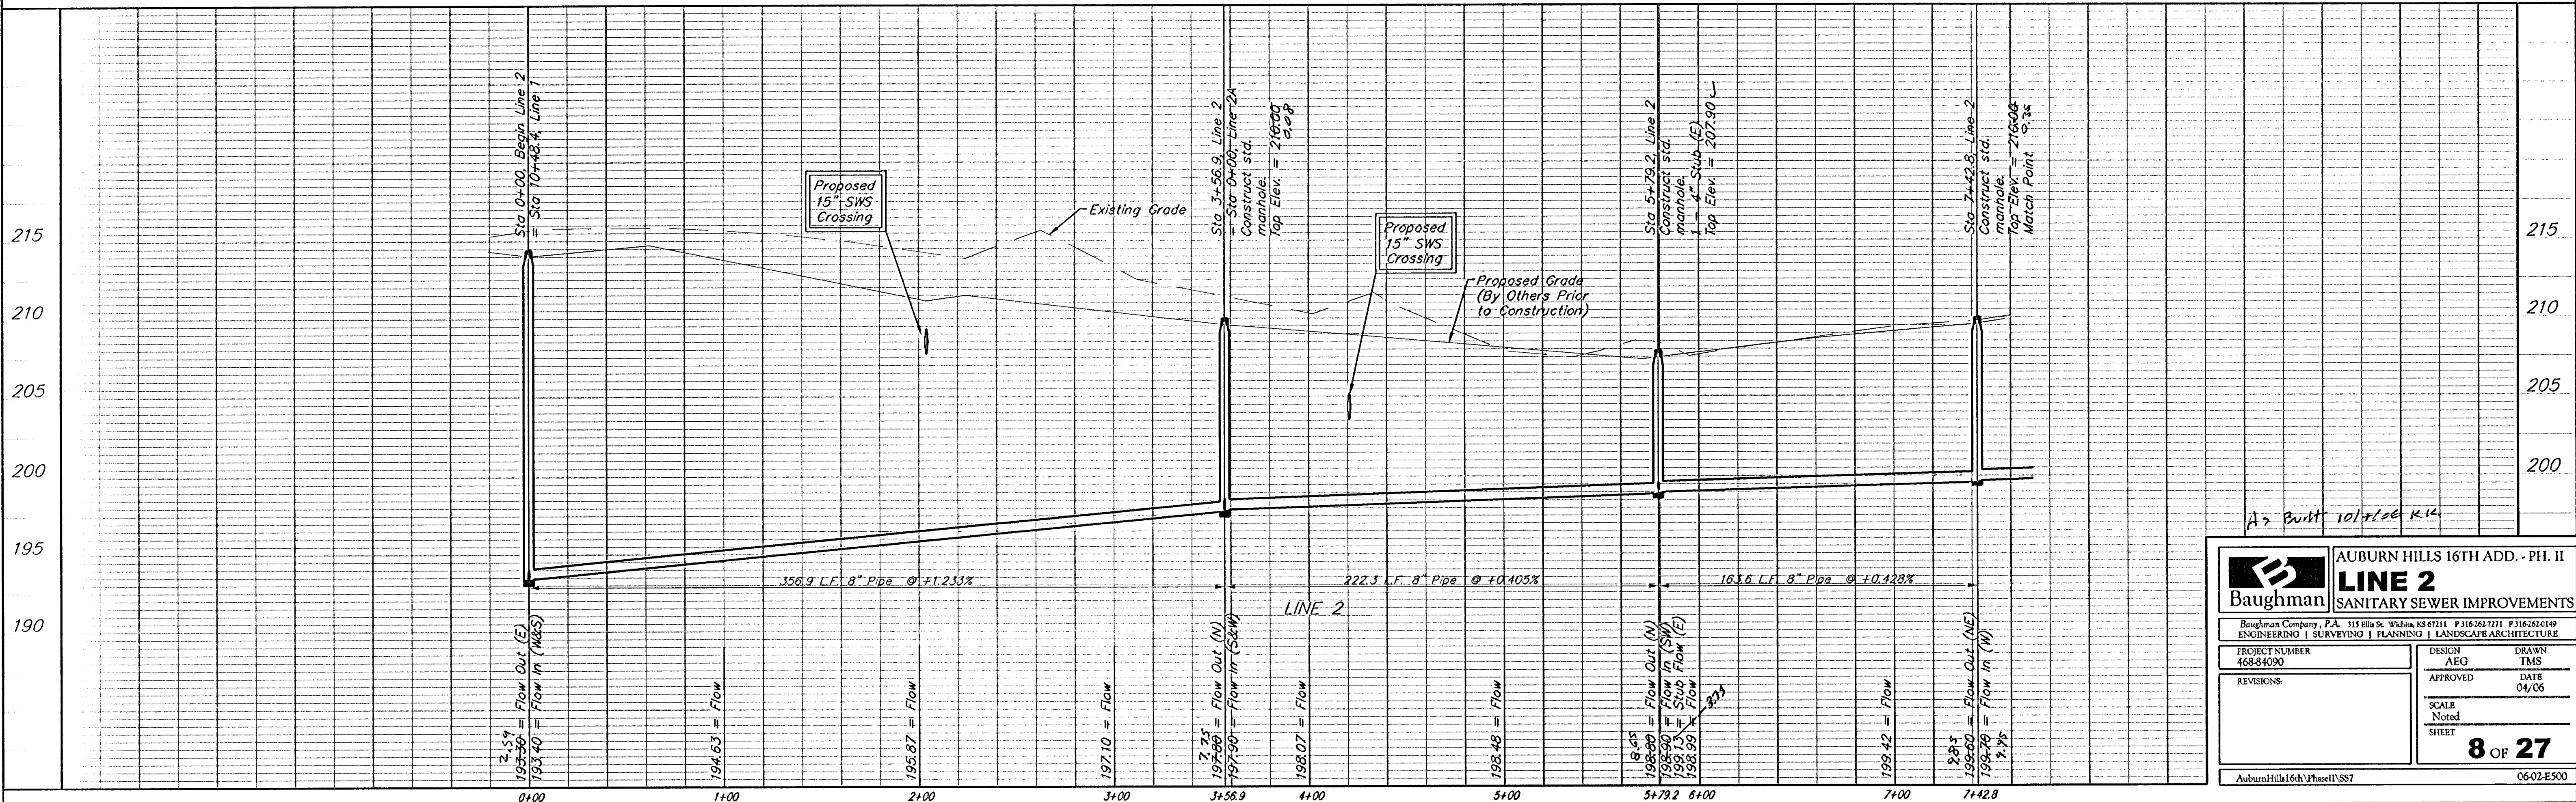

Baughman AUBURN HILLS 16TH ADD. - PH. II
LINE 2
SANITARY SEWER IMPROVEMENTS

PROJECT NUMBER: 468-84090
DESIGN: AEG
DRAWN: TMS
APPROVED: DATE: 04/06
SCALE: Noted
SHEET: 8 OF 27

Revisions:
1. 04/06/06

Auburn Hills 16th Phase I VSS7 06-02-E500