
BENCHMARKS:
BM #1: "□" Cut on Top of Curb at West Line of Lot 7, Block A, Auburn Hills 5th Addition.
Elev. = 207.73 (City Datum)

BM #2: Disc in Back of Curb, North of Front Corner Common to Lots 23 and 24, Block D, Auburn Hills 12th Addition.
Elev. = 191.84 (City Datum)

BM #3: "□" Cut in Middle of Curb Inlet Top Adjacent to the South Corner of Lot 15, Block B.
Elev. = 193.65 (City Datum)

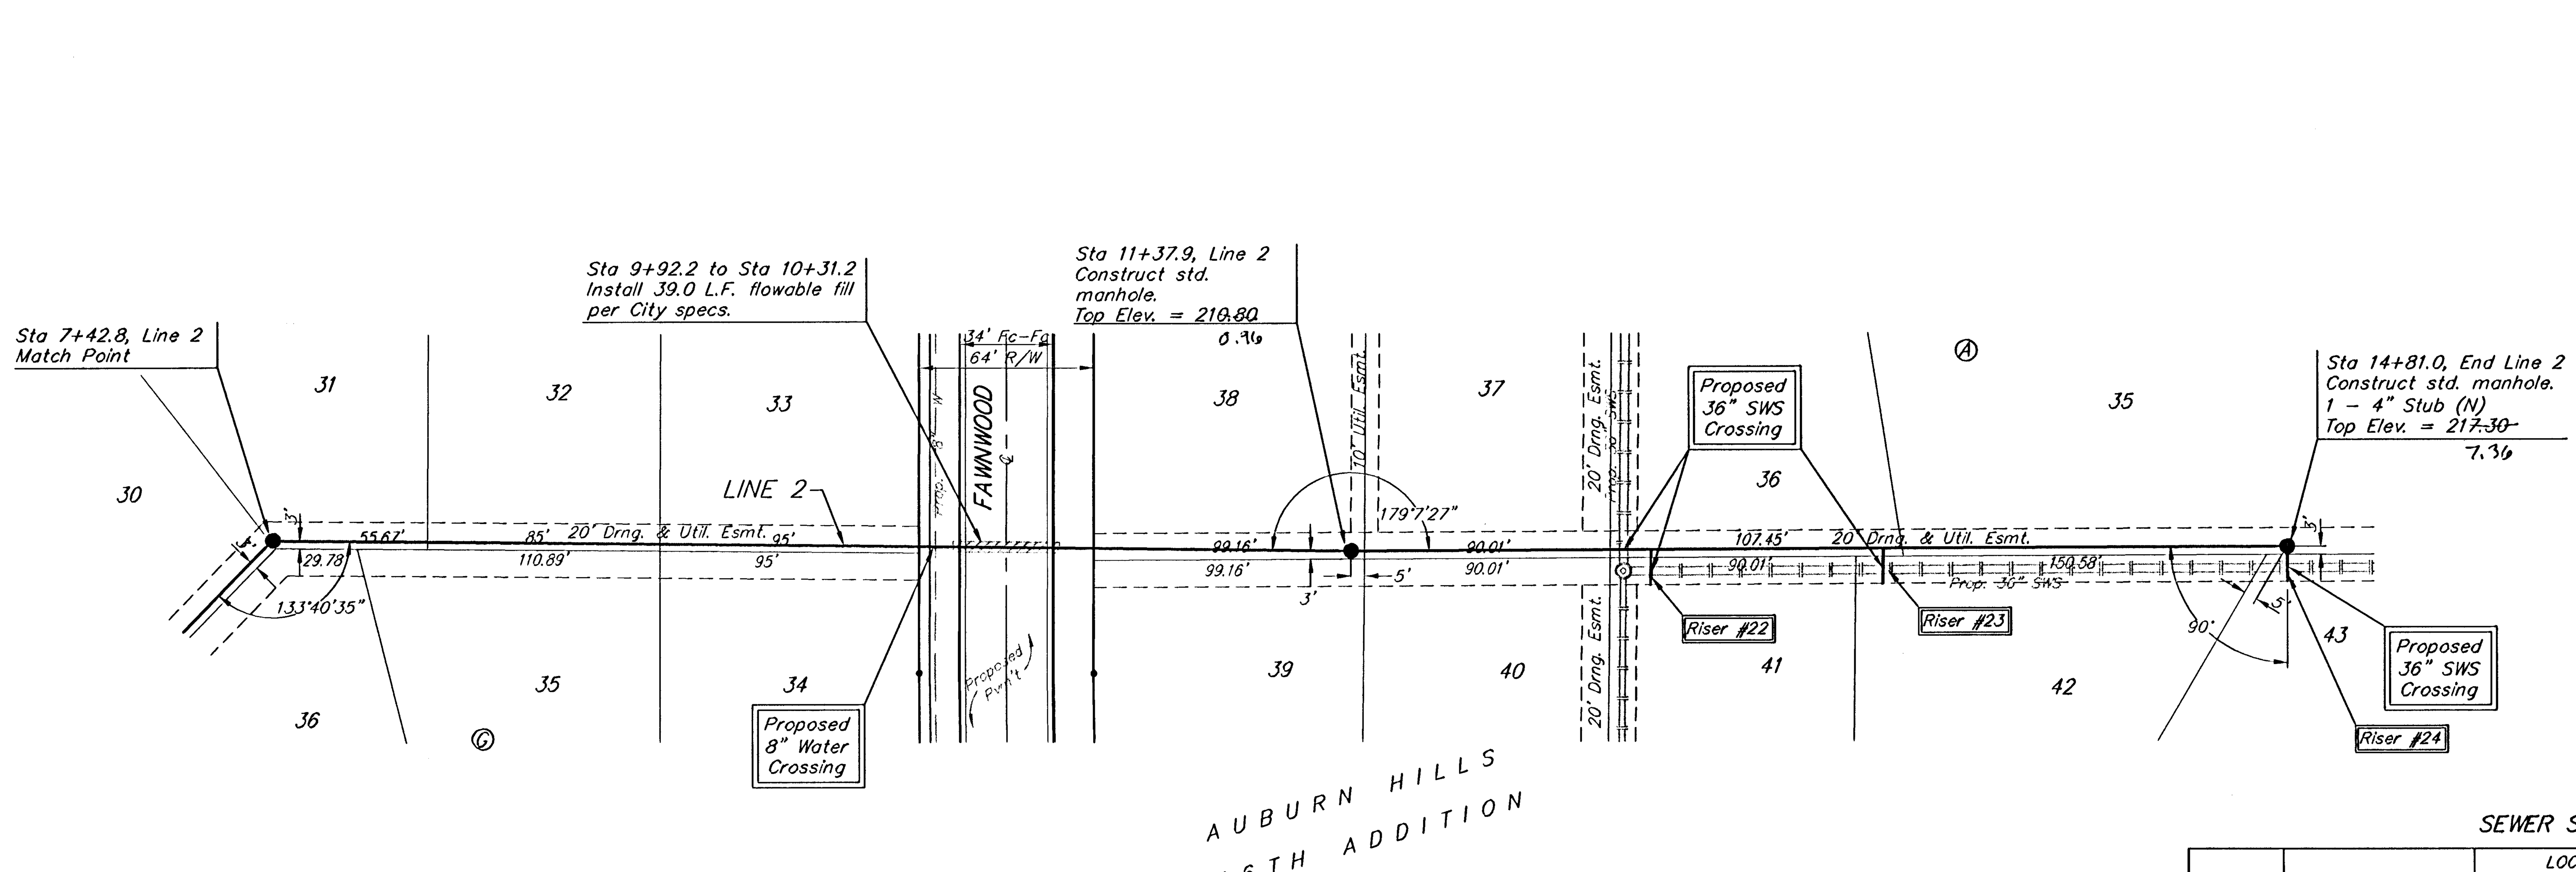


Scale: 1" = 40' Horizontal
1" = 5' Vertical
• = Iron

SEWER SERVICE TABLE

NUMBER	TYPE	LOCATION LOT NO.	LOCATION BLOCK NO.	LOCATION LINE NO.	STATION\ DIRECTION	FOR INFORMATION ONLY APPROXIMATE LENGTH 4" PIPE VERTICAL	FOR INFORMATION ONLY APPROXIMATE LENGTH 4" PIPE HORIZONTAL
22 ✓	8" X 4" Tee	41	A	2	12+48/Rt.	4.0'	13'
23 ✓	8" X 4" Tee	42	A	2	13+33/Rt.	6.0'	13'
24 ✓	4" Stub	43	A	2	14+81.0/Rt.	9.5'	13'

NOTE: Vertical Riser Pipe shall be extended to 2' minimum above ground water elevation and 4' maximum below proposed ground elevation.

Remove trees only as necessary for sanitary sewer construction and only with permission of Developer or Baughman Co. Cost of removal to be incidental to lump sum bid item "Site Clearing & Restoration".

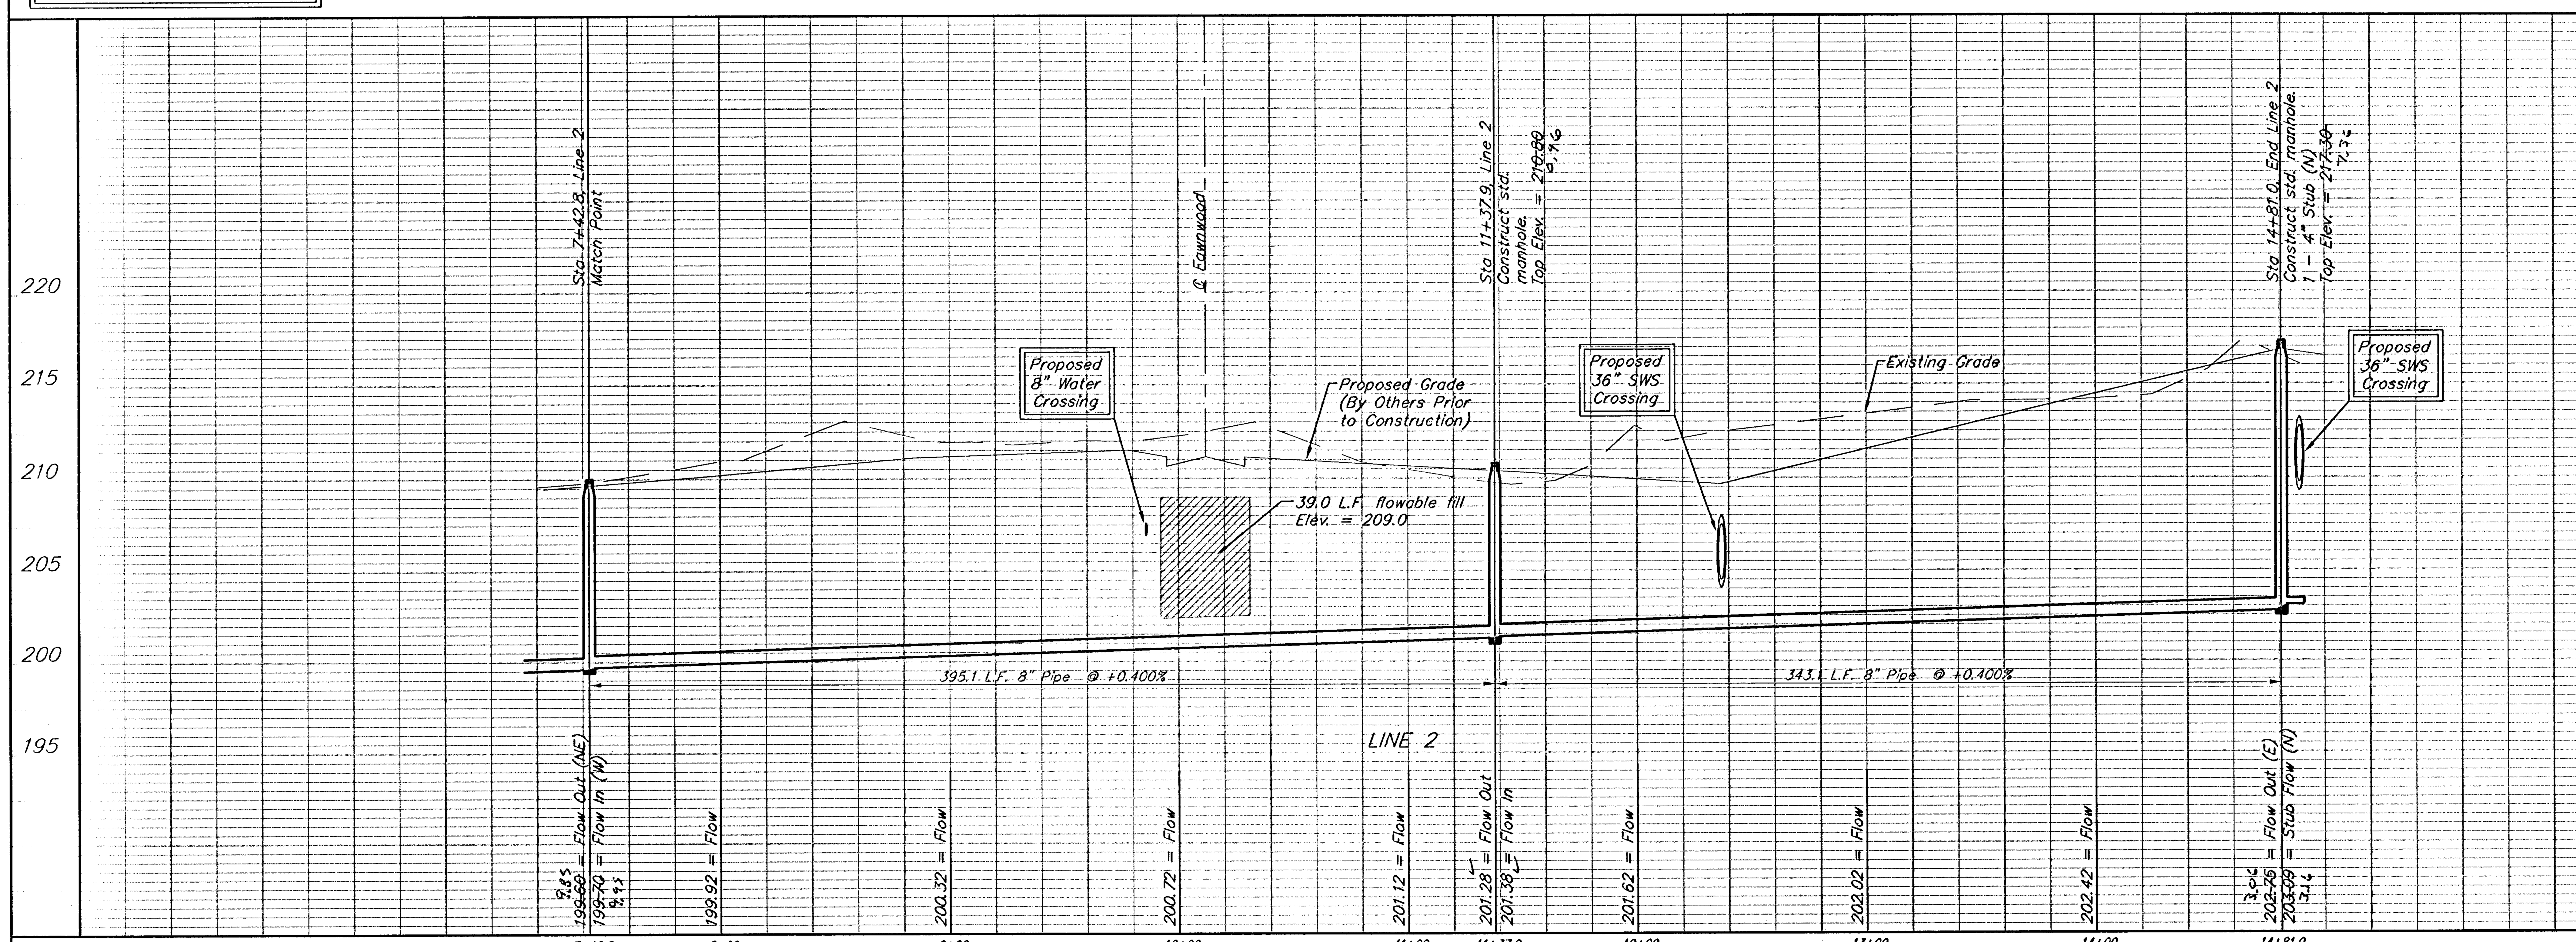

Baughman

AUBURN HILLS 16TH ADD. - PH. II

LINE 2

SANITARY SEWER IMPROVEMENTS

Baughman Company, P.A. 315 Ellis St. Wichita, KS 67211 P 316-262-7271 F 316-262-0149
ENGINEERING | SURVEYING | PLANNING | LANDSCAPE ARCHITECTURE

PROJECT NUMBER 468-84090	DESIGN AEG / DRAWN TMS
REVISIONS:	APPROVED / DATE 04/06
	SCALE Noted
	SHEET 9 OF 27

AuburnHills16th\PhaseII\SS8 06-02-E500