BENCHMARKS:
BM #1: "□" Cut on Top of Curb at West Line of Lot 7, Block A, Auburn Hills 5th Addition.
Elev. = 207.73 (City Datum)

BM #2: Disc in Back of Curb, North of Front Corner Common to Lots 23 and 24, Block D, Auburn Hills 12th Addition.
Elev. = 191.84 (City Datum)

BM #3: "□" Cut in Middle of Curb Inlet Top Adjacent to the South Corner of Lot 15, Block B.
Elev. = 193.65 (City Datum)

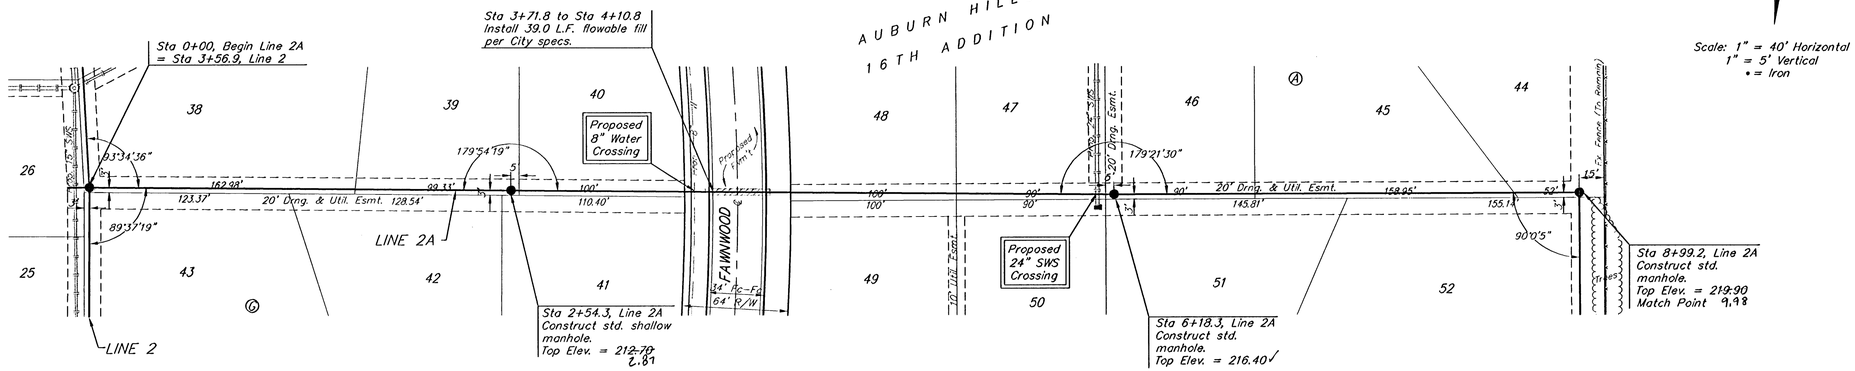


Scale: 1" = 40' Horizontal
1" = 5' Vertical
• = Iron

Remove trees only as necessary for sanitary sewer construction and only with permission of Developer or Baughman Co. Cost of removal to be incidental to lump sum bid item "Site Clearing & Restoration".

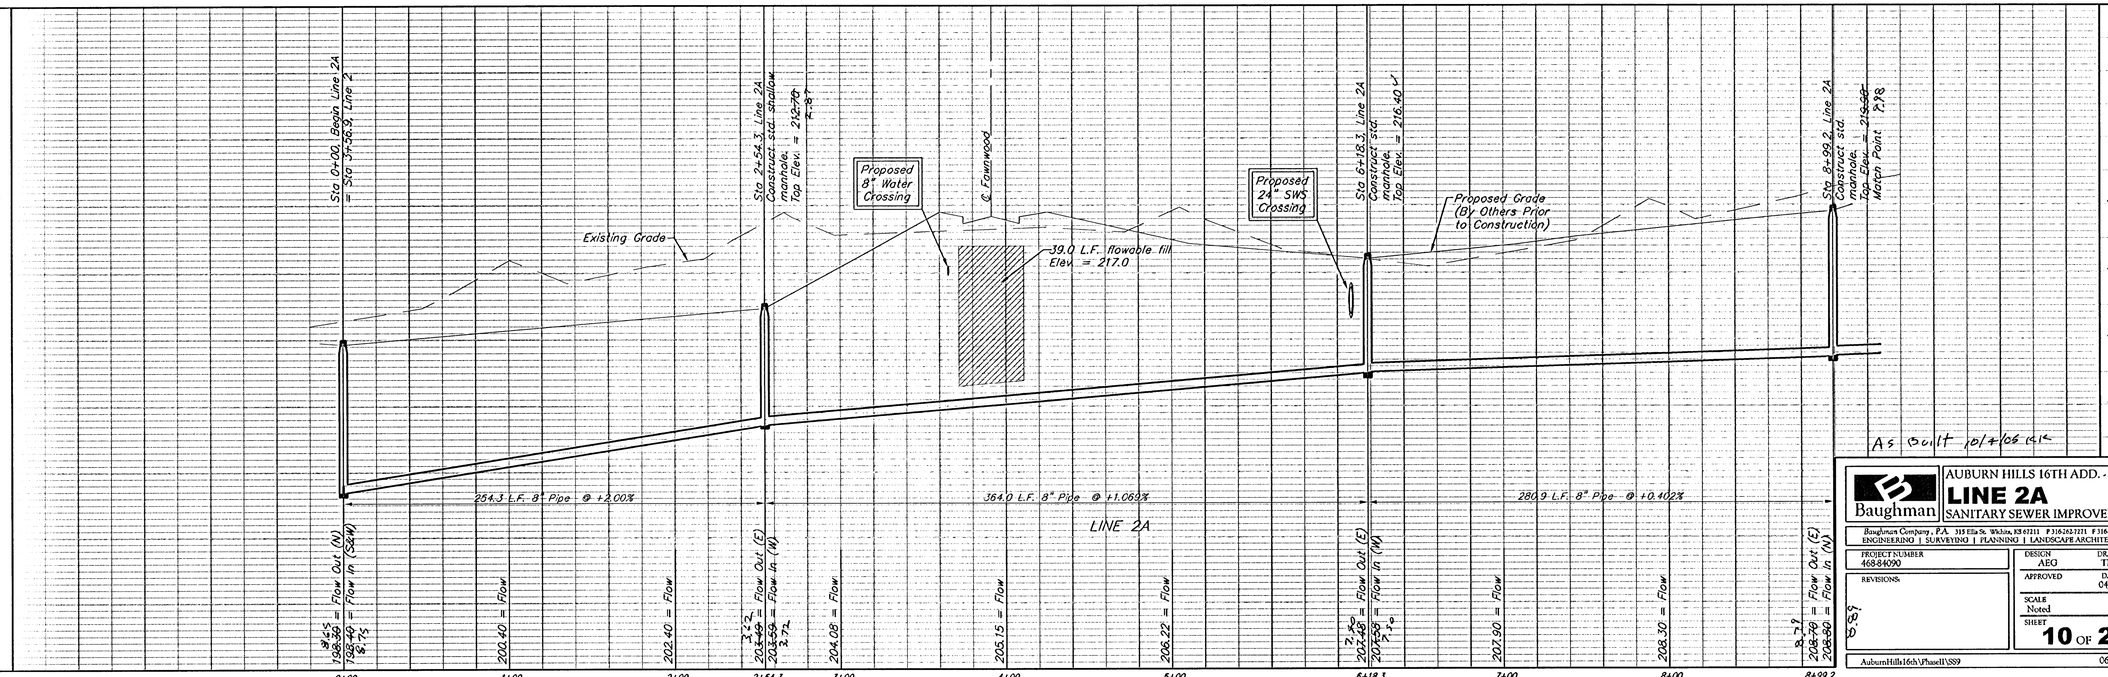


As Built 10/4/06 ck

Baughman

AUBURN HILLS 16TH ADD. - PH. II
**LINE 2A**
SANITARY SEWER IMPROVEMENTS


Baughman Company, P.A. 315 Ella St. Wichita, KS 67211 P 316.262.2221 F 316.262.6149
ENGINEERING | SURVEYING | PLANNING | LANDSCAPE ARCHITECTURE


PROJECT NUMBER 468-84090
DESIGN AEG
DRAWN TMS
APPROVED
DATE 04/06
REVISIONS:
SCALE Noted
SHEET **10** OF **27**

AuburnHills16th\Phase II\SS9
06-02-E500