


BENCHMARKS:

BM #1: "x" in the top of curb inlet, located on the west side of Davin Cir. at the NE corner of Lot 18, Block H, Fairmont Addition.
Elev. = 198.18 (MSL)

BM #2: "□" on NE corner of inlet structure, located at the SW corner of the intersection of Mainsgate and 127th Street East.
Elev. = 182.33 (MSL)

BM #3: RR spike on the west face of PP on the east side of 127th Street East, adjacent to the south line of The Fairmont Addition.
Elev. = 187.25 (City Datum)

BM #4: RR spike on the east face of PP on the west side of 127th Street East, 37' N and 13' E of the NE corner of Lot 1, Block H, The Fairmont Addition.
Elev. = 189.19 (City Datum)

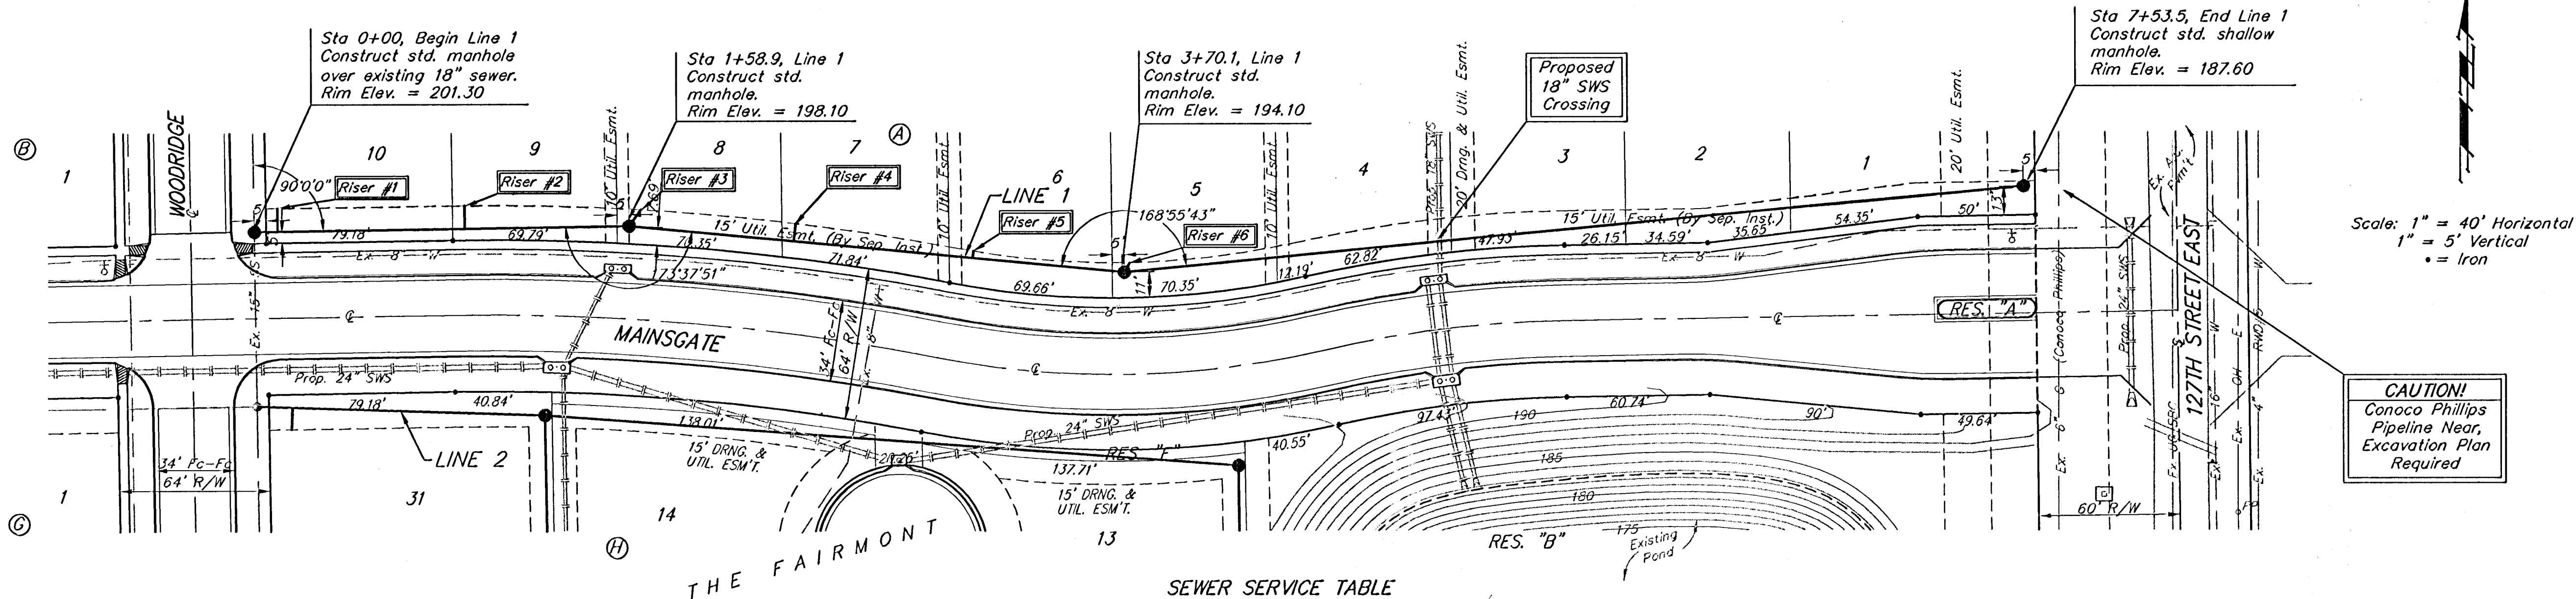


SEWER SERVICE TABLE

NUMBER	TYPE	LOCATION			STATION\ DIRECTION	FOR INFORMATION ONLY	
		LOT NO.	BLOCK NO.	LINE NO.		APPROXIMATE LENGTH 4" PIPE	
						VERTICAL	HORIZONTAL
1	8" X 4" Tee	10	A	1	0+10/Lt. 13	18.0'	10'
2	8" X 4" Tee	9	A	1	0+89/Lt. 91.6	16.0'	18' 10.5'
3	4" Stub	8	A	1	1+58.9/Lt.	14.5'	8' MH stub to Lt.
4	8" X 4" Tee	7	A	1	2+29/Lt. 28.7	13.0'	8' 8.3'
5	8" X 4" Tee	6	A	1	3+08/Lt. 04.9	11.5'	8' 3.7'
6	4" Stub	5	A	1	3+70.1/Lt.	9.5'	8' MH stub to Lt.

NOTE: Vertical Riser Pipe shall be extended to 2' minimum above ground water elevation and 4' maximum below proposed ground elevation.

All trench and manhole excavation areas from Sta. 0+00 to Sta. 7+53.5, Line 1 shall be backfilled with sand. The sand backfill shall be within two feet of existing grade and shall be water-jetted and vibrated during backfilling. All costs shall be paid for as L.F. "Sand Backfill Jetted and Vibrated".

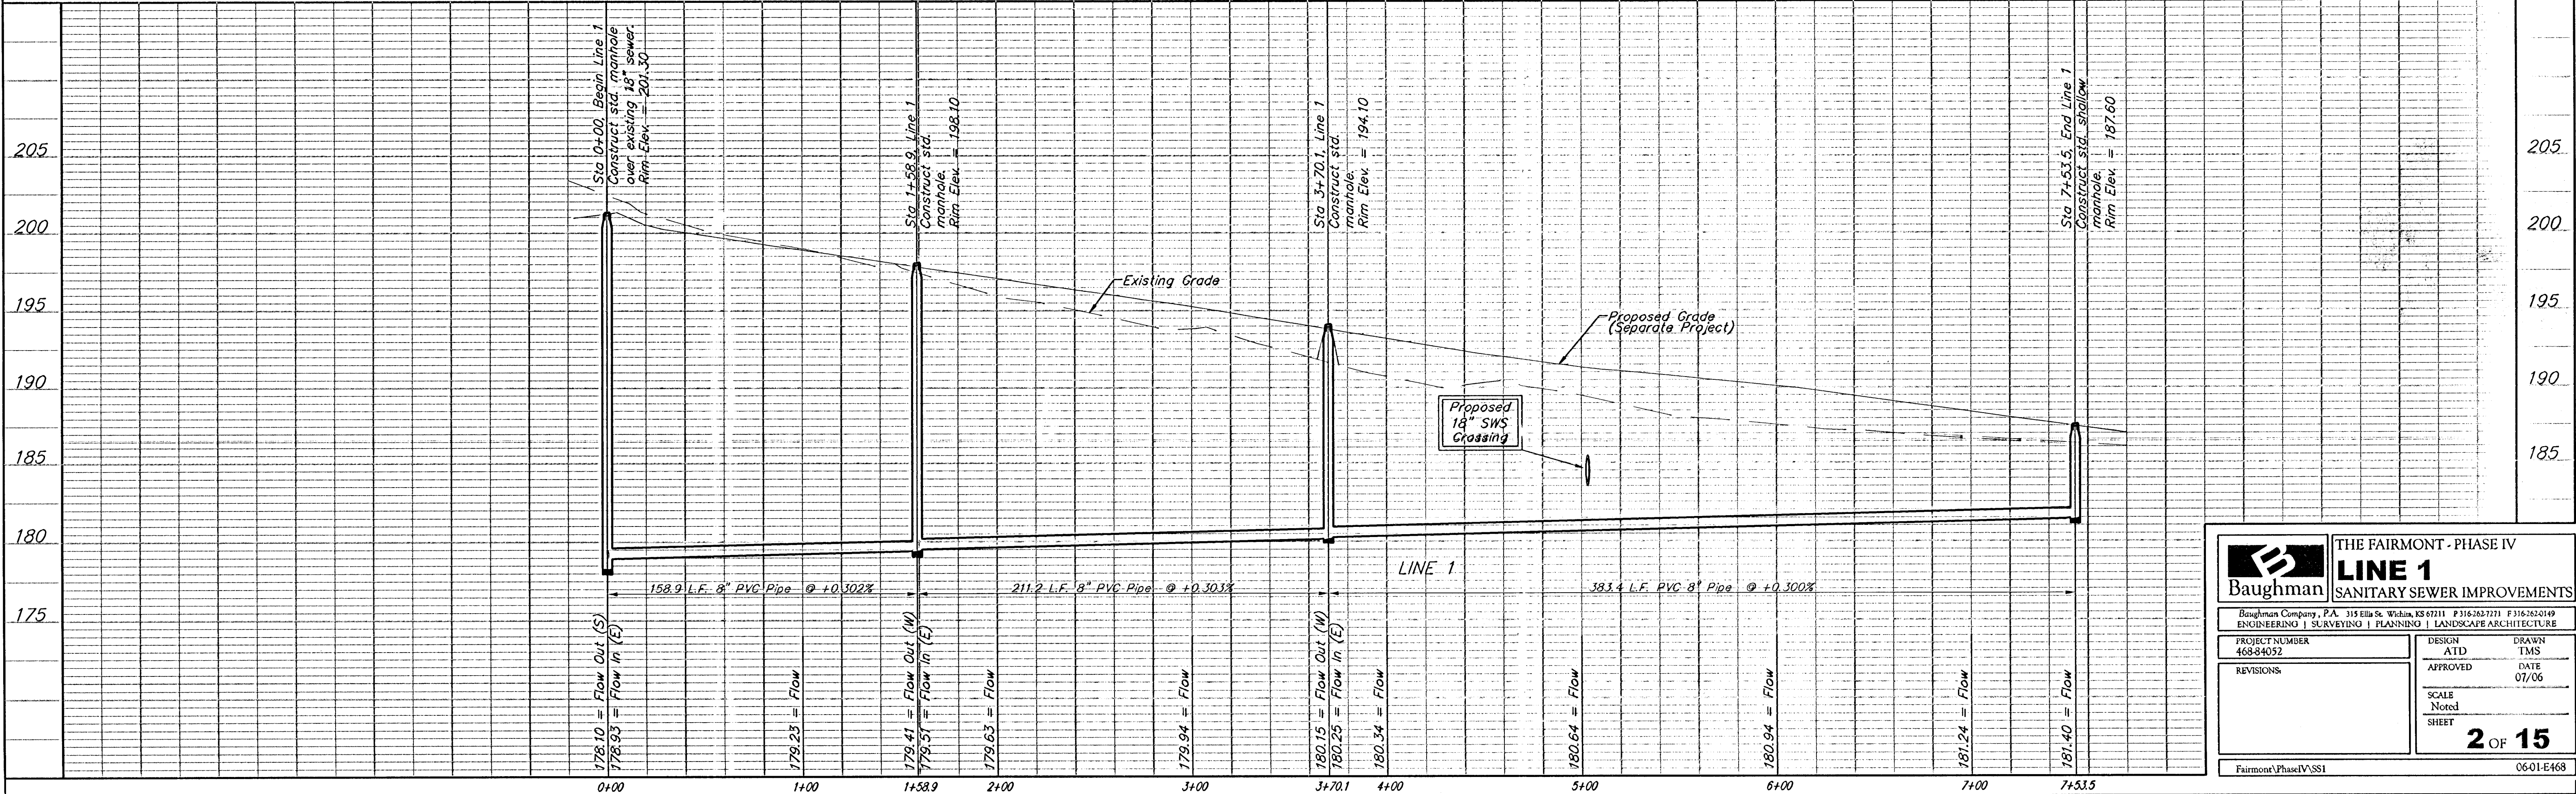

THE FAIRMONT - PHASE IV	
LINE 1	
SANITARY SEWER IMPROVEMENTS	
ENGINEERING SURVEYING PLANNING LANDSCAPE ARCHITECTURE	
PROJECT NUMBER 469-0402	DESIGN ATD
REVISIONS	DRAWN TMS
	APPROVED DATE 07/06
	SCALE Noted
	SHEET 2 OF 15
Fairmont Phase IV SSI	0601-E468