

FOX RIDGE ADDITION

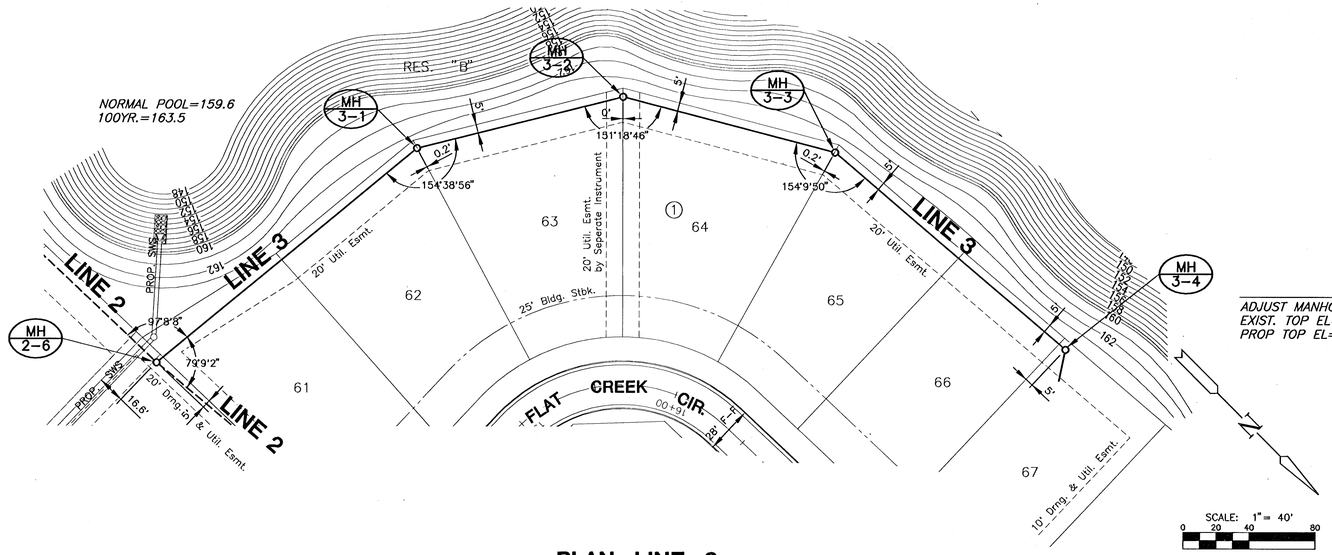

PLAN LINE 3

FOX RIDGE ADDITION

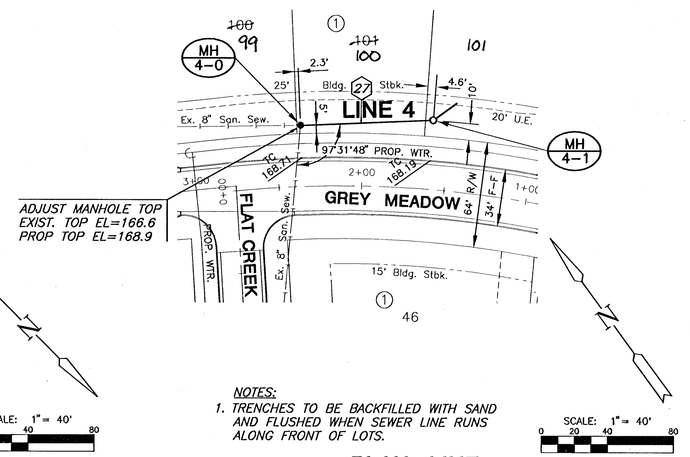


ADJUST MANHOLE TOP
EXIST. TOP EL=166.6
PROP TOP EL=168.9

NOTES:
1. TRENCHES TO BE BACKFILLED WITH SAND AND FLUSHED WHEN SEWER LINE RUNS ALONG FRONT OF LOTS.

PLAN LINE 4

PROFILE LINE 3

SCALE: HORIZ. 1"=40'
SCALE: VERT. 1"=5'

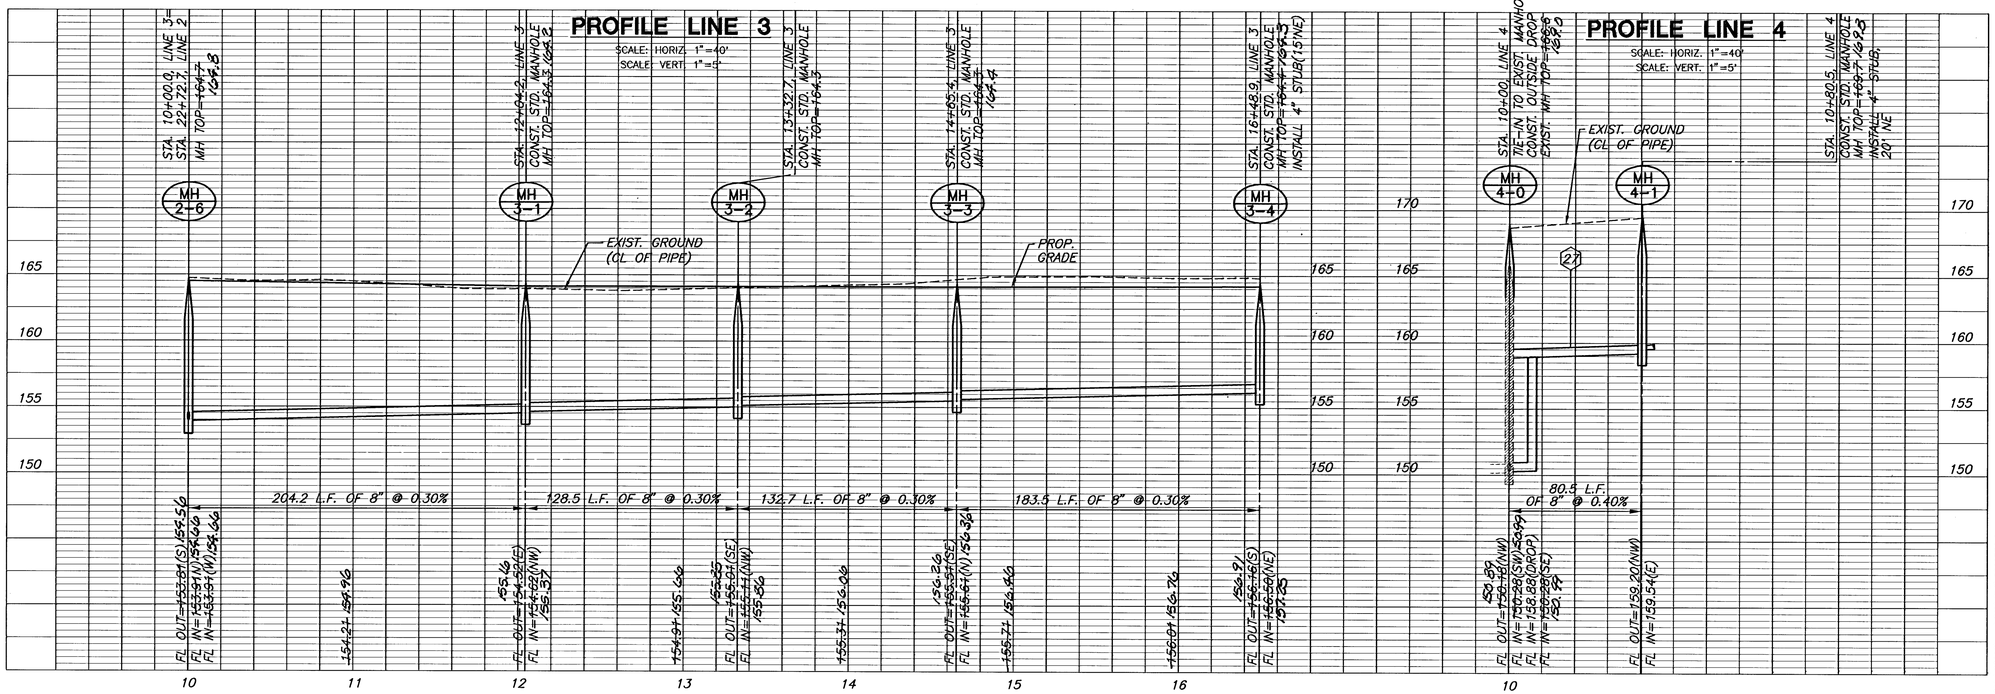

PROFILE LINE 4

SCALE: HORIZ. 1"=40'
SCALE: VERT. 1"=5'

MKEC ENGINEERING CONSULTANTS, INC.
411 N. WEBB ROAD
WICHITA, KS. 67206
316 - 684 - 9600

SANITARY SEWER PLANS

FOX RIDGE

PHASE 9

LINE 3 & 4
SHEET TITLE

468-84202
PROJECT NUMBER

DFL
DESIGN BY

MKEC
DRAWN BY

GJA
CHECKED BY

ISSUED
JULY 2006
REVISED

SHEET NO.
7 of 14

PLOTTED: Wednesday, July 05, 2006 @ 09:03AM

G:\CIVIL\99118\dwg\SAN\PhD\99118B4.dwg

MKEC ENGINEERING CONSULTANTS, INC. © COPYRIGHT