
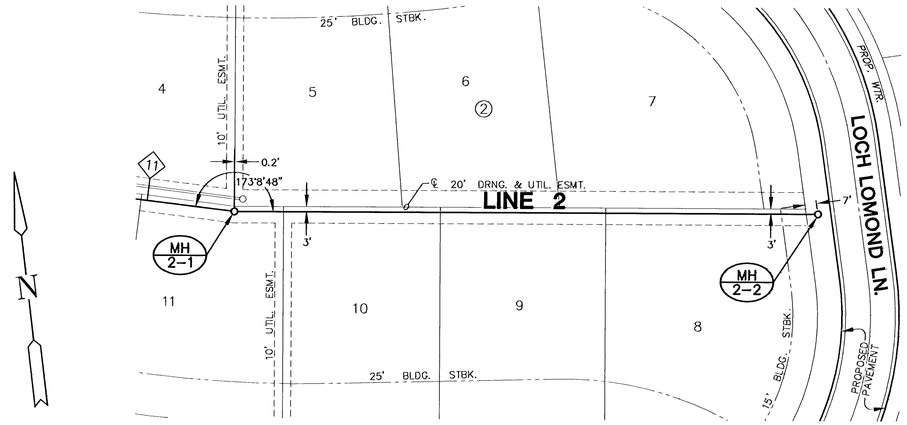


HAWTHORNE THIRD ADDITION

NOTES:
CONTRACTOR TO VERIFY THE DEPTH AND LOCATION OF EXISTING UTILITIES PRIOR TO CONSTRUCTION.

TRENCHES TO BE BACKFILLED WITH SAND AND FLUSHED WHEN SEWER LINE RUNS ALONG FRONT OF LOTS.

PLAN LINE 2

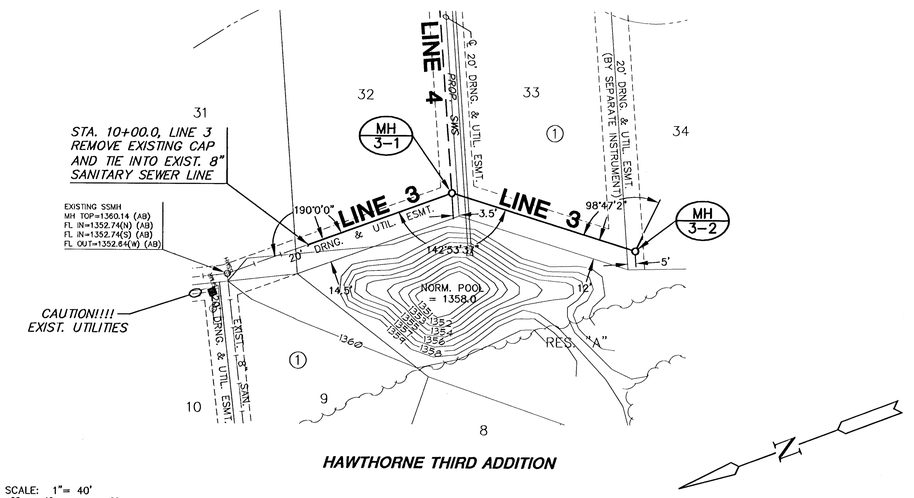

HAWTHORNE THIRD ADDITION


SCALE: 1"= 40'
0 20 40 80

PLAN LINE 3

(AB) = AS-BUILT


PROFILE LINE 2

SCALE: HORIZ. 1"=40'
SCALE: VERT. 1"=5'

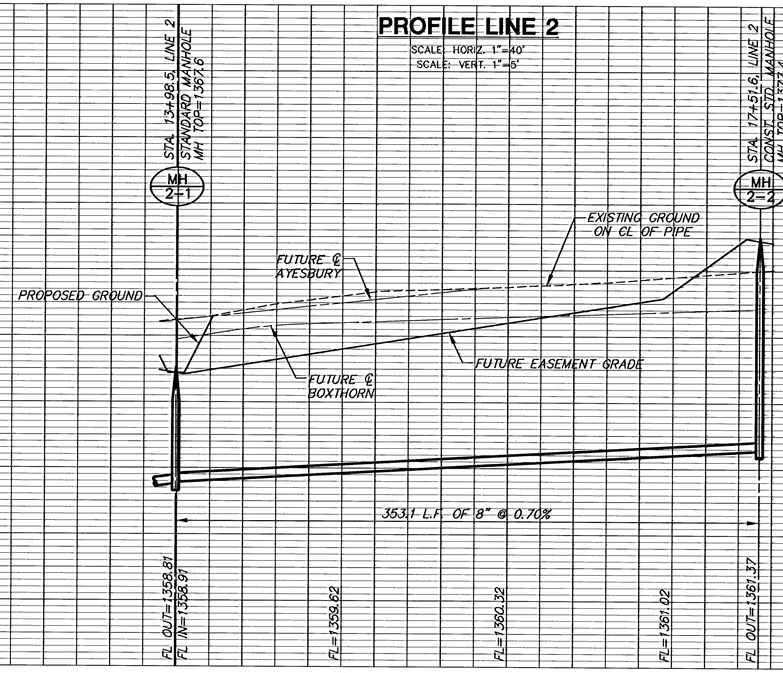

PROFILE LINE 3

SCALE: HORIZ. 1"=40'
SCALE: VERT. 1"=5'

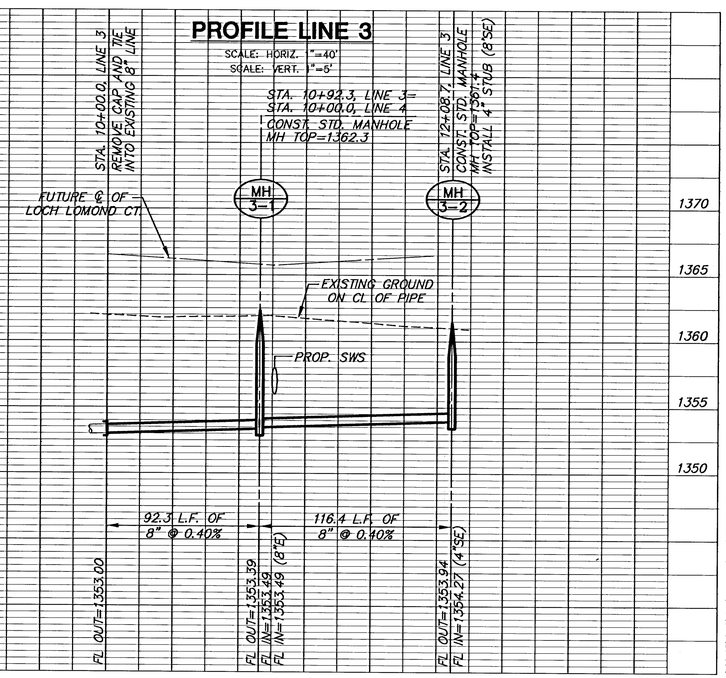

MKEC ENGINEERING CONSULTANTS, INC.
411 N. WEBB ROAD
WICHITA, KS. 67206
316 - 684 - 9600

SANITARY SEWER PLANS FOR
HAWTHORNE THIRD ADD.
PHASE 4

LINES 2 & 3
SHEET TITLE

468-83874
PROJECT NUMBER

DESIGN BY: DFL
DRAWN BY: DMU
CHECKED BY: GJA

ISSUED: JUNE 2006
REVISED

SHEET NO.
5 of 10

H:\CIVIL\02167\DWG\San\3rd Add\Ph4\02167_B2

PLOTTED: Wednesday, June 21, 2006 @ 11:01AM