

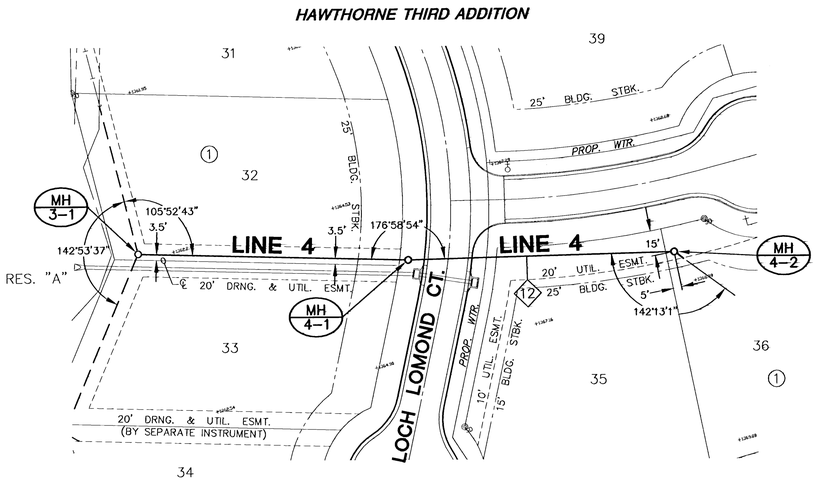


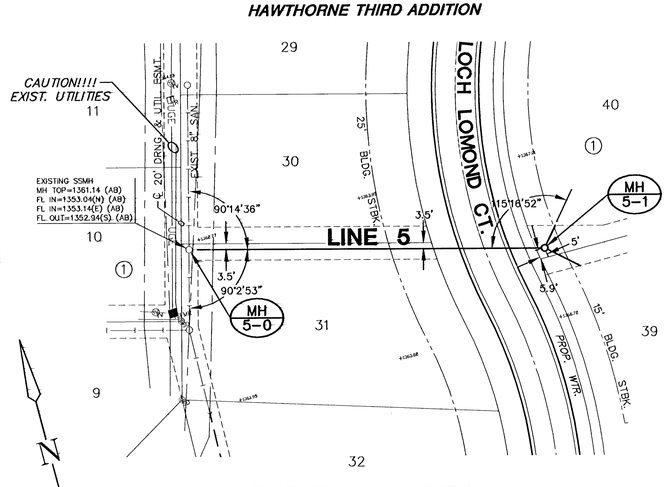

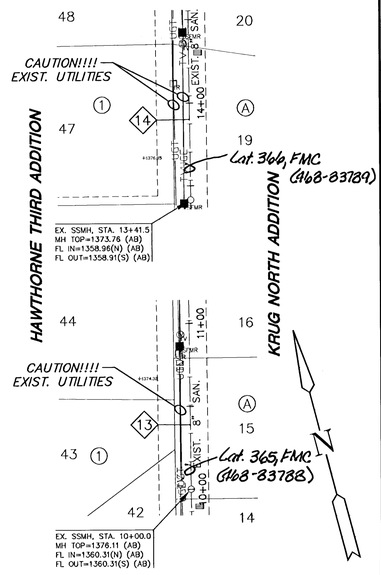

(AB) = AS-BUILT

NOTES:
CONTRACTOR TO VERIFY THE DEPTH AND LOCATION OF EXISTING UTILITIES PRIOR TO CONSTRUCTION.

TRENCHES TO BE BACKFILLED WITH SAND AND FLUSHED WHEN SEWER LINE RUNS ALONG FRONT OF LOTS.


SCALE: 1"= 40'
0 20 40 80

PLAN LINE 4

PLAN LINE 5


PROFILE LINE 4

SCALE: HORIZ. 1"=40'
SCALE: VERT. 1"=5'

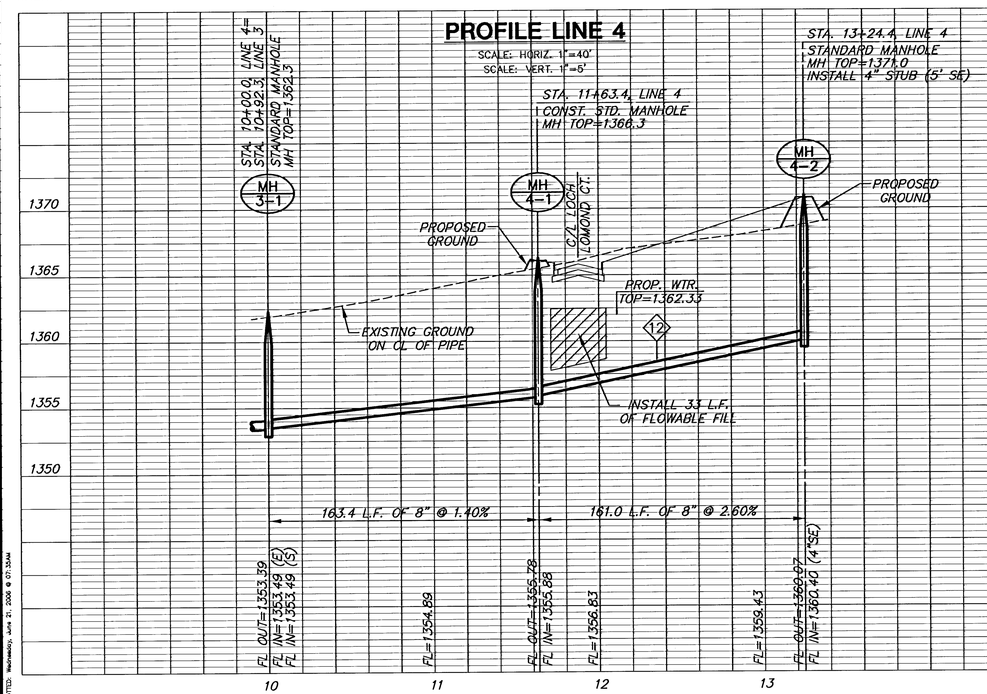

PROFILE LINE 5

SCALE: HORIZ. 1"=40'
SCALE: VERT. 1"=5'

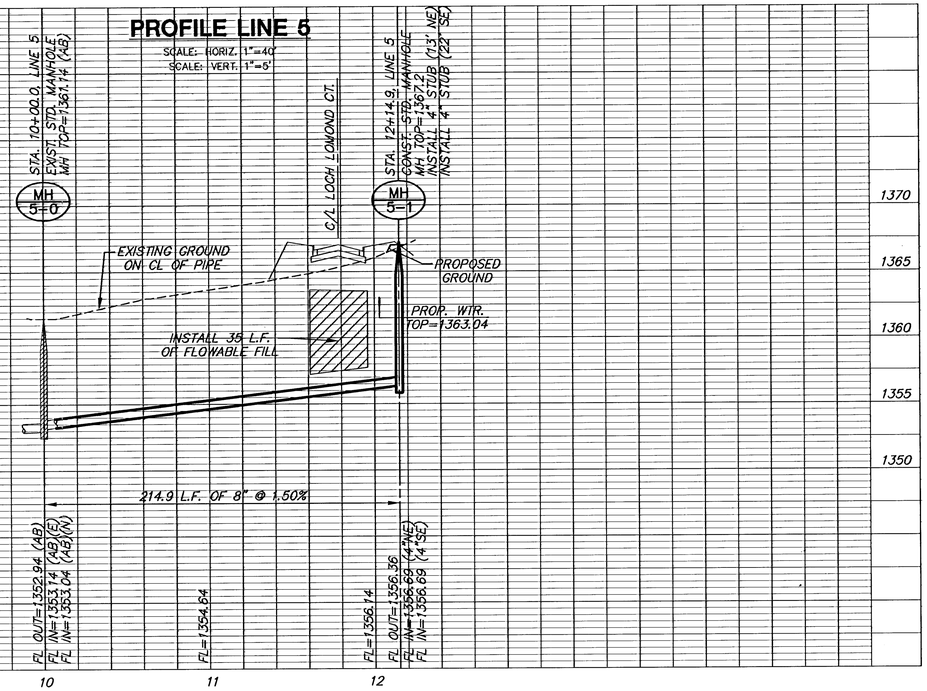

PLOTTED: Wednesday, June 21, 2006 @ 07:33AM

H:\CIVIL\02167\DWG\San\Trs Ads\PH4\02167_ST

MKEC ENGINEERING CONSULTANTS, INC.
411 N. WEBB ROAD
WICHITA, KS. 67206
316 - 684 - 9600

SANITARY SEWER PLANS FOR HAWTHORNE THIRD ADD.
PHASE 4

LINES 4 & 5
SHEET TITLE

468-83874
PROJECT NUMBER

DFL
DESIGN BY

DMU
DRAWN BY

GJA
CHECKED BY

ISSUED
JUNE 2006

REVISED

SHEET NO.
6 of 10