
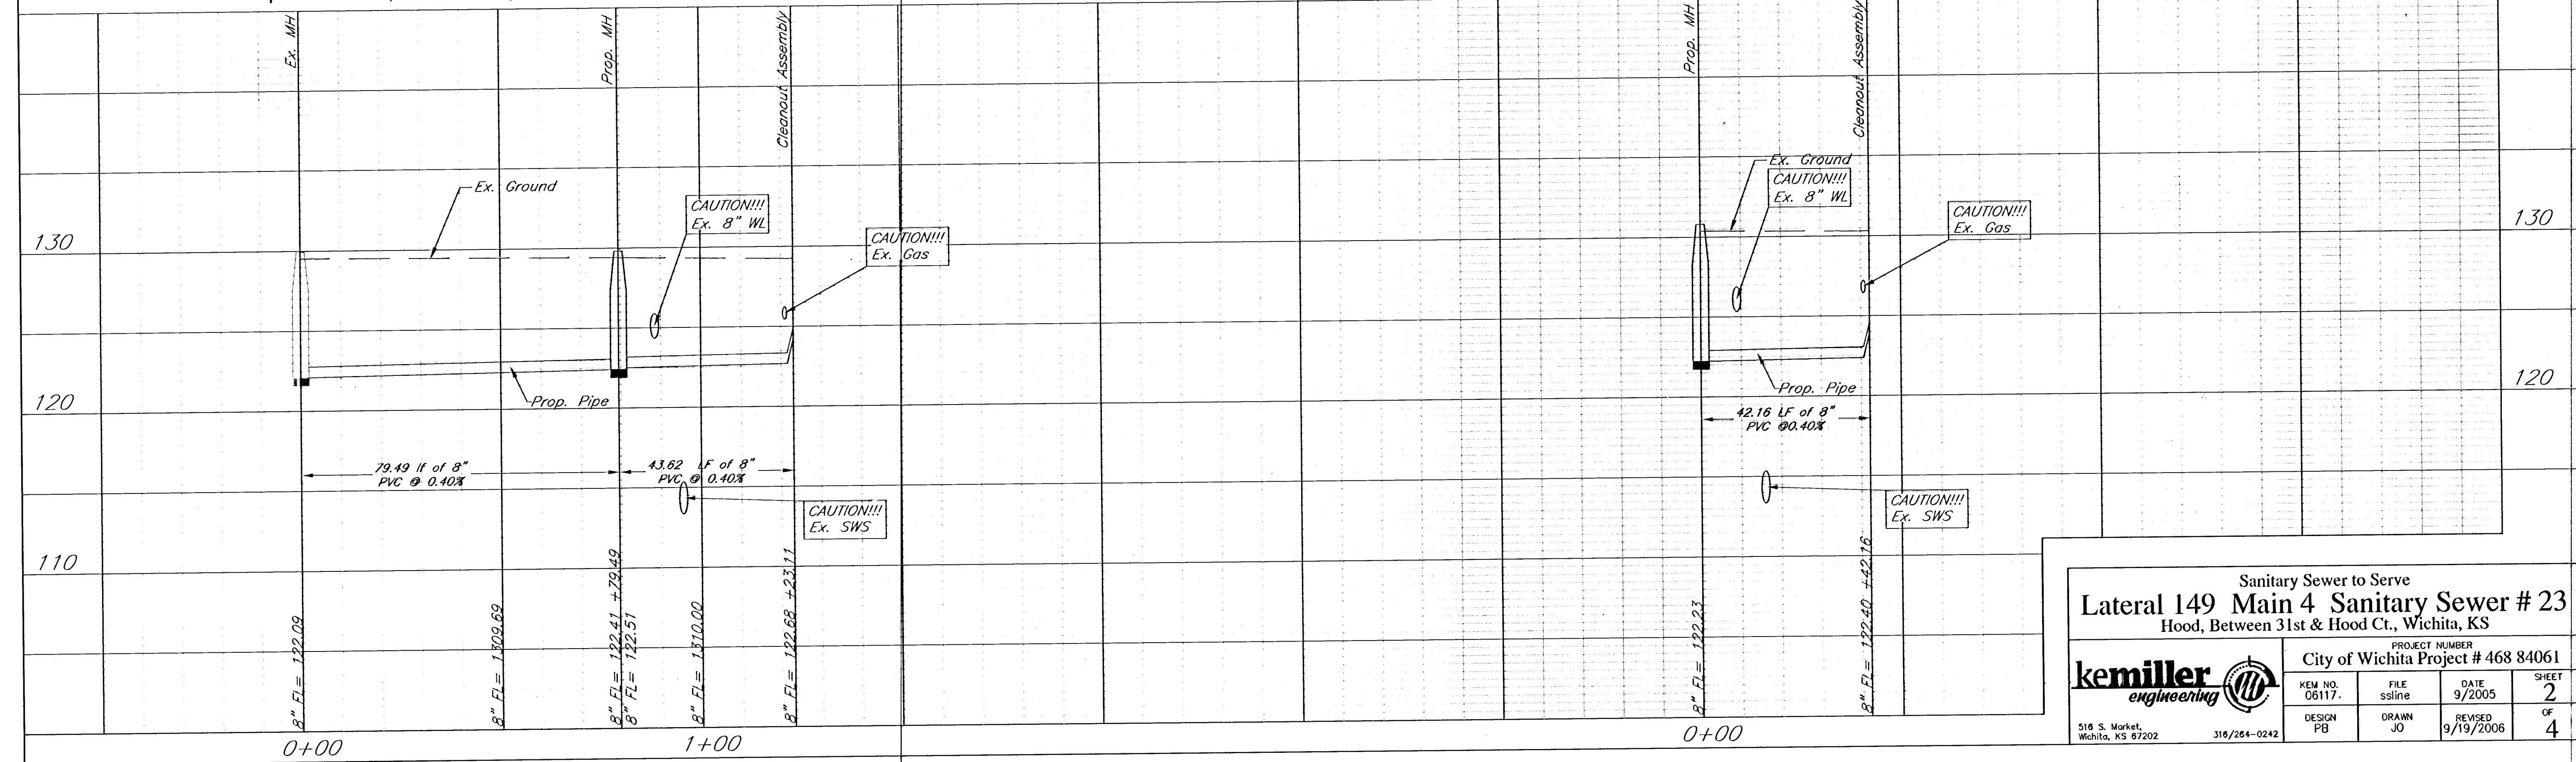
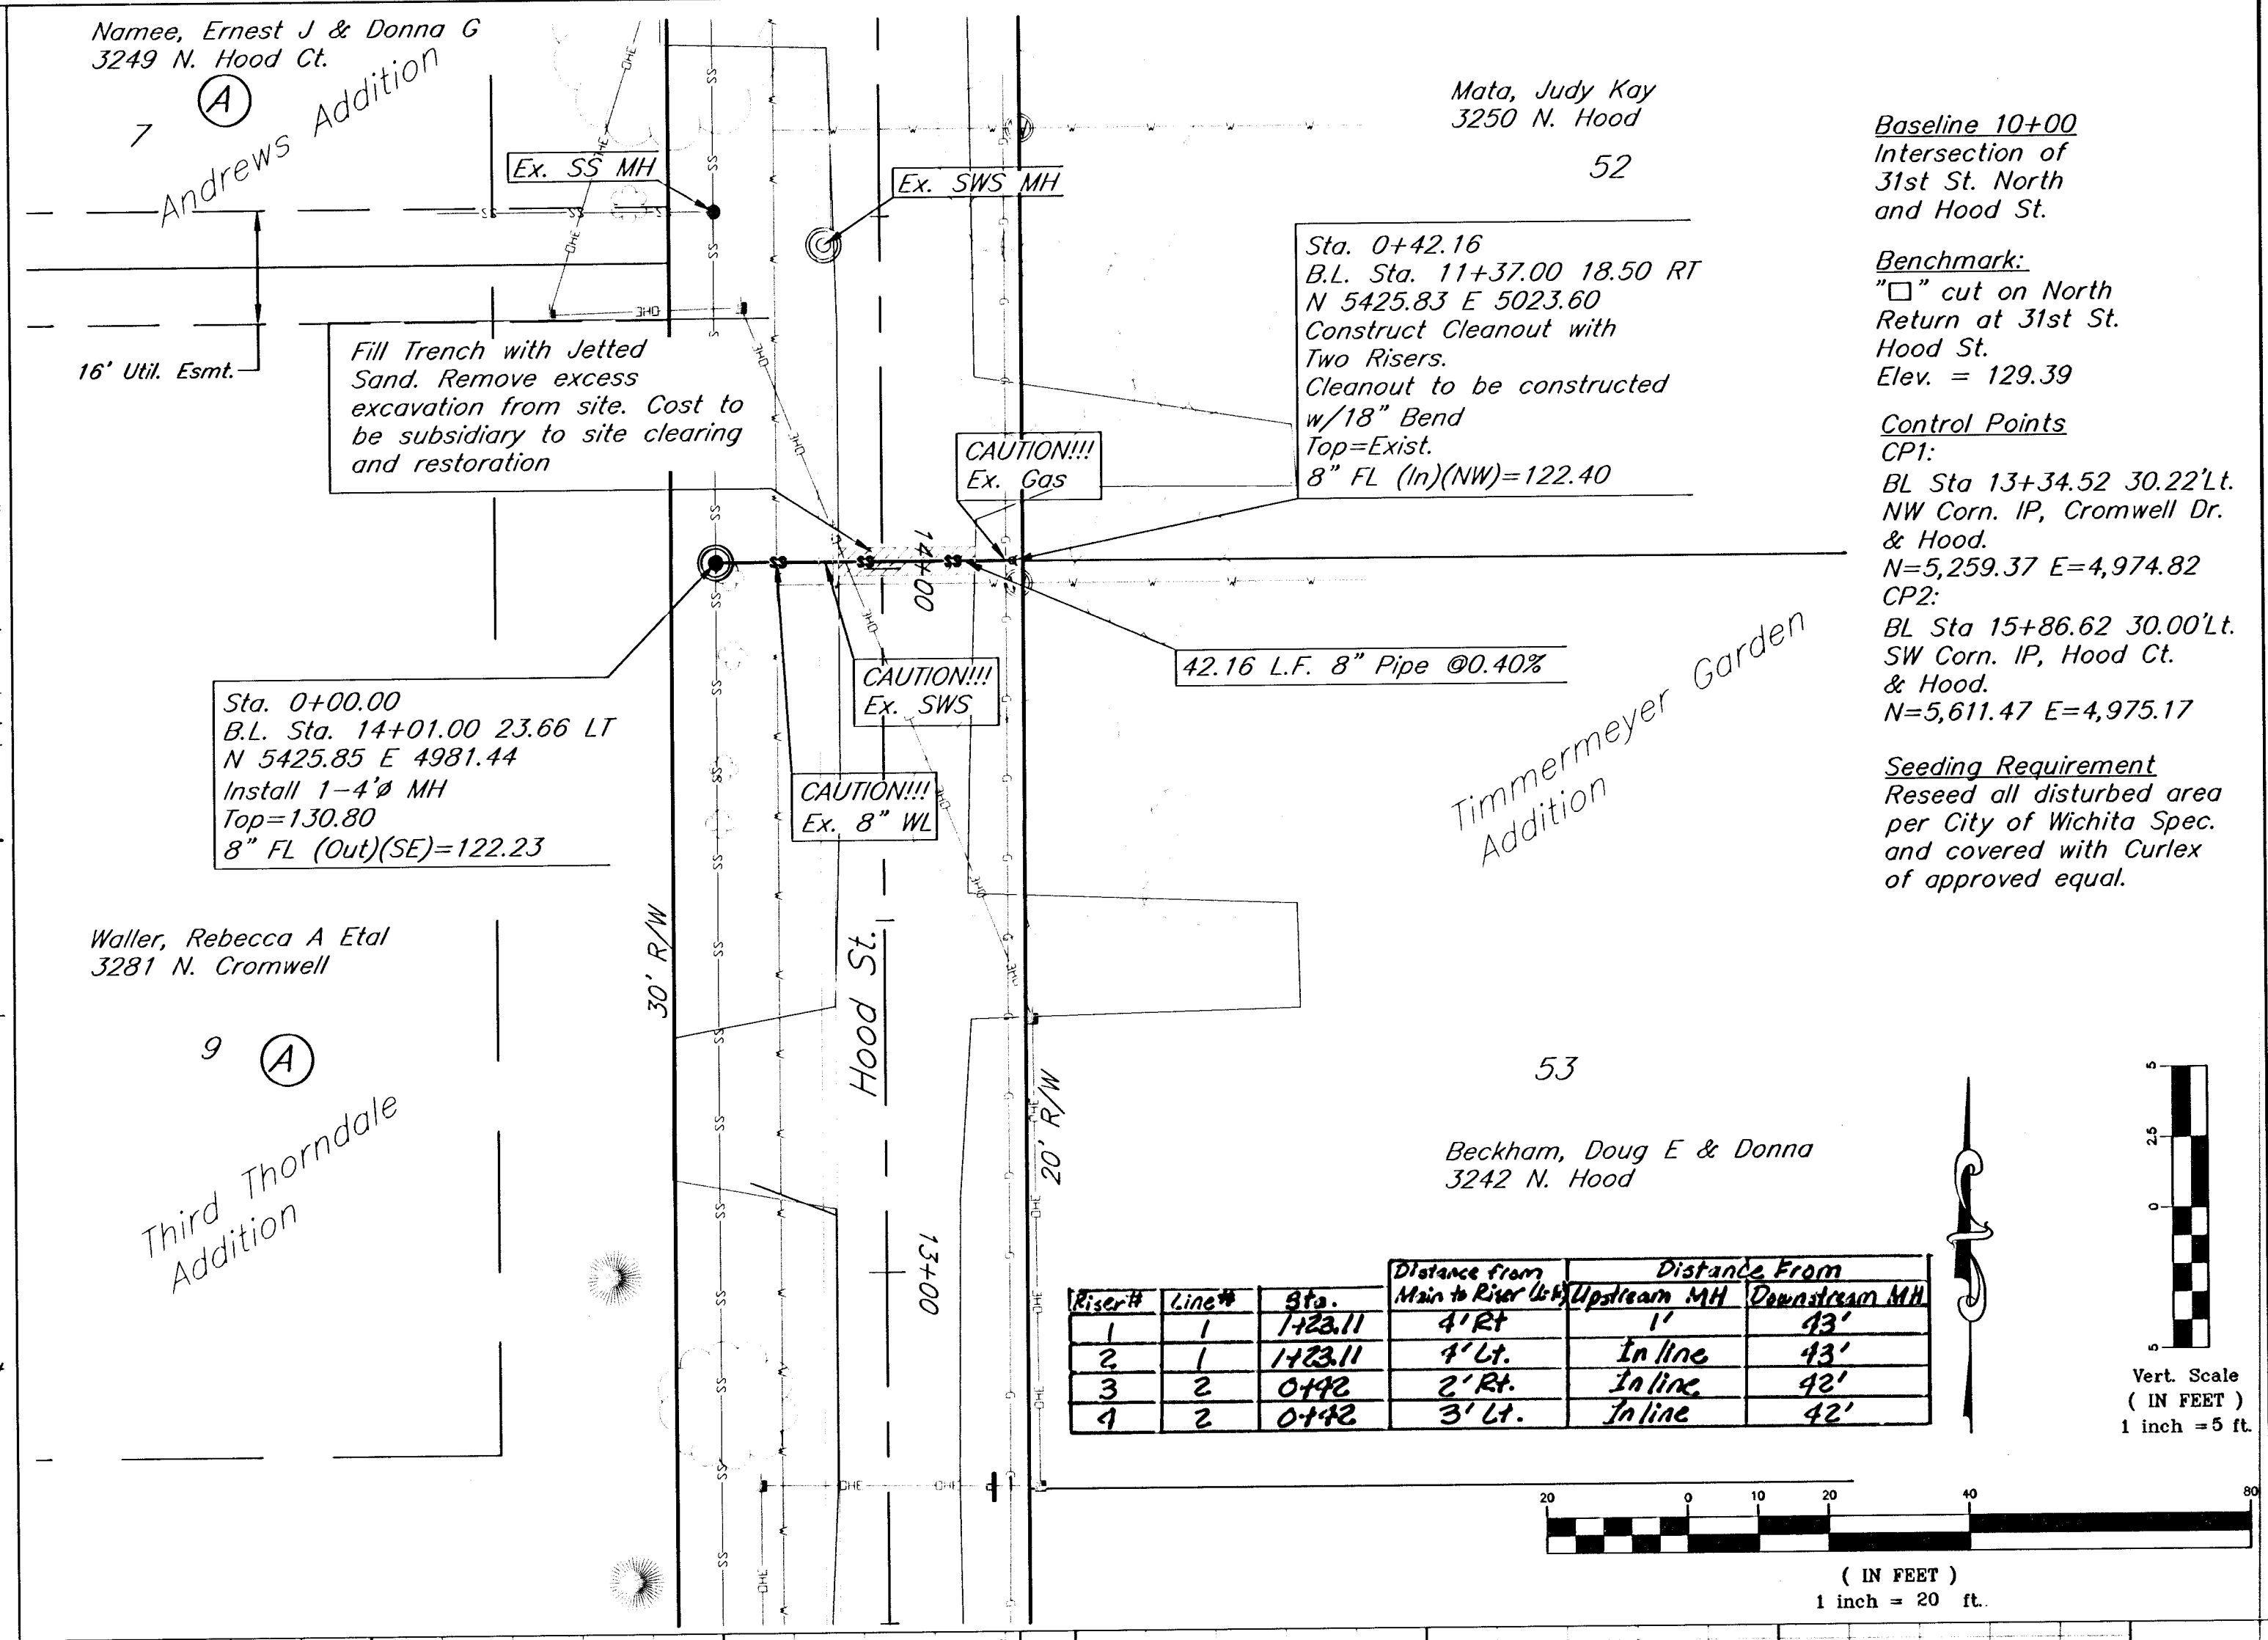


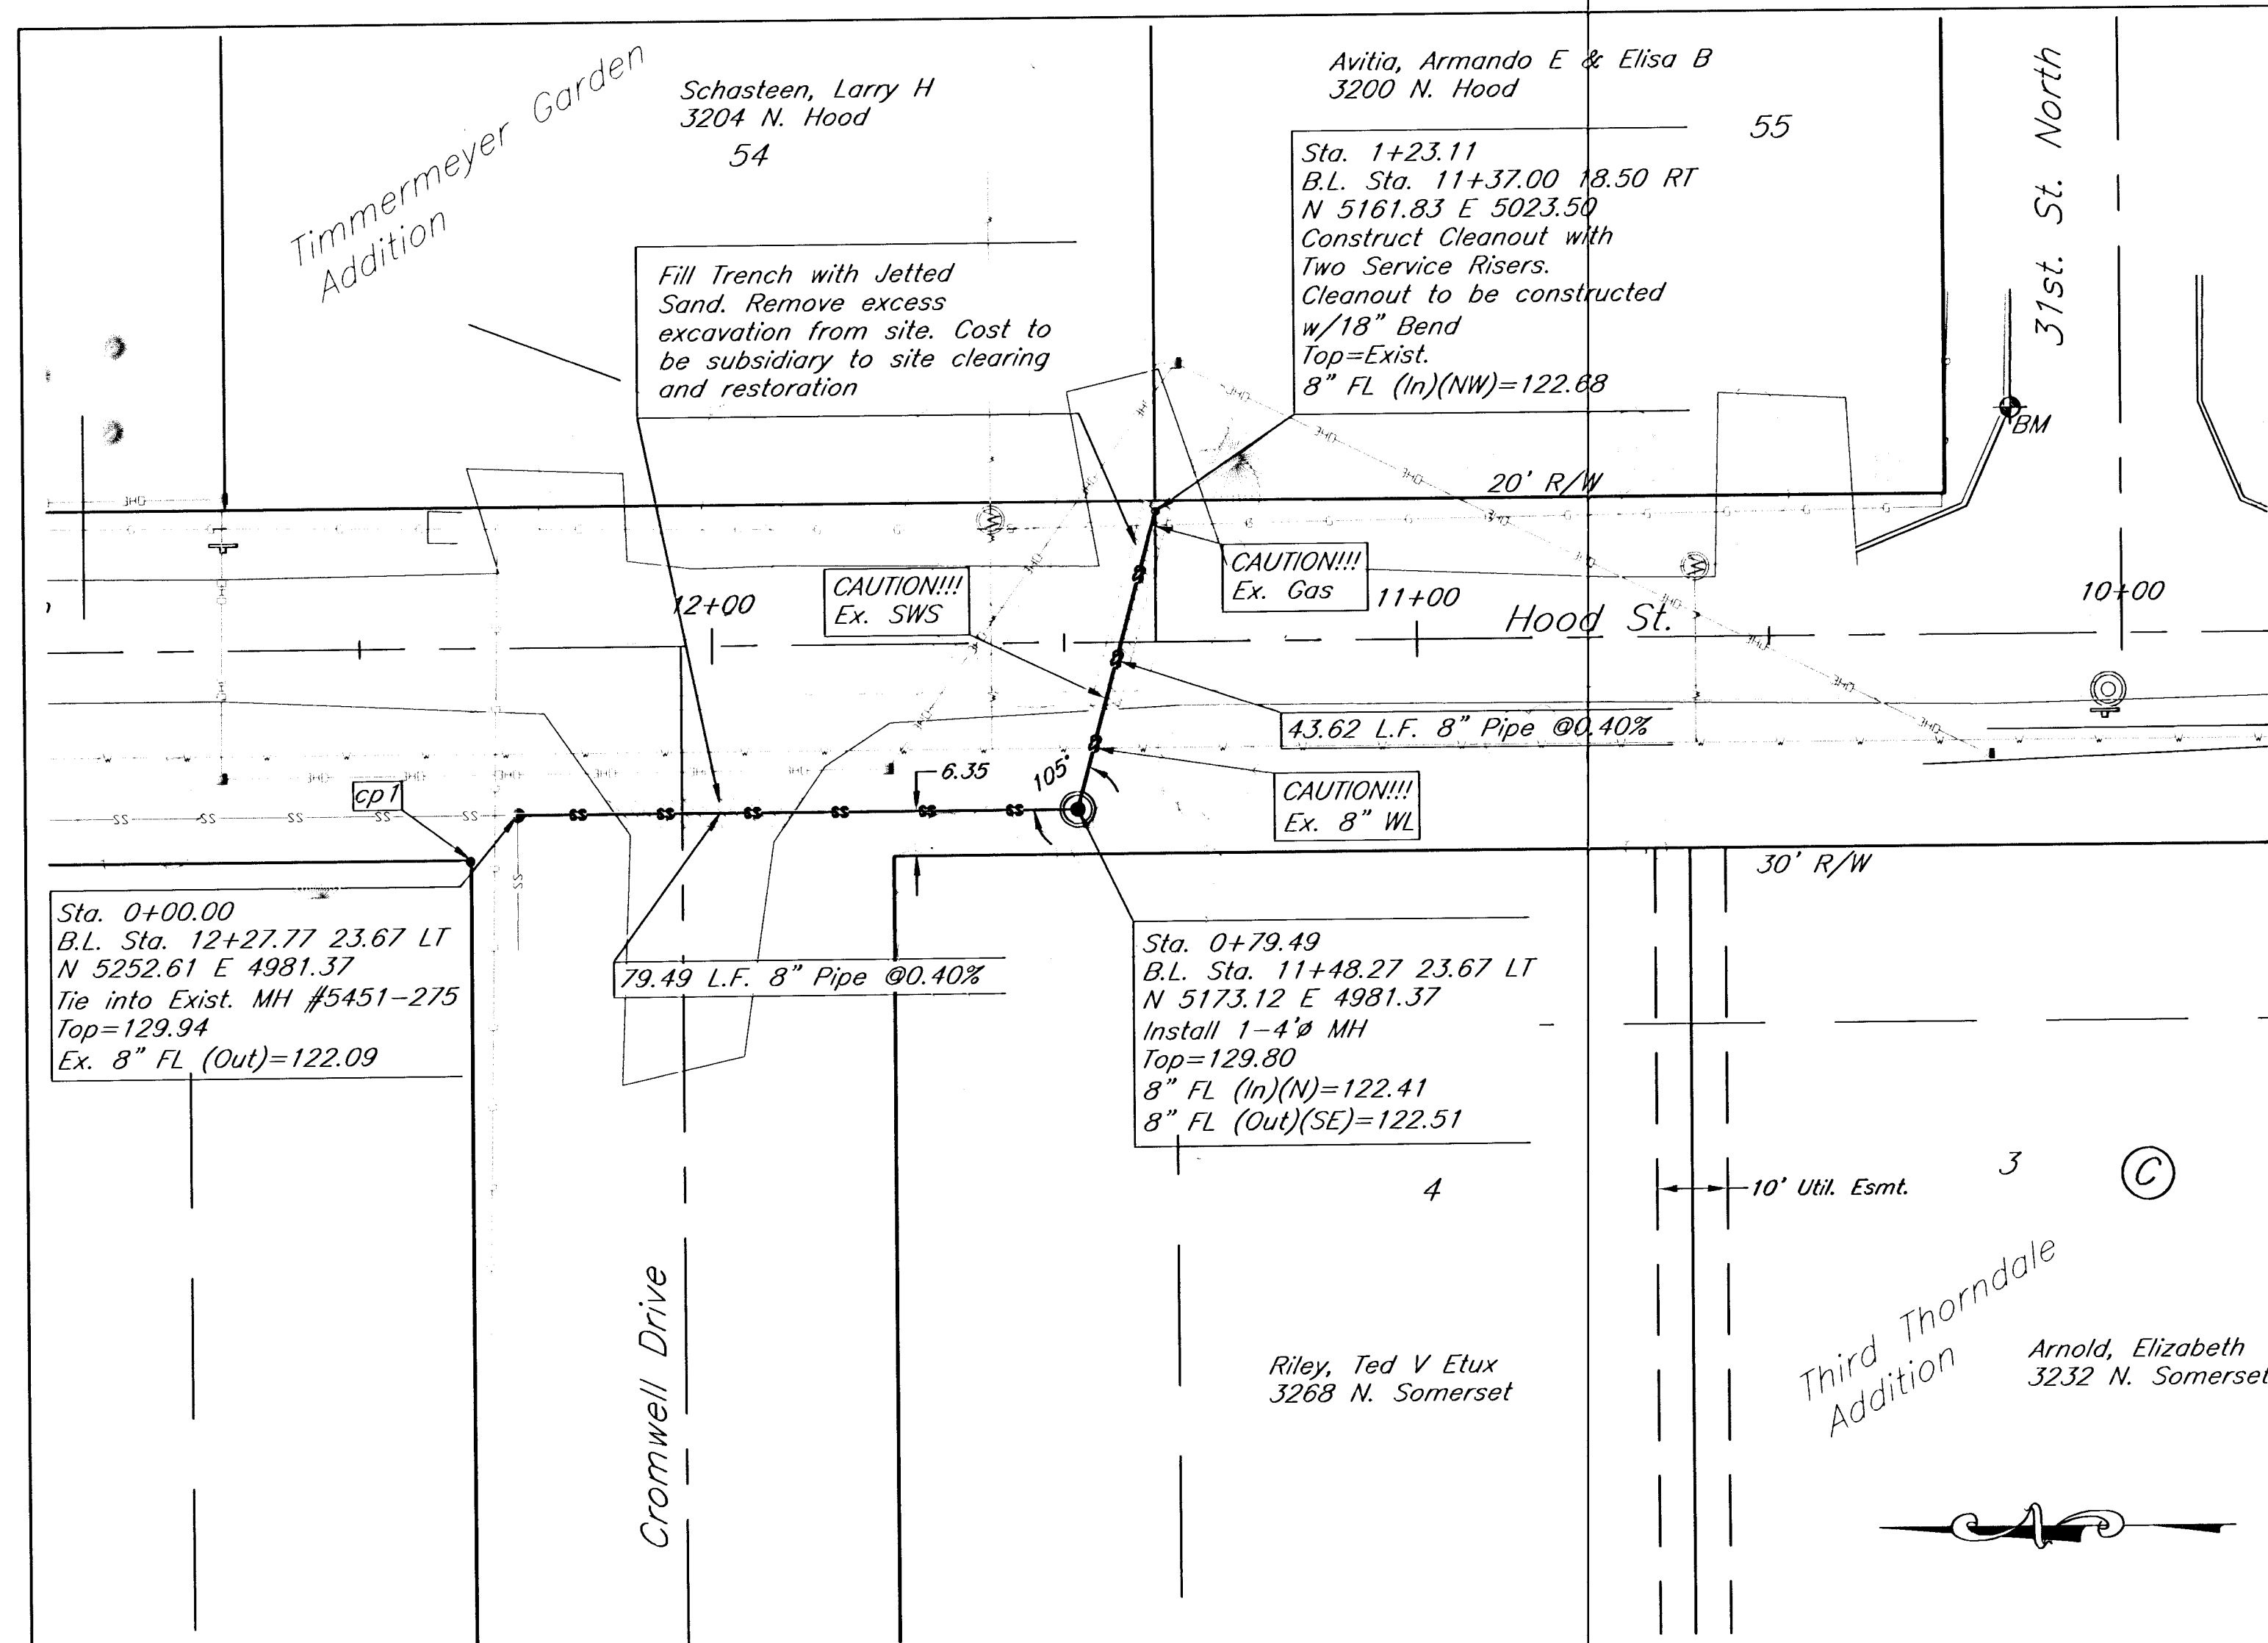

Sanitary Sewer to Serve
Lateral 149 Main 4 Sanitary Sewer # 23
 Hood, Between 31st & Hood Ct., Wichita, KS

PROJECT NUMBER
 City of Wichita Project # 468 84061

KEM NO. 06117.	FILE ssline	DATE 9/2005	SHEET 2 OF 4
DESIGN PB	DRAWN JO	REVISED 9/19/2006	

516 S. Market, Wichita, KS 67202 316/264-0242