


SEWER SERVICE TABLE


NUMBER	TYPE	LOCATION			FOR INFORMATION ONLY	
		LOT NO.	BLOCK NO.	LINE NO.	STATION\ DIRECTION	APPROXIMATE LENGTH 4\"/>
19	8" X 4" Tee Saddle	30	1	2	11+02.82/Rt.	7'
20	8" X 4" Tee Saddle	31	1	2	11+65.82/Rt.	7'
21	8" X 4" Tee Saddle	32	1	2	12+28.82/Rt.	7'

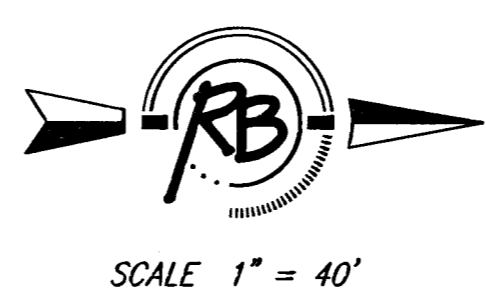

SCALE 1" = 40'




SCALE 1" = 40'

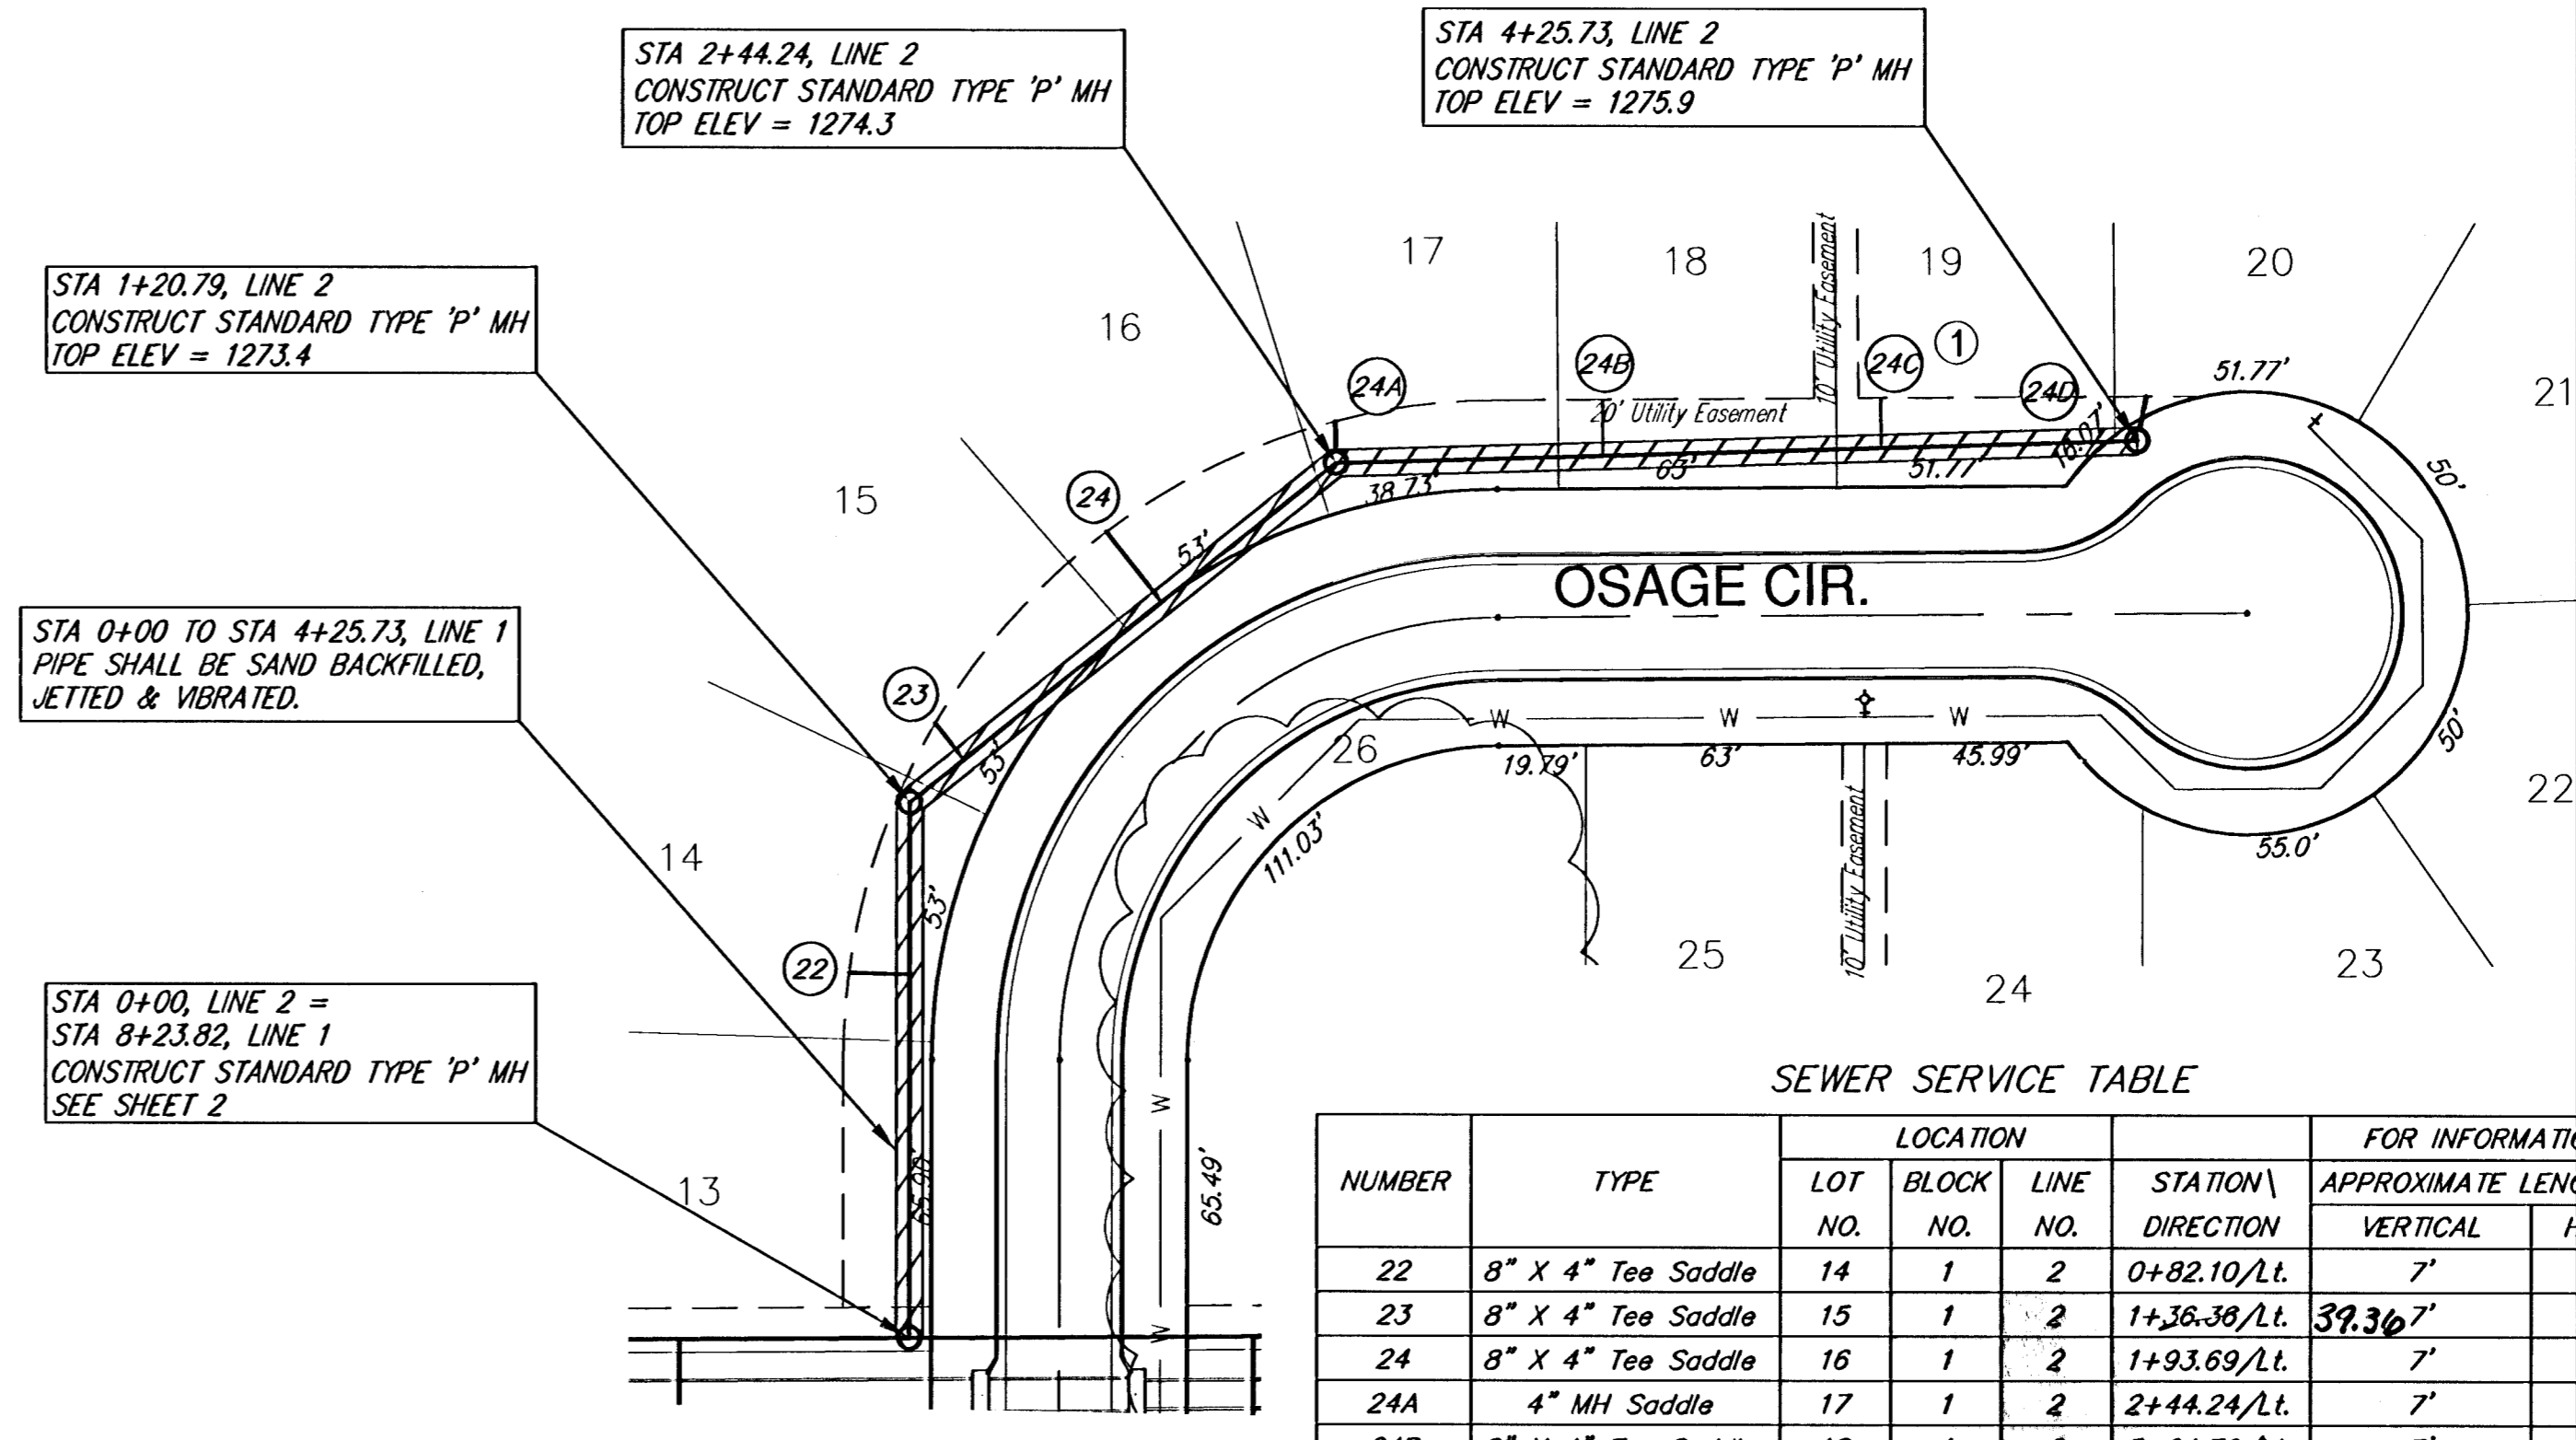


SEWER SERVICE TABLE


NUMBER	TYPE	LOCATION			FOR INFORMATION ONLY	
		LOT NO.	BLOCK NO.	LINE NO.	STATION\ DIRECTION	APPROXIMATE LENGTH 4\"/>
22	8" X 4" Tee Saddle	14	1	2	0+82.10/Lt.	7'
23	8" X 4" Tee Saddle	15	1	2	1+38.38/Lt.	39.36'
24	8" X 4" Tee Saddle	16	1	2	1+93.69/Lt.	7'
24A	4" MH Saddle	17	1	2	2+44.24/Lt.	7'
24B	8" X 4" Tee Saddle	18	1	2	3+04.70/Lt.	7'
24C	8" X 4" Tee Saddle	19	1	2	3+67.72/Lt.	7'
24D	4" MH Saddle	20	1	2	4+25.73/Lt.	7'

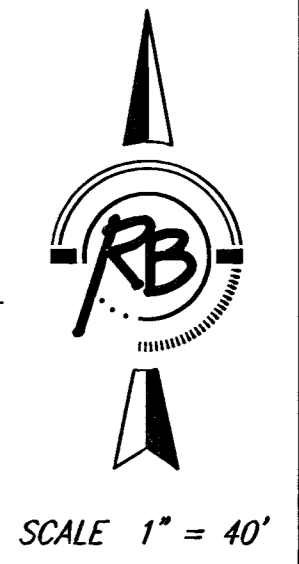

SCALE 1" = 40'

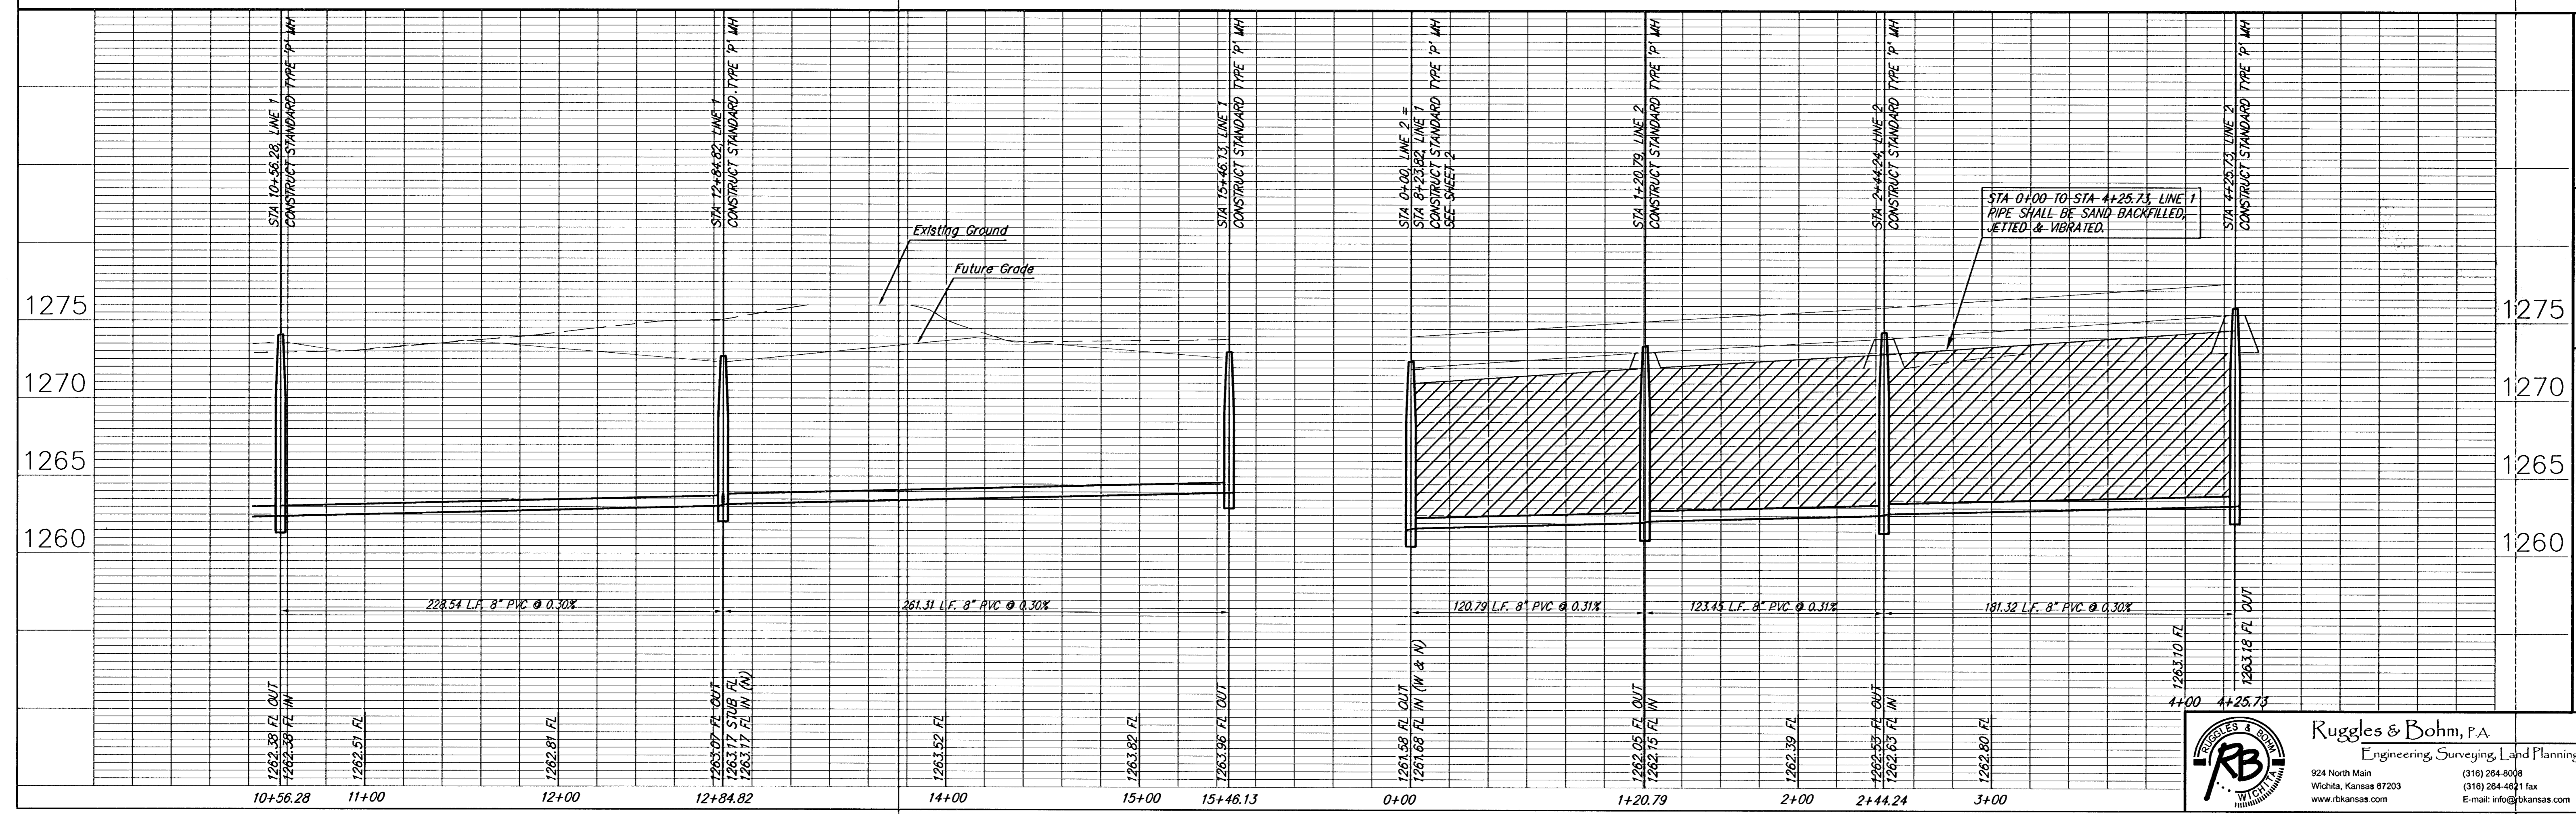

PROJECT NUMBER 488-9491	DESIGN EJC	DRAWING FILE SS (SS Line 1)	REVISION DATE May 25, 2006
Sycamore Pond Sanitary Sewer Line 1 WICHITA, KANSAS			RB JOB 2877E SHEET 3 OF 13

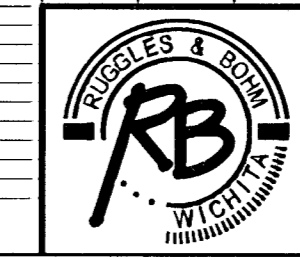

Ruggles & Bohm, P.A.
Engineering, Surveying, Land Planning
924 North Main
Wichita, Kansas 67203
www.rbkansas.com
(316) 264-8038
(316) 264-4621 fax
E-mail: info@rbkansas.com