



Brass plate on the NE wingwall of Arkansas
River bridge & 63rd St. S.
Elev. = 1267.48 NGVD29 (per County record)

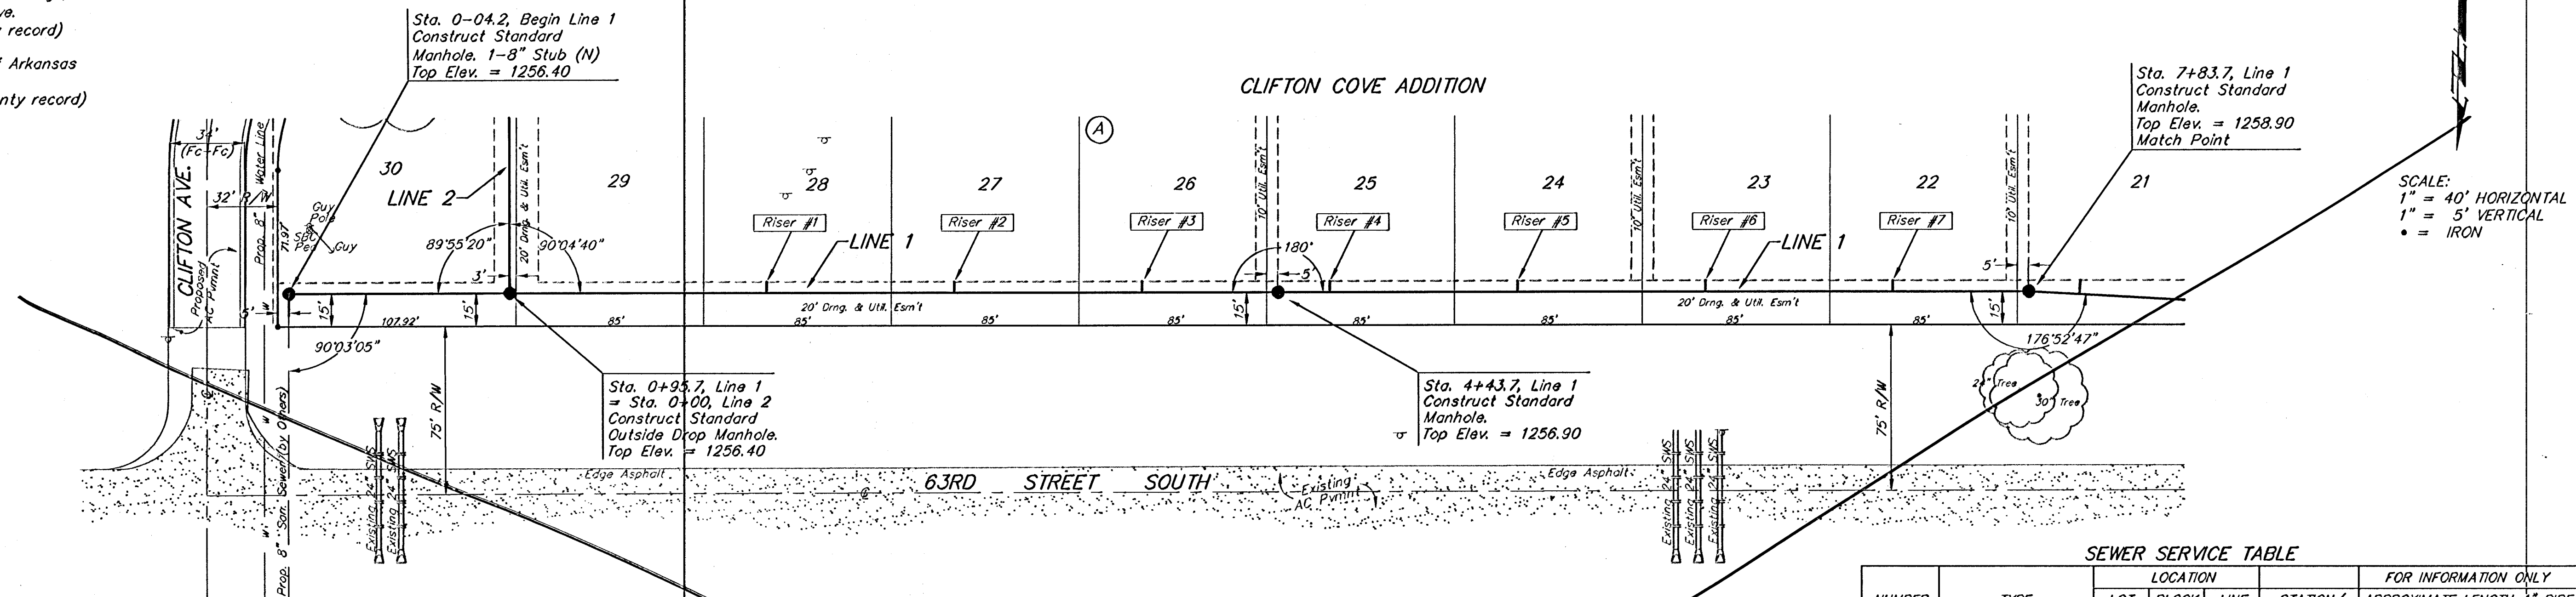

SEE
REVISED
SHEET

NUMBER	TYPE	LOCATION			FOR INFORMATION ONLY		
		LOT NO.	BLOCK NO.	LINE NO.	STATION/ DIRECTION	APPROXIMATE LENGTH 4" PIPE	
						VERTICAL	HORIZONTAL
1	8" X 4" Tee Saddle	28	A	1	2+11/Lt.	11'	3'
2	8" X 4" Tee Saddle	27	A	1	2+97/Lt.	11'	3'
3	8" X 4" Tee Saddle	26	A	1	3+82/Lt.	11'	3'
4	8" X 4" Tee Saddle	25	A	1	4+67/Lt.	11'	3'
5	8" X 4" Tee Saddle	24	A	1	5+52/Lt.	10.5'	3'
6	8" X 4" Tee Saddle	23	A	1	6+37/Lt.	9.5'	3'
7	8" X 4" Tee Saddle	22	A	1	7+22/Lt.	9'	3'

NOTE: Vertical Riser Pipe shall be extended to 2' minimum above ground water elevation and 4' maximum below proposed ground elevation.

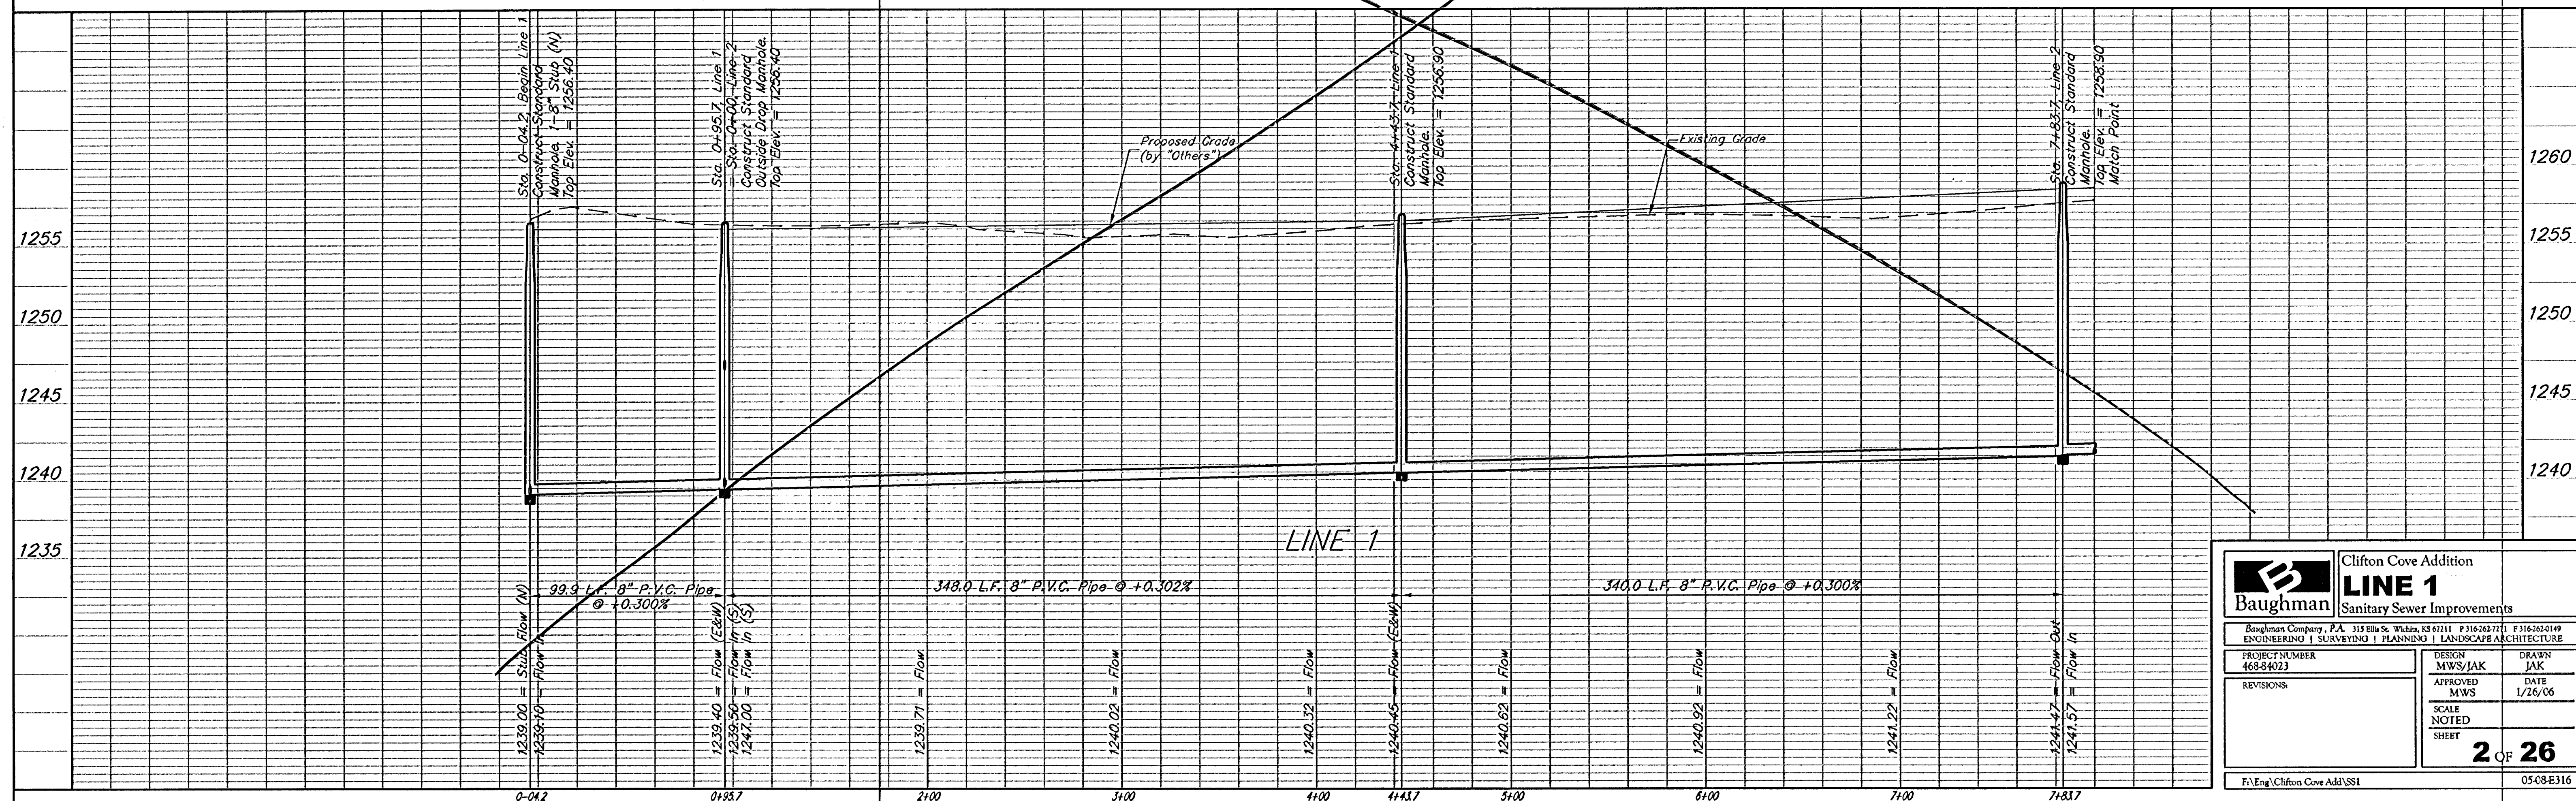

 Baughman Engineering	Clifton Cove Addition LINE 1 Sanitary Sewer Improvements	
PROJECT NUMBER 468-84023	DESIGN MWS/JAK	DRAWN JAK
REVISIONS:	APPROVED MWS	DATE 1/26/06
	SCALE NOTED	
	SHEET	2 OF 26
F:\Eng\Clifton Cove Add\SS1		05-08-E316