


BENCHMARK:
Arkansas River bridge & 63rd St. S. City of
Wichita Benchmark Disc. SW Cor. of bridge,
top of hubguard, 500'± E. of Grove.
Elev. = 1269.95 NGVD29 (per City record)


Brass plate on the NE wingwall of Arkansas
River bridge & 63rd St. S.
Elev. = 1267.48 NGVD29 (per County record)

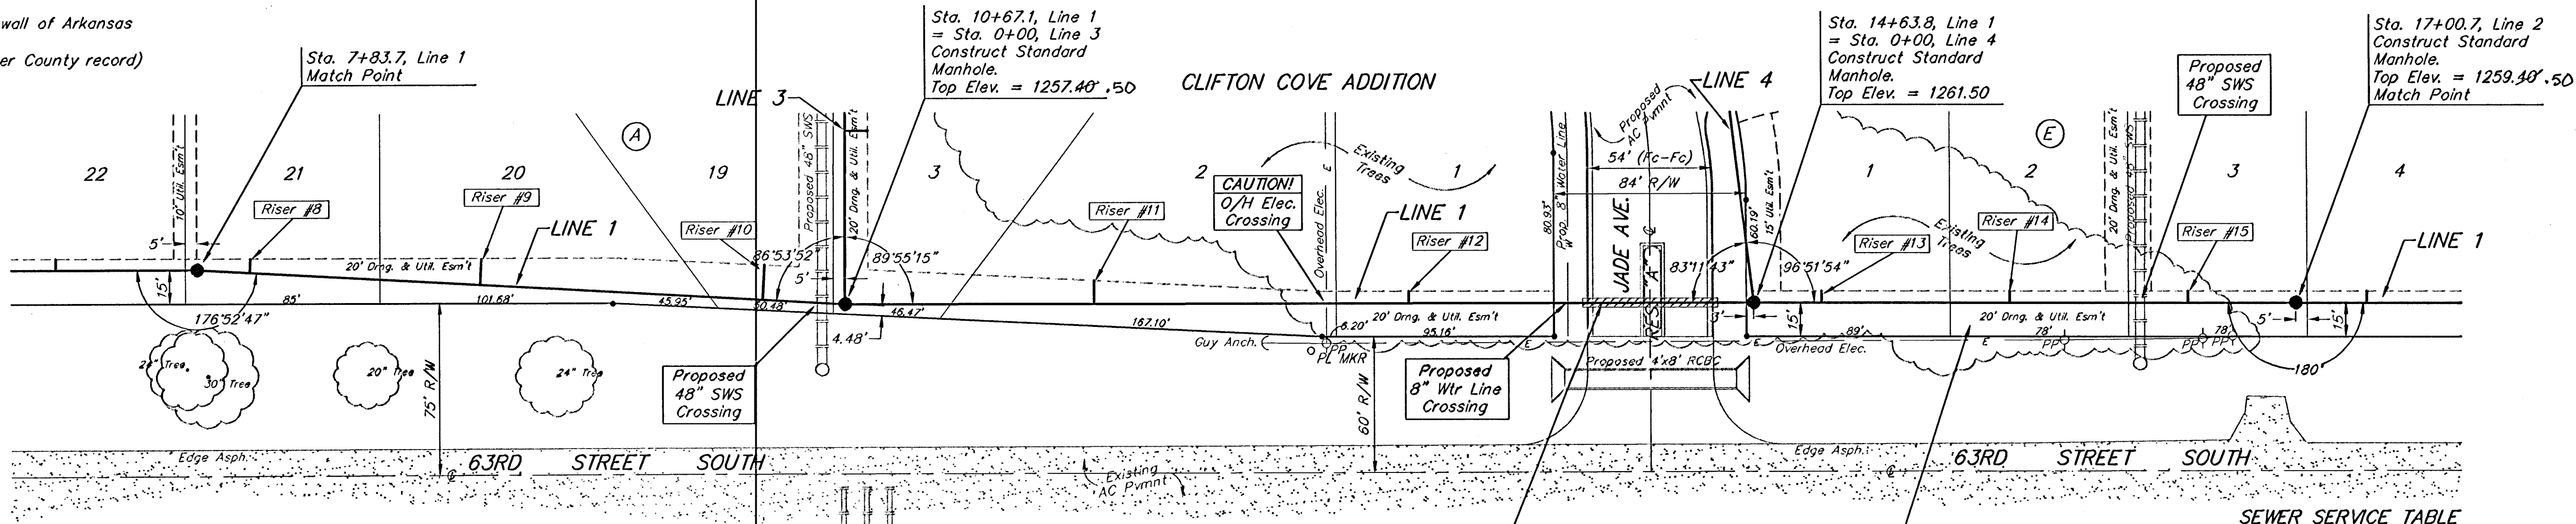

SCALE:
1" = 40' HORIZONTAL
1" = 5' VERTICAL
• = IRON

NUMBER	TYPE	LOCATION				FOR INFORMATION ONLY	
		LOT NO.	BLOCK NO.	LINE NO.	STATION/DIRECTION	APPROXIMATE LENGTH 4" PIPE	
8	8" X 4" Tee Saddle	21	A	1	8+07/Lt.	29.2	12'
9	8" X 4" Tee Saddle	20	A	1	9+07/Lt.	10.2	12'
10	8" X 4" Tee Saddle	19	A	1	10+37/Lt.	32.7	10'
11	8" X 4" Tee Saddle	2	A	1	11+78/Lt.	78.5	8.5'
12	8" X 4" Tee Saddle	1	A	1	13+33/Lt.	13.5	9'
13	8" X 4" Tee Saddle	1	E	1	14+94/Lt.	46.5	11'
14	8" X 4" Tee Saddle	2	E	1	15+78/Lt.	74	9'
15	8" X 4" Tee Saddle	3	E	1	16+54/Lt.	55.5	8'

NOTE: Vertical Riser Pipe shall be extended to 2' minimum above ground water elevation and 4' maximum below proposed ground elevation.

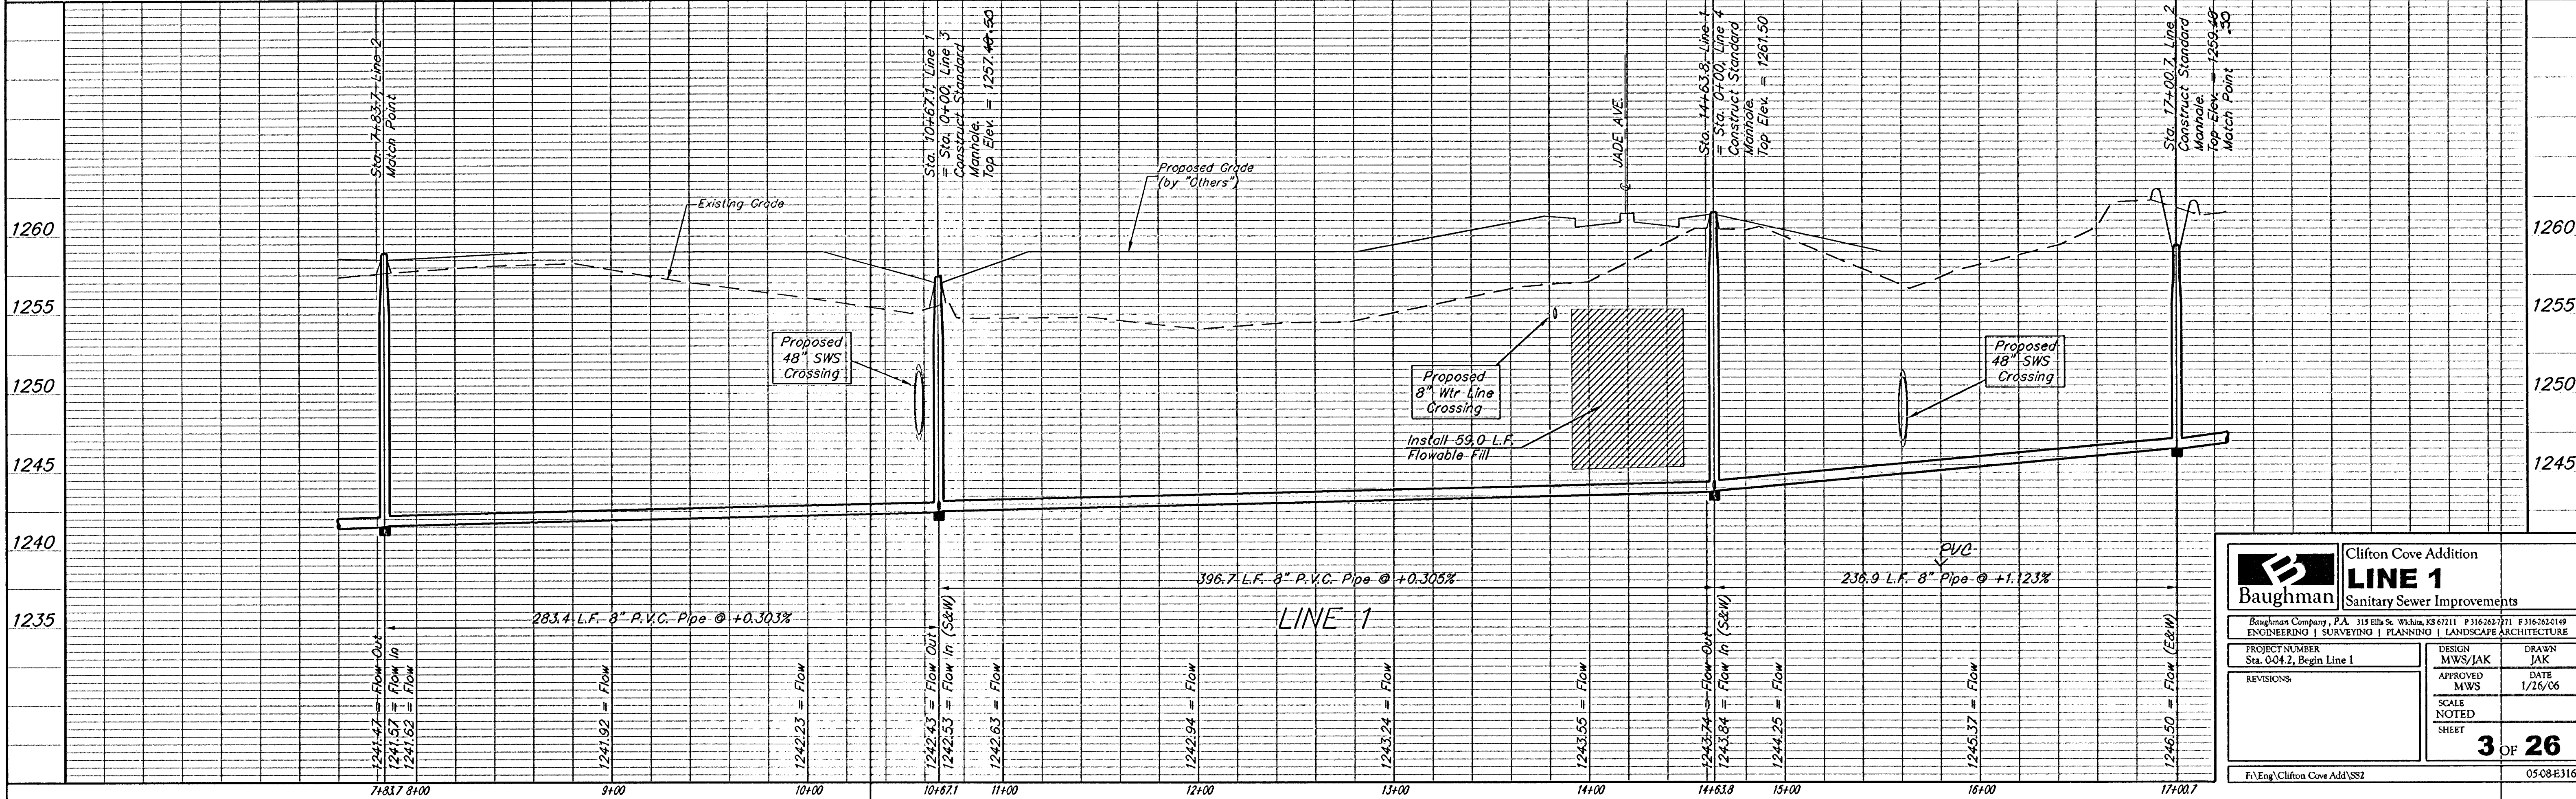

Baughman

Clifton Cove Addition
LINE 1
Sanitary Sewer Improvements

Baughman Company, P.A. 315 Ellis St. Wichita, KS 67211 P 316.262.7711 F 316.262.0149
ENGINEERING | SURVEYING | PLANNING | LANDSCAPE ARCHITECTURE

PROJECT NUMBER
Sta. 004.2, Begin Line 1

DESIGN
MWS/JAK

DRAWN
JAK

REVISIONS:

APPROVED
MWS

DATE
1/26/06

SCALE
NOTED
SHEET

3 OF 26

En'g. Clifton Cove Addn SS2

0508E316