

BENCHMARK:
Arkansas River bridge & 63rd St. S. City of
Wichita Benchmark Disc. SW Cor. of bridge,
top of hubguard, 500'± E. of Grove.
Elev. = 1269.95 NGVD29 (per City record)

Brass plate on the NE wingwall of Arkansas
River bridge & 63rd St. S.
Elev. = 1267.48 NGVD29 (per County record)

Remove Existing Trees Only
as Necessary for Construction.
Cost to be Included in Bid Item
"Site Clearing & Restoration"

Proposed
8" Wtr Line
Crossing

CLIFTON COVE ADDITION

Sta. 1+54.4 to Sta. 1+93.4
Install 39.0 L.F. Flowable Fill
Per City Specifications.
Fill to Elev. 1255.50

Sta. 3+53.9, Line 2
= Sta. 0+00, Line 2A
Construct Standard
Manhole.
Top Elev. = 1258.80

Sta. 4+22.6, Line 2
Construct Standard
Manhole.
Top Elev. = 1258.50


Sta. 5+34.5, End Line 2
Construct Standard
Manhole. 1'-4" Stub (NE)
Top Elev. = 1258.50

SCALE:
1" = 40' HORIZONTAL
1" = 5' VERTICAL
• = IRON

Sta. 0+00, Begin Line 2
= Sta. 0+95.7, Line 1

SEE
REVISED
SHEET

The Contractor shall be required to
backfill trench with sand from Sta. 1+93.4
to Sta. 5+34.5, Line 2. To be bid as "L.F.
Sand Backfill Jetted and Vibrated"

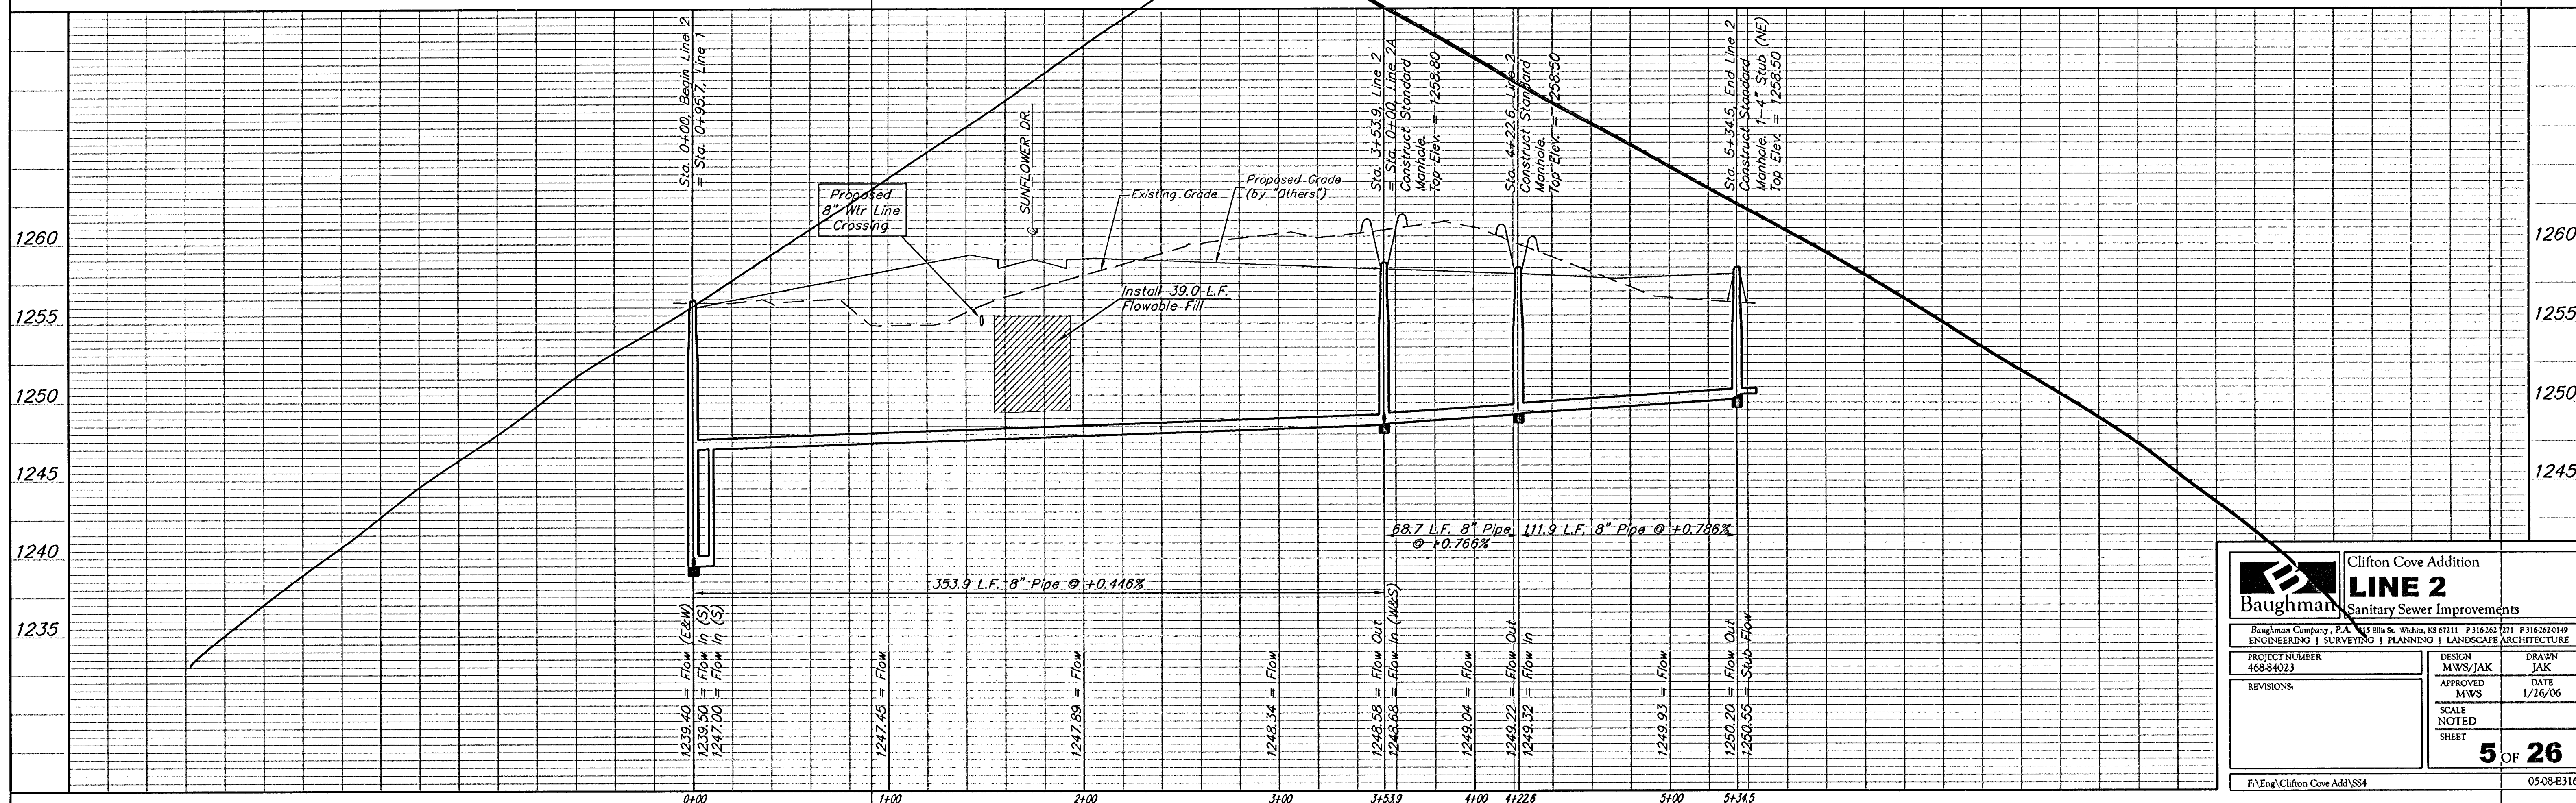

Baughman		Clifton Cove Addition	
LINE 2		Sanitary Sewer Improvements	
Baughman Company, P.A. 1515 S. Hill St., Wichita, KS 67211 P 316.262.0711 F 316.262.0149 ENGINEERING SURVEYING PLANNING LANDSCAPE ARCHITECTURE			
PROJECT NUMBER 468-84023	DESIGN MWS/JAK	DRAWN JAK	DATE 1/26/06
REVISIONS:	APPROVED MWS	SCALE NOTED	SHEET
5 OF 26			
F:\Eng\Clifton Cove Add\SS4			0508E316