


BENCHMARK:
Arkansas River bridge & 63rd St. S. City of
Wichita Benchmark Disc. SW Cor. of bridge,
top of hubguard. 500'± E. of Grove.
Elev. = 1269.95 NGVD29 (per City record)


Brass plate on the NE wingwall of Arkansas
River bridge & 63rd St. S.
Elev. = 1267.48 NGVD29 (per County record)

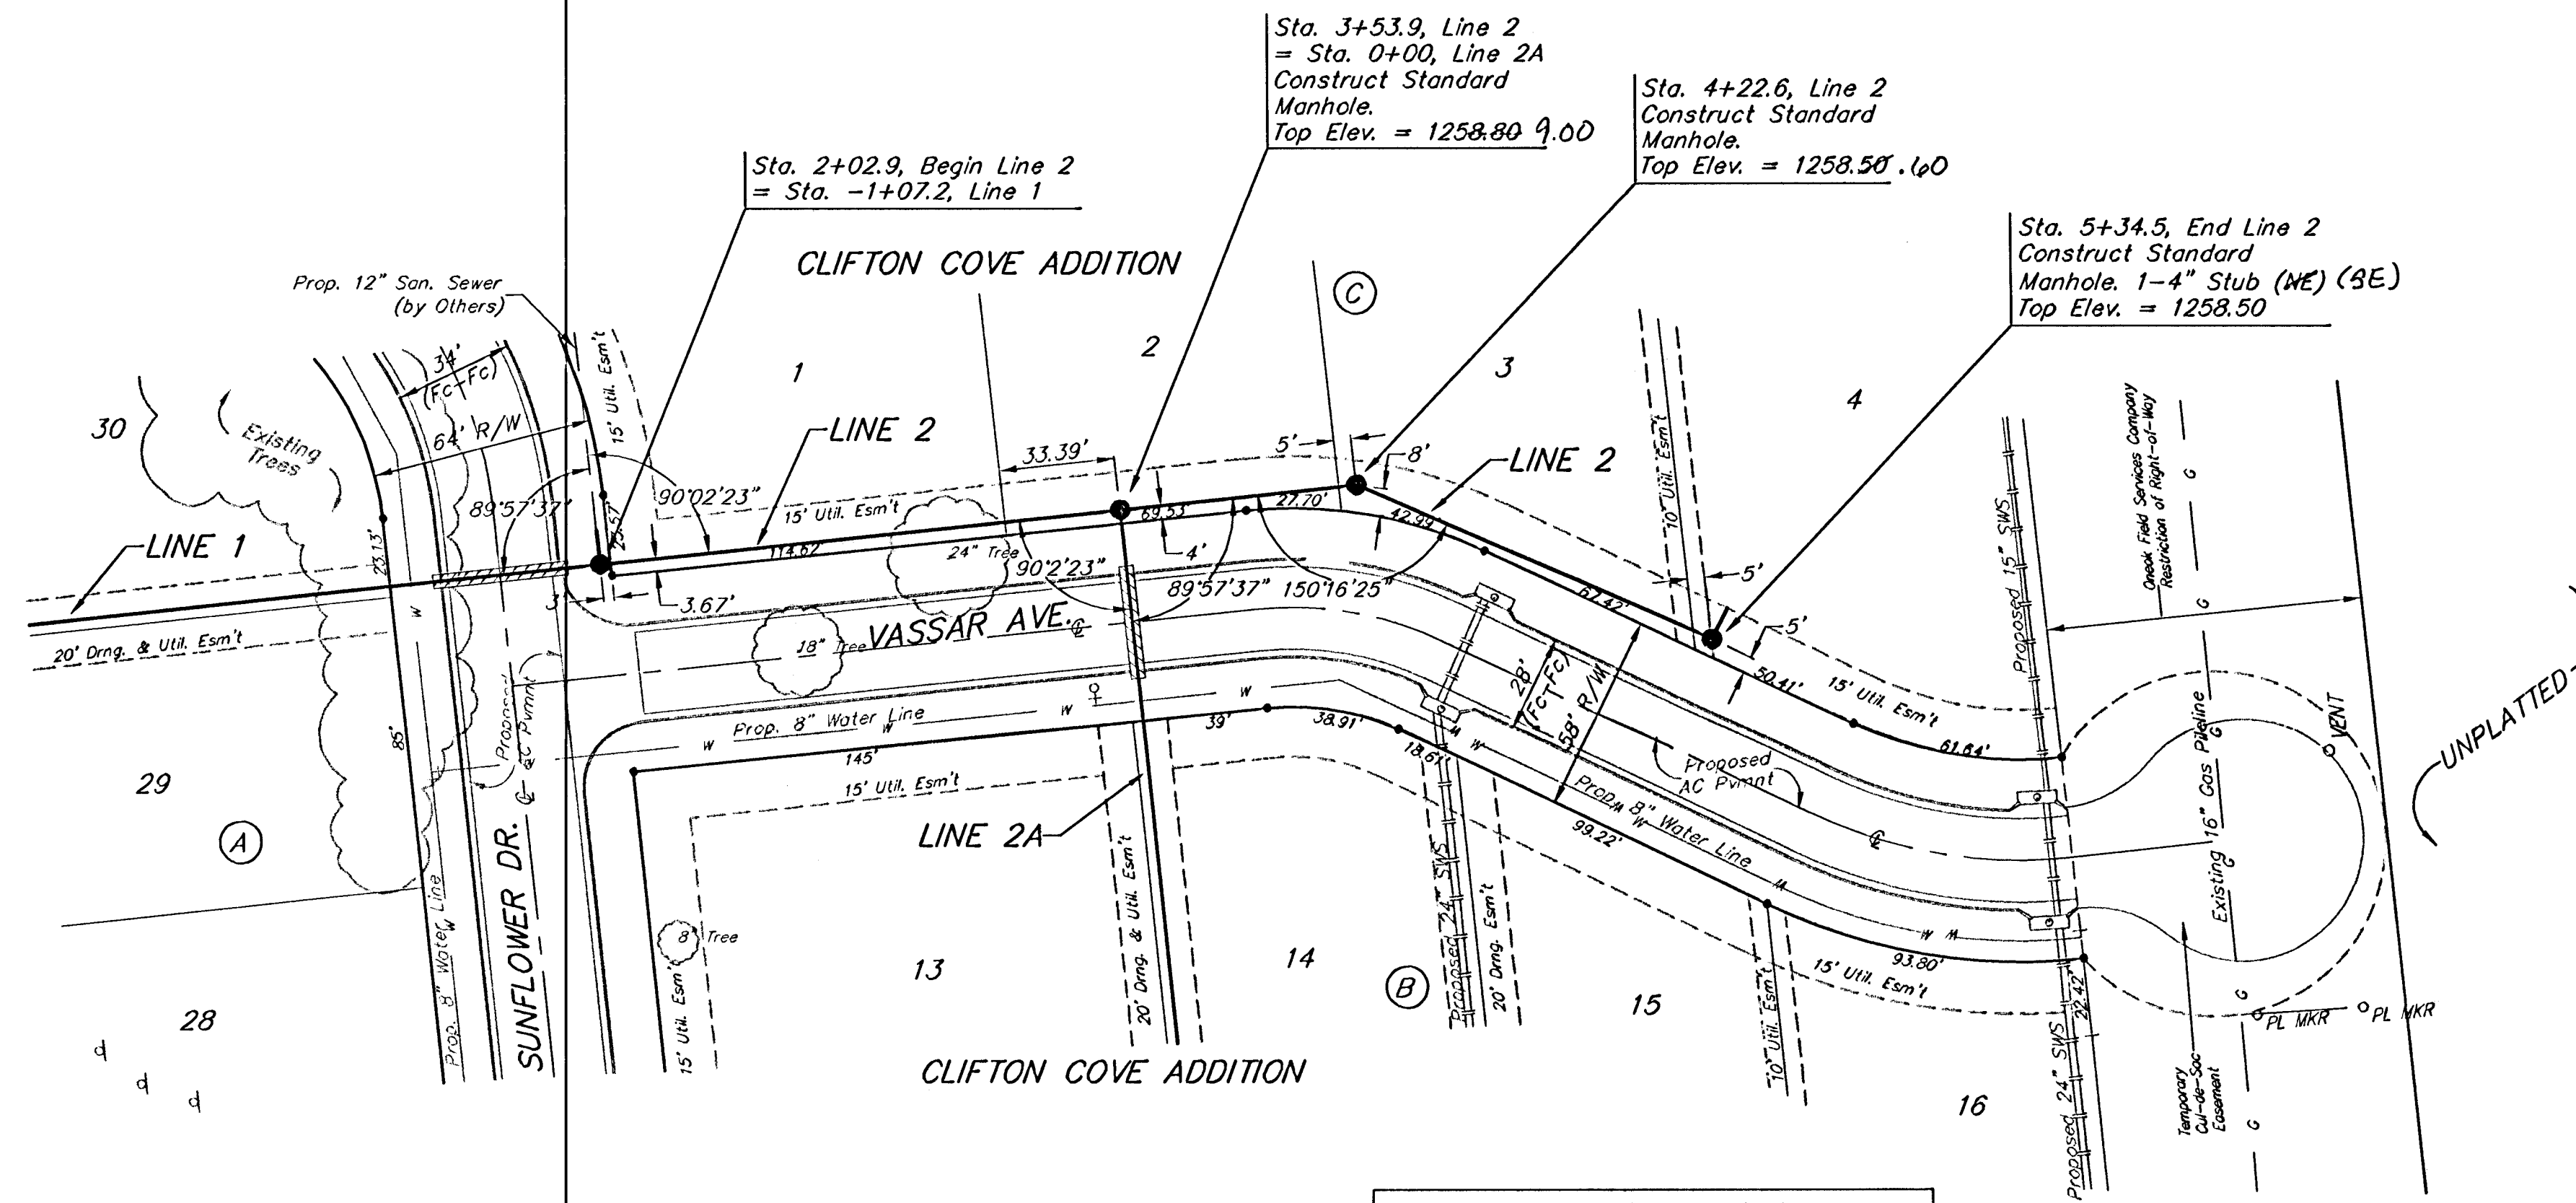

The Contractor shall be required to
backfill trench with sand from Sta. 2+02.9
to Sta. 5+34.5, Line 2. To be bid as
"L.F. Sand Backfill Jetted and Vibrated"



SCALE:
1" = 40' HORIZONTAL
1" = 5' VERTICAL
• = IRON

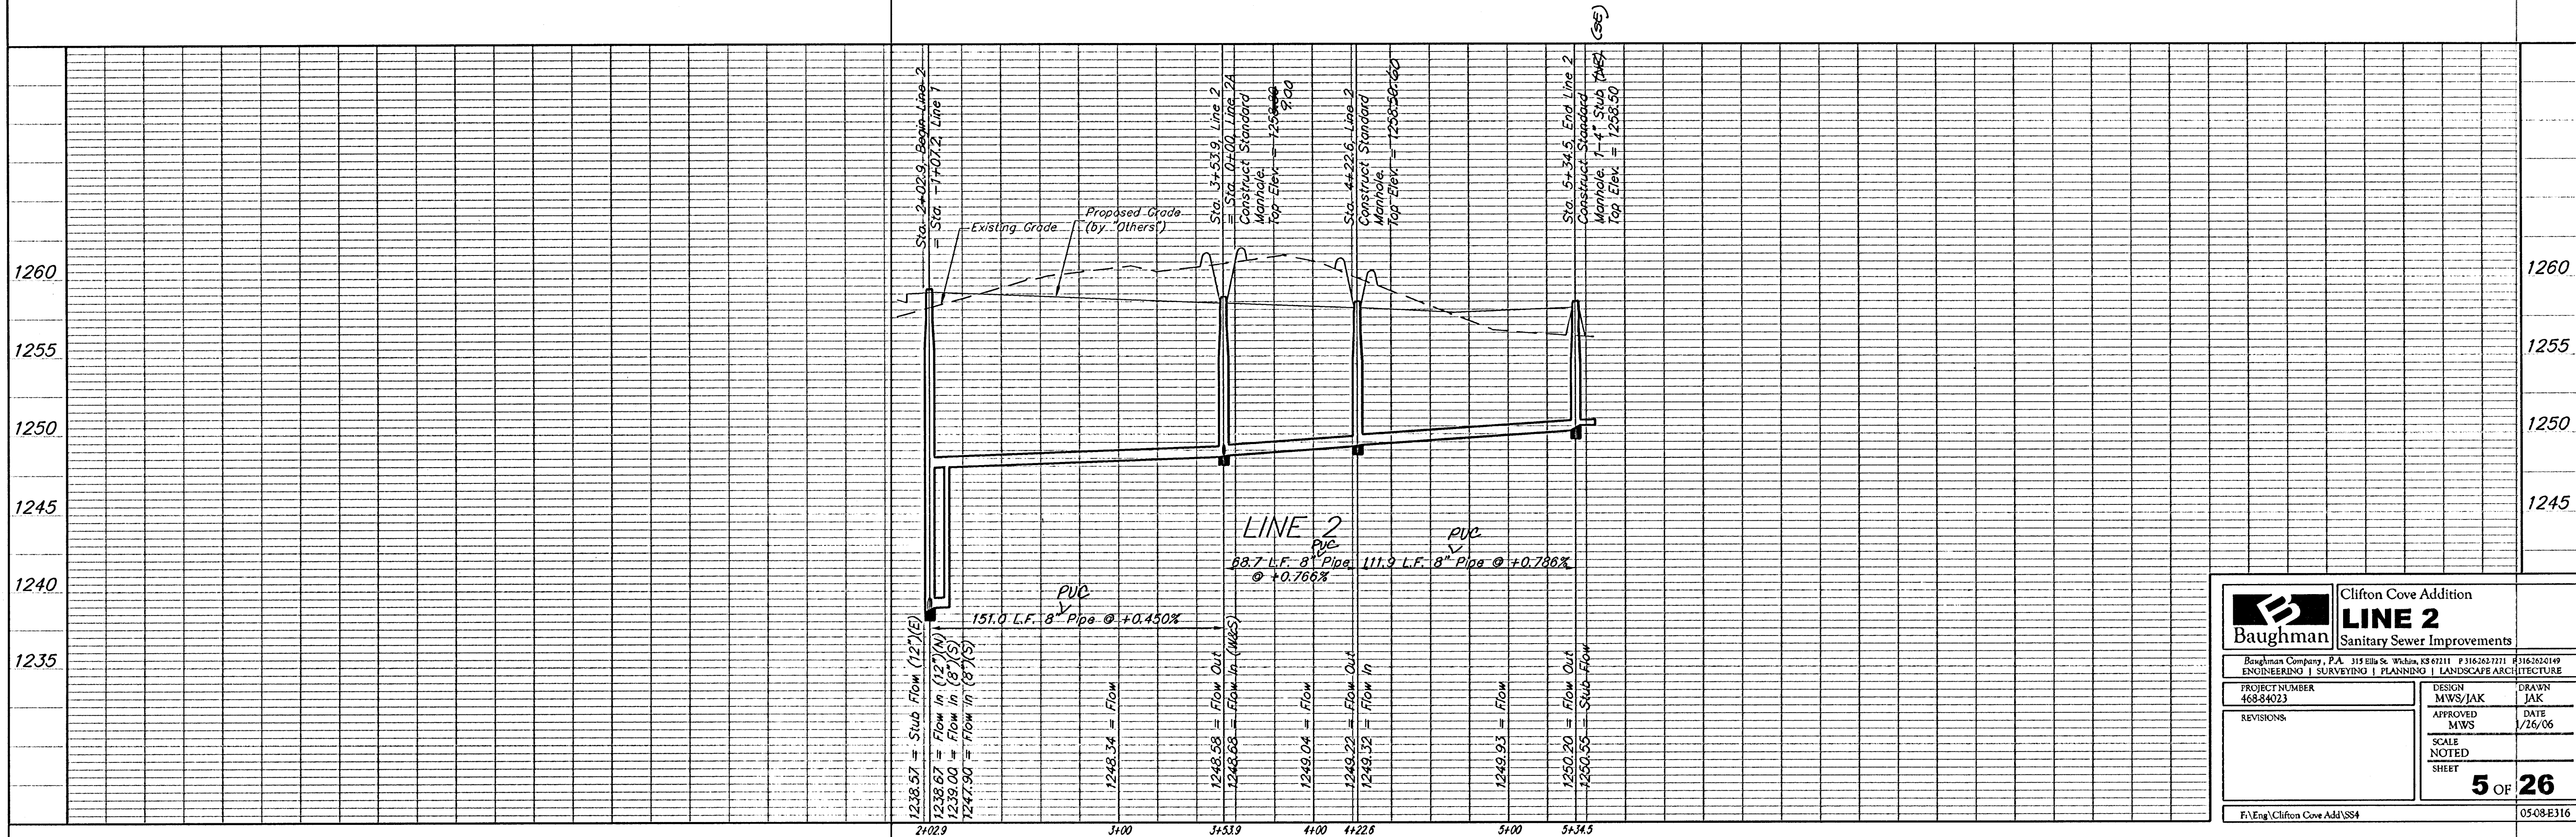

Baughman		Clifton Cove Addition LINE 2 Sanitary Sewer Improvements	
Baughman Company, P.A. 315 Ellis St. Wichita, KS 67211 P316262771 P3162626149 ENGINEERING SURVEYING PLANNING LANDSCAPE ARCHITECTURE			
PROJECT NUMBER 468-84023	DESIGN MWS/JAK	DRAWN JAK	
REVISIONS:	APPROVED MWS	DATE 1/26/06	
SCALE NOTED SHEET		5 OF 26	
F:\Eng\Clifton Cove Add\SS4		05-08-E316	