


BENCHMARK:
Arkansas River bridge & 63rd St. S. City of
Wichita Benchmark Disc. SW Cor. of bridge,
top of hubguard. 500'± E. of Grove.
Elev. = 1269.95 NGVD29 (per City record)

Brass plate on the NE wingwall of Arkansas
River bridge & 63rd St. S.
Elev. = 1267.48 NGVD29 (per County record)

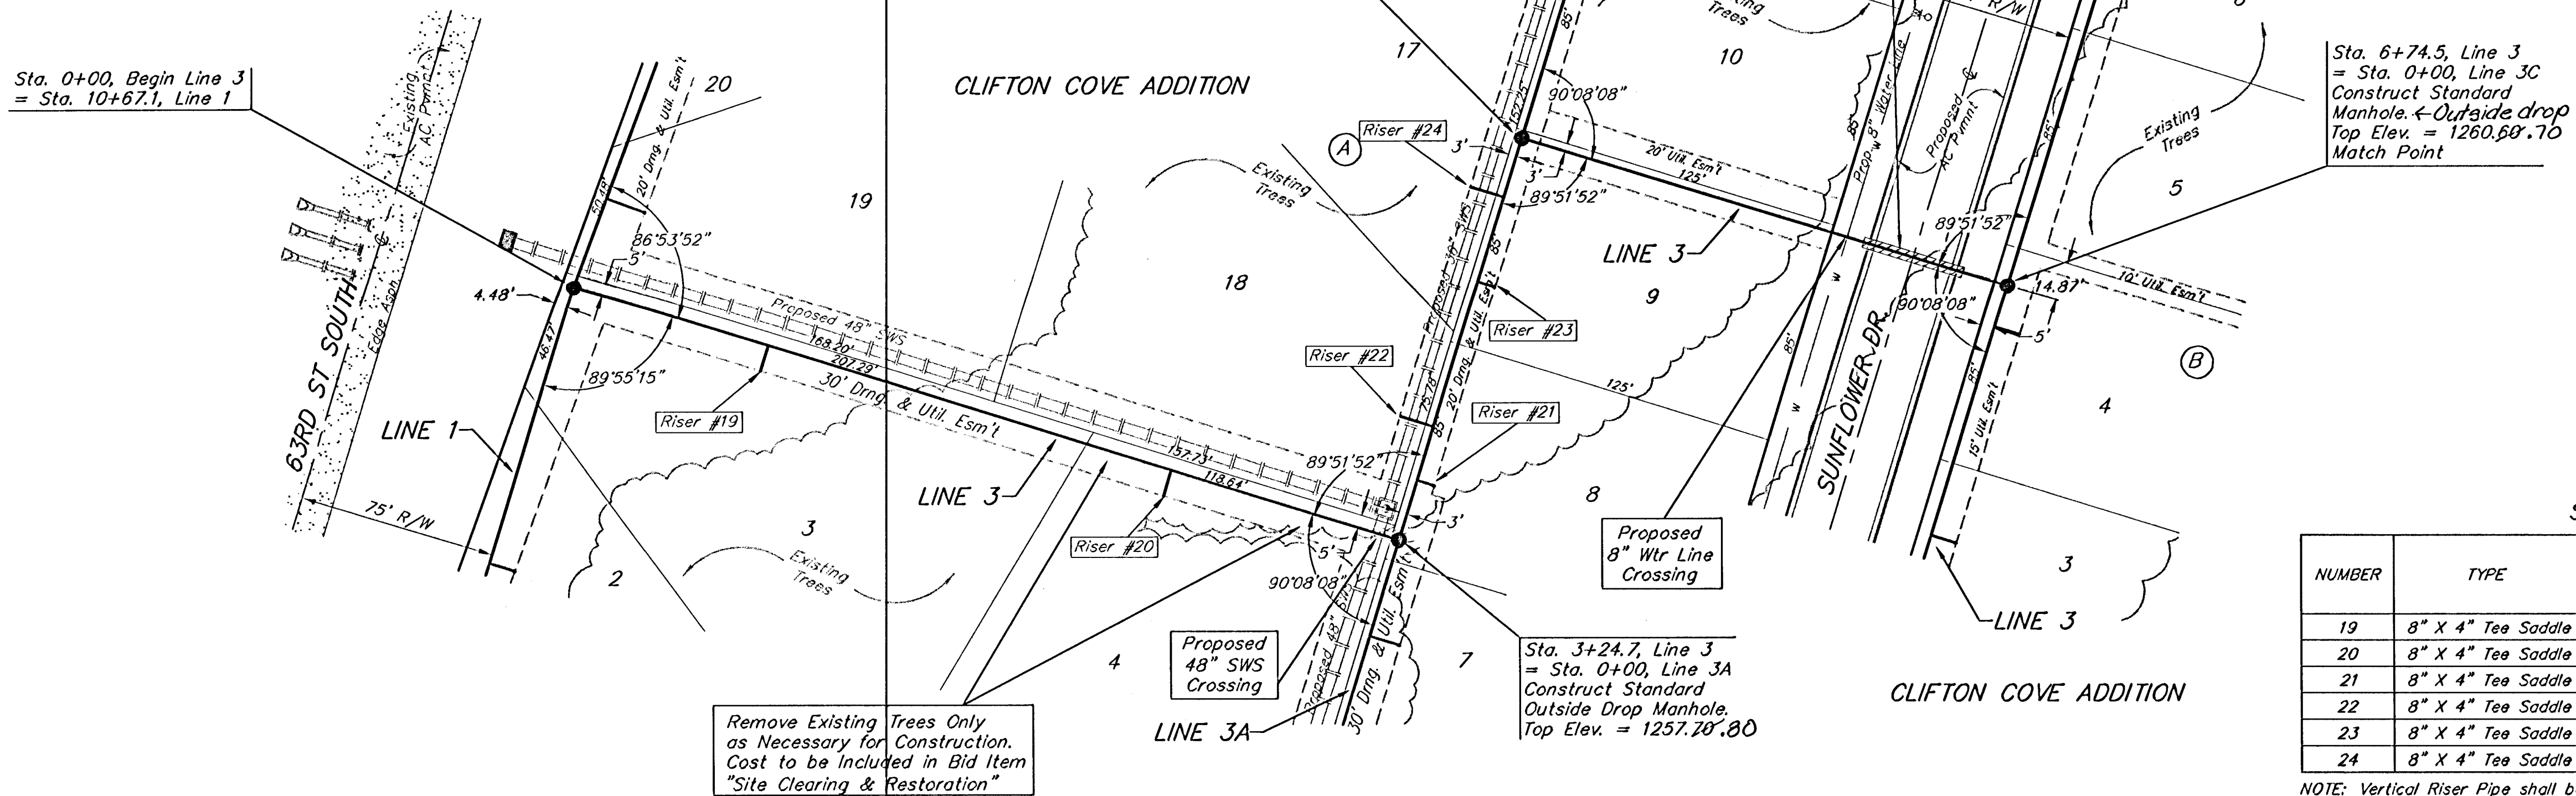


SCALE:
1" = 40' HORIZONTAL
1" = 5' VERTICAL
• = IRON

SEWER SERVICE TABLE

NUMBER	TYPE	LOCATION				FOR INFORMATION ONLY	
		LOT NO.	BLOCK NO.	LINE NO.	STATION/DIRECTION	APPROXIMATE LENGTH 4" PIPE	
19	8" X 4" Tee Saddle	3	A	3	0+27/Rt.	80	13'
20	8" X 4" Tee Saddle	4	A	3	2+35/Rt.	37	13'
21	8" X 4" Tee Saddle	8	A	3	3+48/Rt.	50	11.5'
22	8" X 4" Tee Saddle	18	A	3	3+59/Lt.	70	12'
23	8" X 4" Tee Saddle	9	A	3	4+26/Rt.		7'
24	8" X 4" Tee Saddle	17	A	3	4+60/Lt.		13'

NOTE: Vertical Riser Pipe shall be extended to 2' minimum above ground water elevation and 4' maximum below proposed ground elevation.

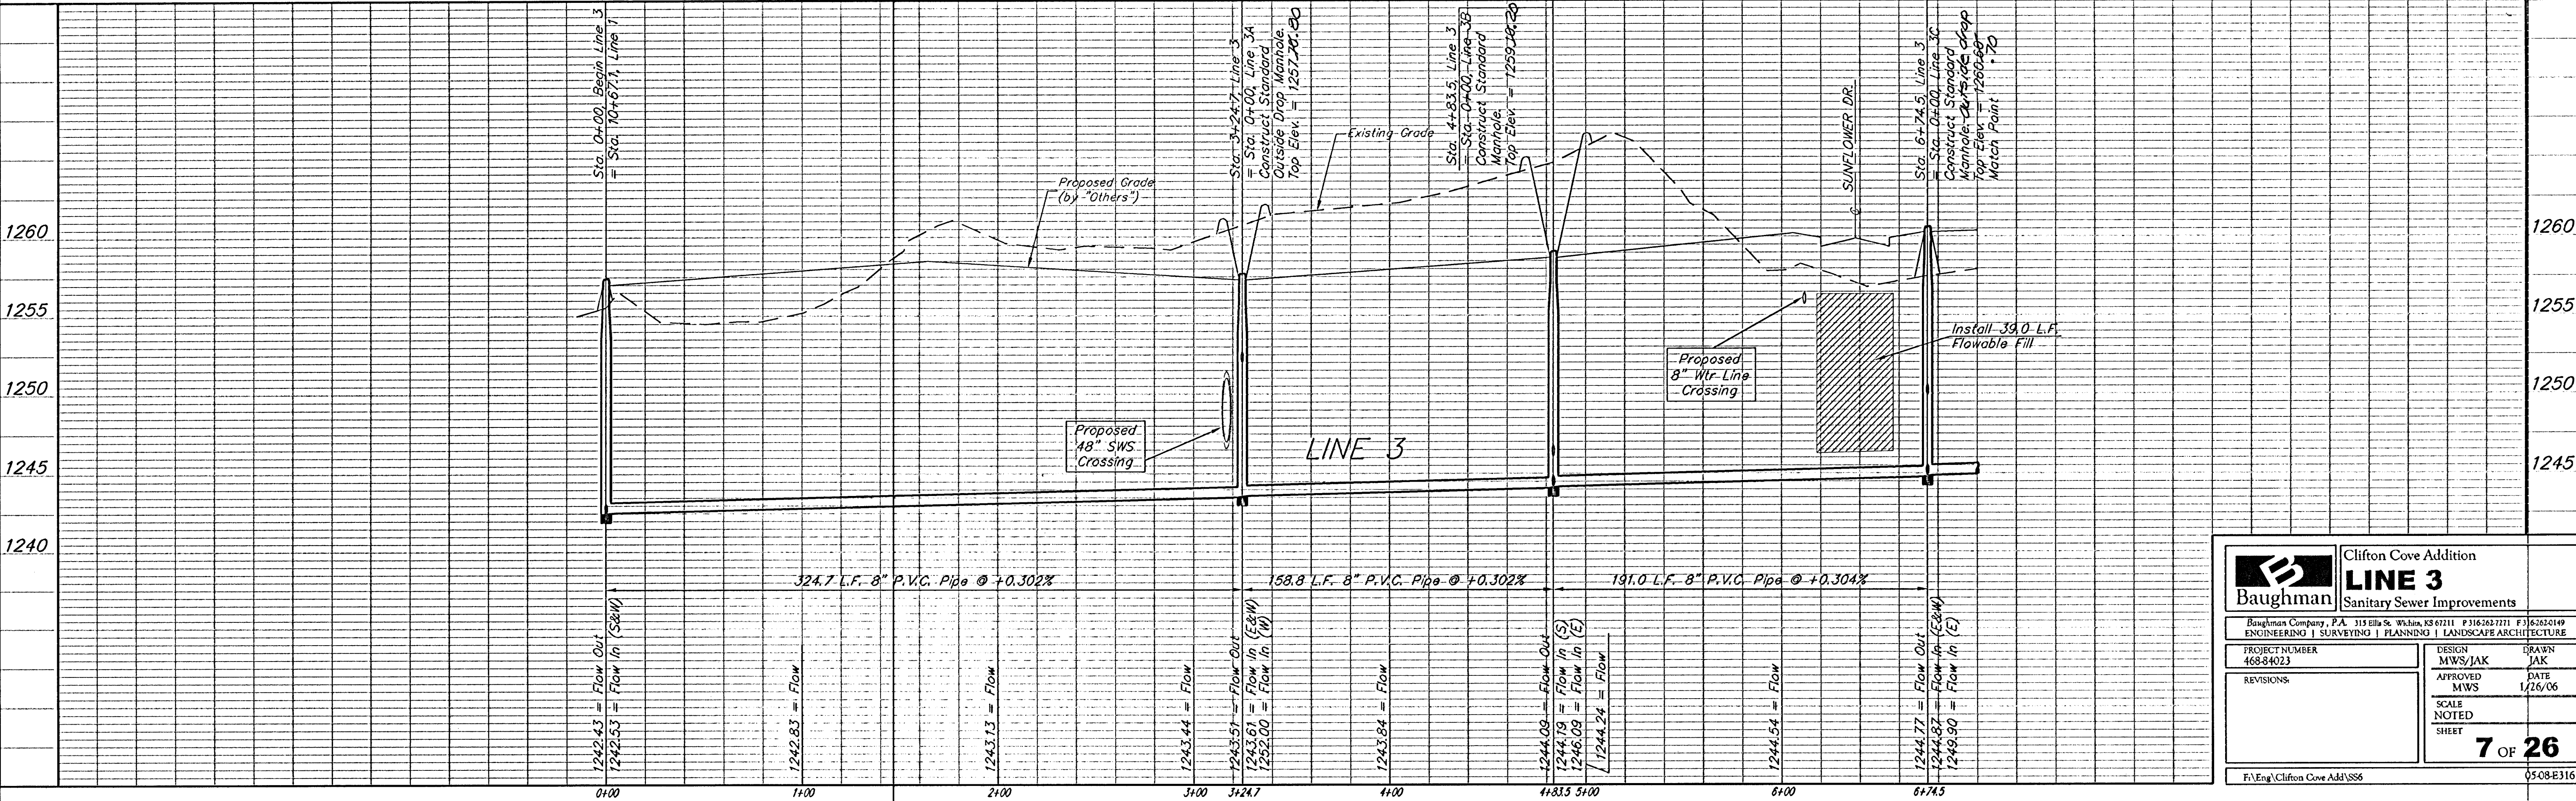

Clifton Cove Addition
LINE 3
Sanitary Sewer Improvements

Baughman Company, P.A. 315 E. St. W. Wichita, KS 67211 P: 316-263-7771 F: 316-263-0149
ENGINEERING | SURVEYING | PLANNING | LANDSCAPE ARCHITECTURE

PROJECT NUMBER 468-84023	DESIGN MWS/JAK	DRAWN JAK
REVISIONS:	APPROVED MWS	DATE 1/26/06
SCALE NOTED SHEET		7 OF 26

Flt/Eng/Clifton Cove Add/SS6

0508E316