BENCHMARK:
Arkansas River bridge & 63rd St. S. City of Wichita Benchmark Disc. SW Cor. of bridge, top of hubguard. 500'± E. of Grove.
Elev. = 1269.95 NGVD29 (per City record)

Brass plate on the NE wingwall of Arkansas River bridge & 63rd St. S.
Elev. = 1267.48 NGVD29 (per County record)

The Contractor shall be required to contact Kevin Brown @ (316)722-2605 or Stan Bowen @ (316)722-2628 with Gneek Field Services 48 hours prior to Construction along 16" Steel Gas Pipeline.

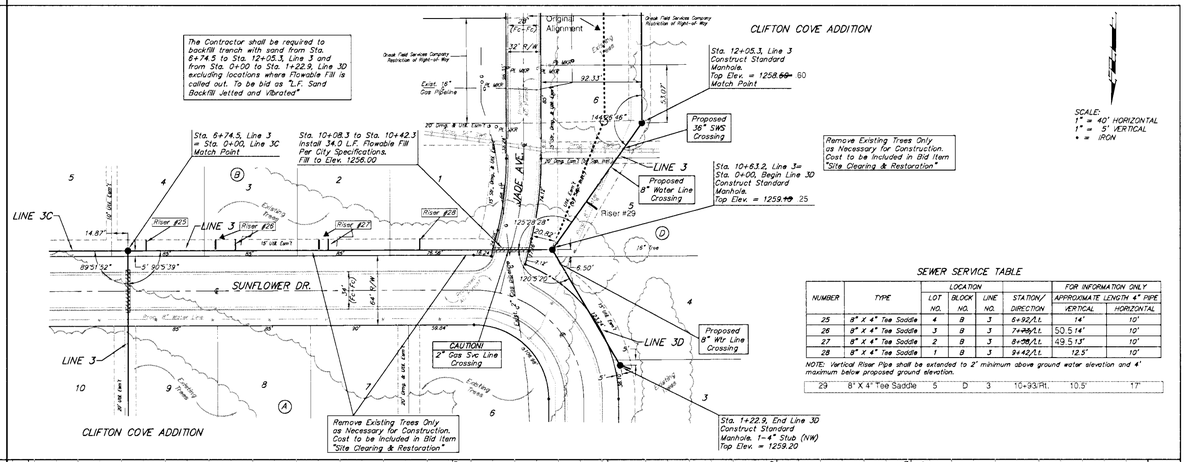

SEWER SERVICE TABLE

NUMBER	TYPE	LOCATION				FOR INFORMATION ONLY	
		LOT NO.	BLOCK NO.	LINE NO.	STATION/ DIRECTION	APPROXIMATE LENGTH 4" PIPE VERTICAL	HORIZONTAL
25	8" X 4" Tee Saddle	4	B	3	6+92/Lt.	14'	10'
26	8" X 4" Tee Saddle	3	B	3	7+88/Lt.	50.5'14'	10'
27	8" X 4" Tee Saddle	2	B	3	8+78/Lt.	49.5'13'	10'
28	8" X 4" Tee Saddle	1	B	3	9+42/Lt.	12.5'	10'

NOTE: Vertical Riser Pipe shall be extended to 2' minimum above ground water elevation and 4' maximum below proposed ground elevation.

29	8" X 4" Tee Saddle	5	D	3	10+93/Rt.	10.5'	17'

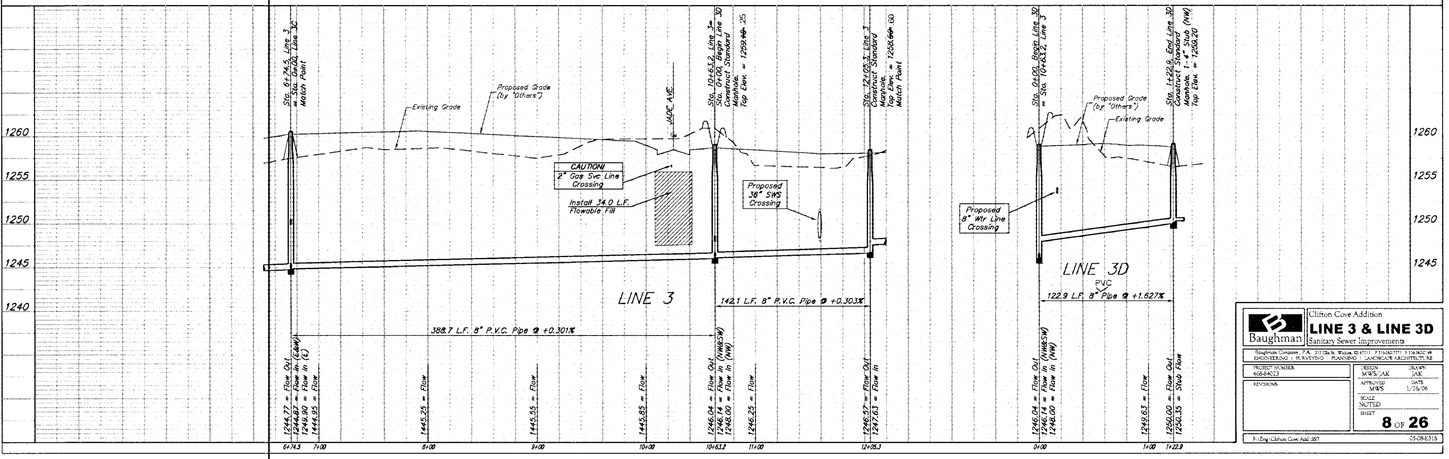

Baughman
Clifton Cove Addition
LINE 3 & LINE 3D
Sanitary Sewer Improvements


PROJECT NUMBER 4068-04023	DESIGN MWS/JAK · DRAWN JAK
REVISIONS	APPROVED MWS · DATE 1/26/06
	SCALE NOTED
	SHEET **8** OF **26**

F:\Eng\Clifton Cove Add.dwg 03-08-2006