


BENCHMARK:
Arkansas River bridge & 63rd St. S. City of
Wichita Benchmark Disc. SW Cor. of bridge,
top of hubguard, 500'± E. of Grove.
Elev. = 1269.95 NGVD29 (per City record)

Brass plate on the NE wingwall of Arkansas
River bridge & 63rd St. S.
Elev. = 1267.48 NGVD29 (per County record)

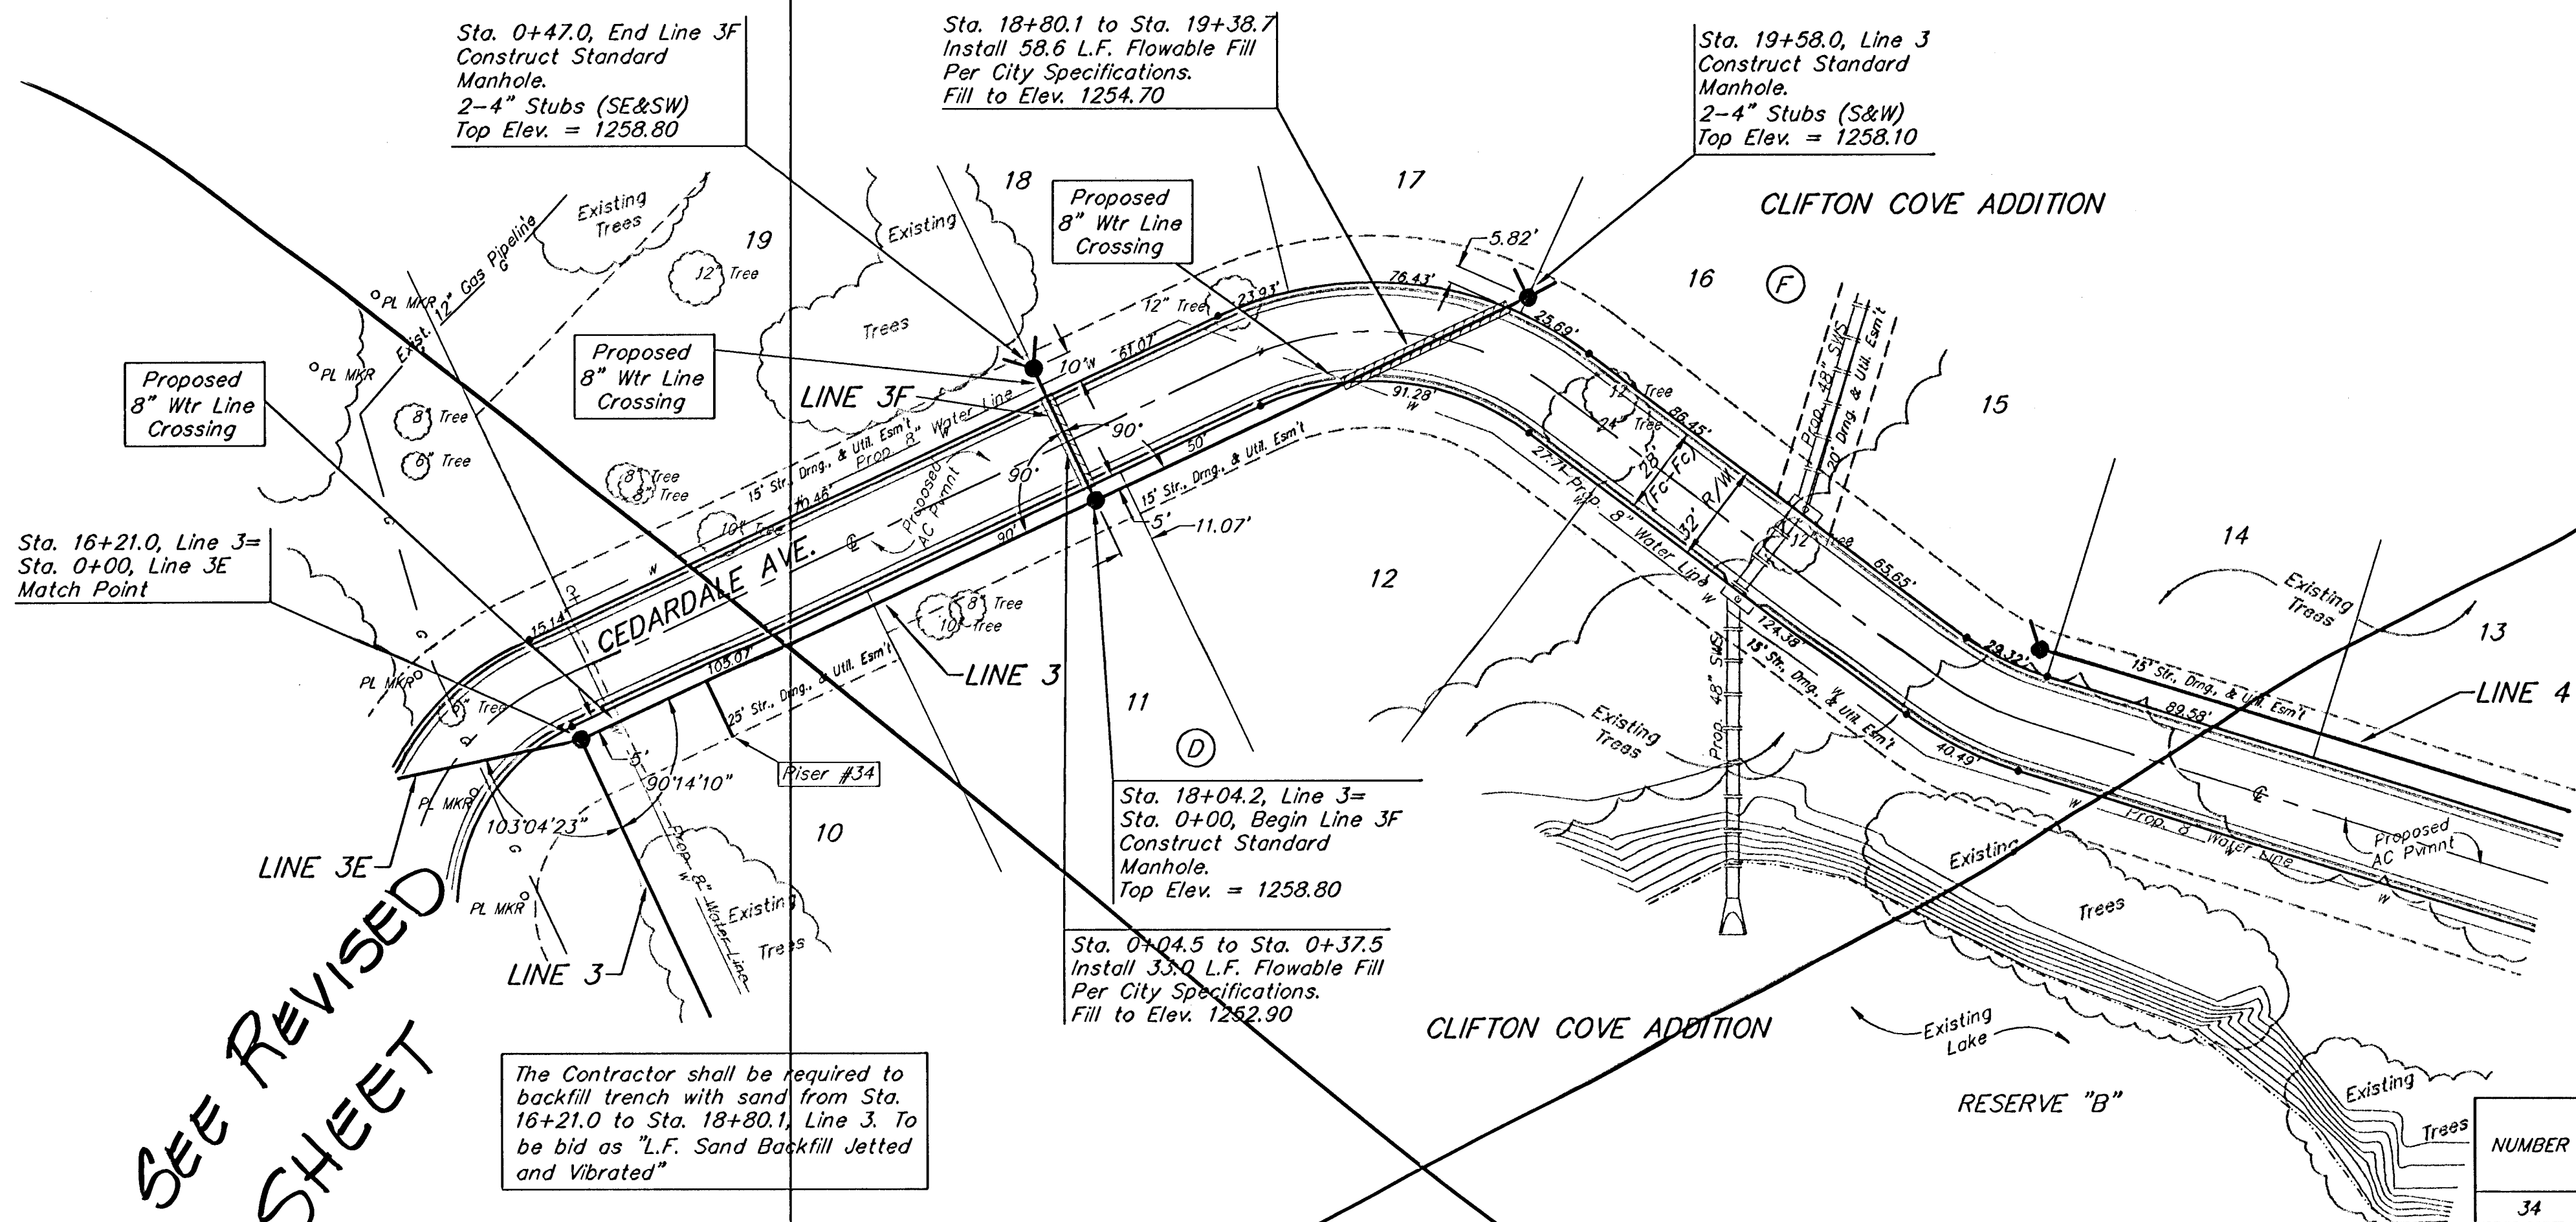

SEE REVISED
SHEET


The Contractor shall be required to backfill trench with sand from Sta. 16+21.0 to Sta. 18+80.1, Line 3. To be bid as "L.F. Sand Backfill Jetted and Vibrated"

SCALE:
1" = 40' HORIZONTAL
1" = 5' VERTICAL
• = IRON

SEWER SERVICE TABLE

NUMBER	TYPE	LOCATION			STATION/ DIRECTION	FOR INFORMATION ONLY	
		LOT NO.	BLOCK NO.	LINE NO.		APPROXIMATE LENGTH 4" PIPE	
34	8" X 4" Tee Saddle	10	D	3	16+66/Rt.	8'	20'

NOTE: Vertical Riser Pipe shall be extended to 2' minimum above ground water elevation and 4' maximum below proposed ground elevation.

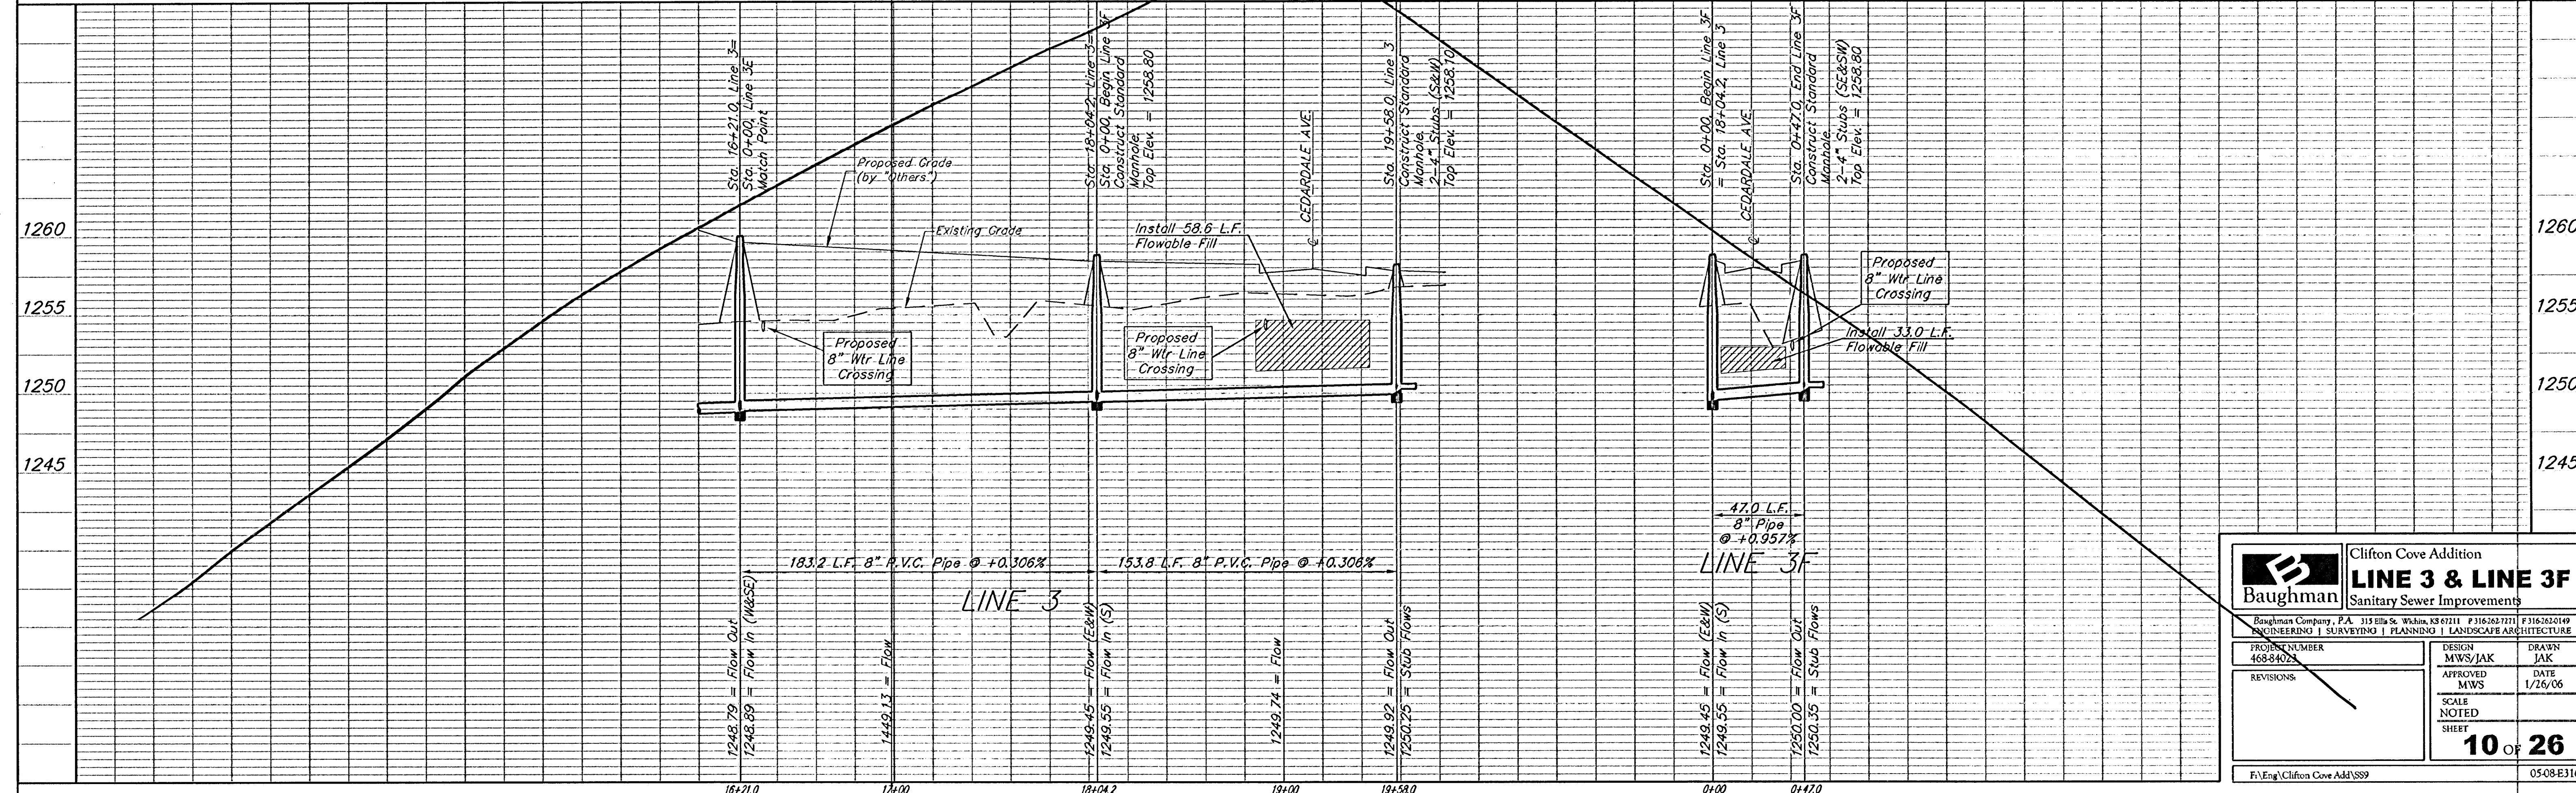

Baughman

Clifton Cove Addition
LINE 3 & LINE 3F
Sanitary Sewer Improvements

PROJECT NUMBER
468-84023

DESIGN
MWS/JAK

DRAWN
JAK

APPROVED
MWS

DATE
1/26/06

SCALE
NOTED

SHEET
10 OF 26

F:\Eng\Clifton Cove Add\SS9

0508-E316