


BENCHMARK:
Arkansas River bridge & 63rd St. S. City of
Wichita Benchmark Disc. SW Cor. of bridge,
top of hubguard. 500'± E. of Grove.
Elev. = 1269.95 NGVD29 (per City record)


Brass plate on the NE wingwall of Arkansas
River bridge & 63rd St. S.
Elev. = 1267.48 NGVD29 (per County record)

NUMBER	TYPE	LOCATION			FOR INFORMATION ONLY	
		LOT NO.	BLOCK NO.	LINE NO.	STATION/ DIRECTION	APPROXIMATE LENGTH 4" PIPE VERTICAL HORIZONTAL
38	8" X 4" Tee Saddle	22	D	4	4+54/Lt.	55.5 14.5'
39	8" X 4" Tee Saddle	21	D	4	5+44/Lt.	48.5 13.5'
40	8" X 4" Tee Saddle	20	D	4	6+34/Lt.	35.5 13.5'
41	8" X 4" Tee Saddle	19	D	4	7+24/Lt.	13' 12'
42	8" X 4" Tee Saddle	18	D	4	8+15/Lt.	17' 13'
43	8" X 4" Tee Saddle	17	D	4	9+27/Lt.	28' 13'

NOTE: Vertical Riser Pipe shall be extended to 2' minimum above ground water elevation and 4' maximum below proposed ground elevation.

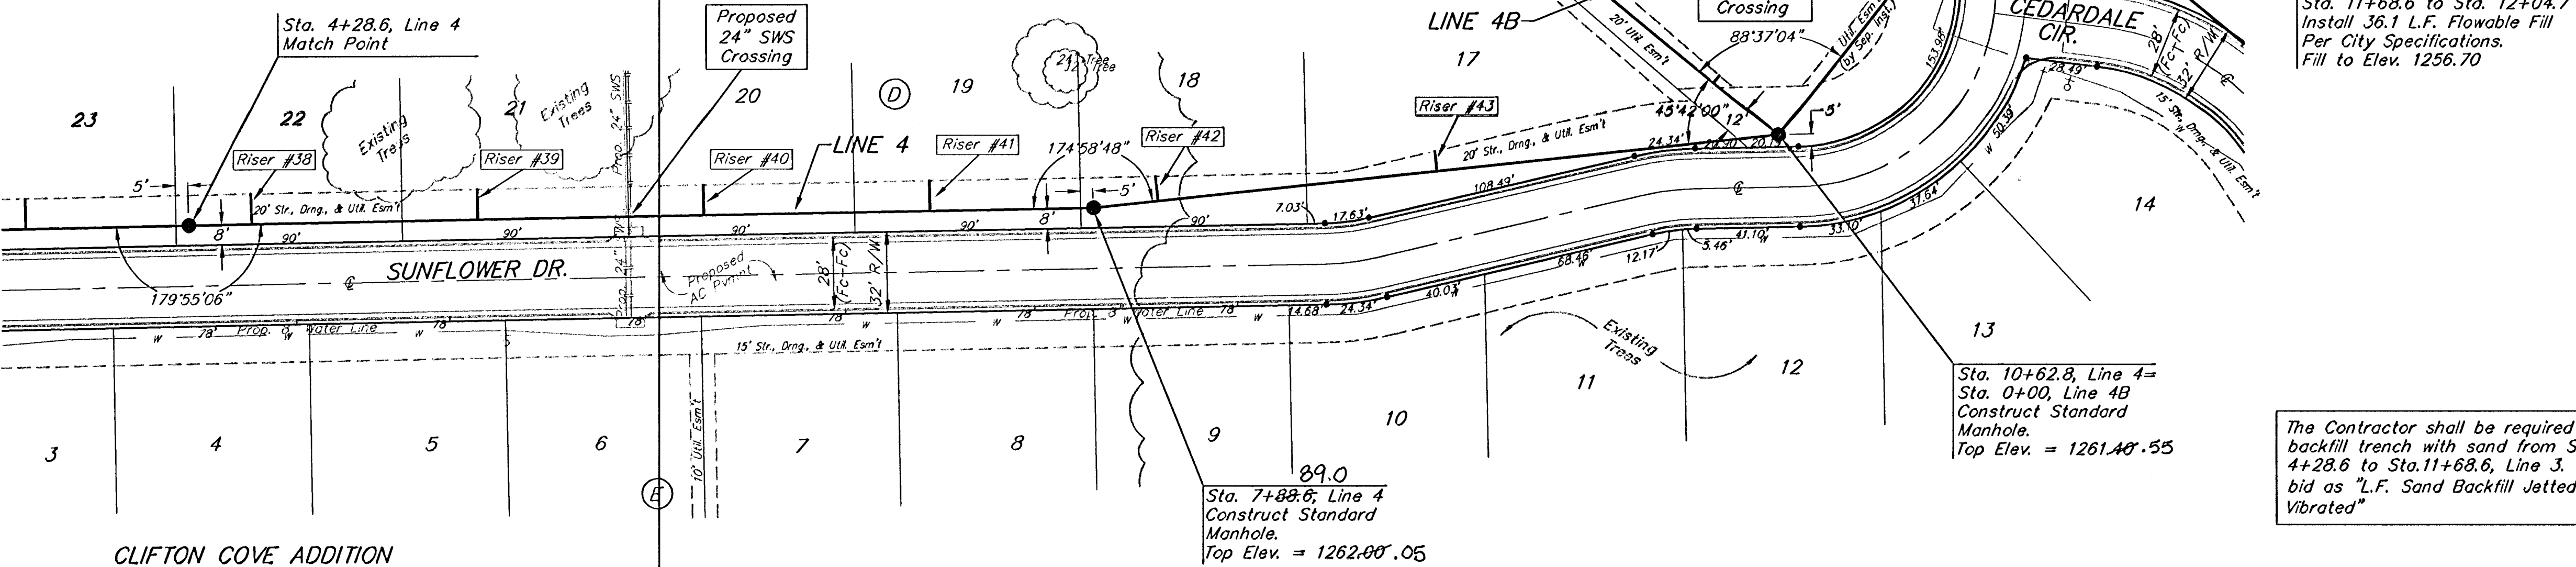

CLIFTON COVE ADDITION

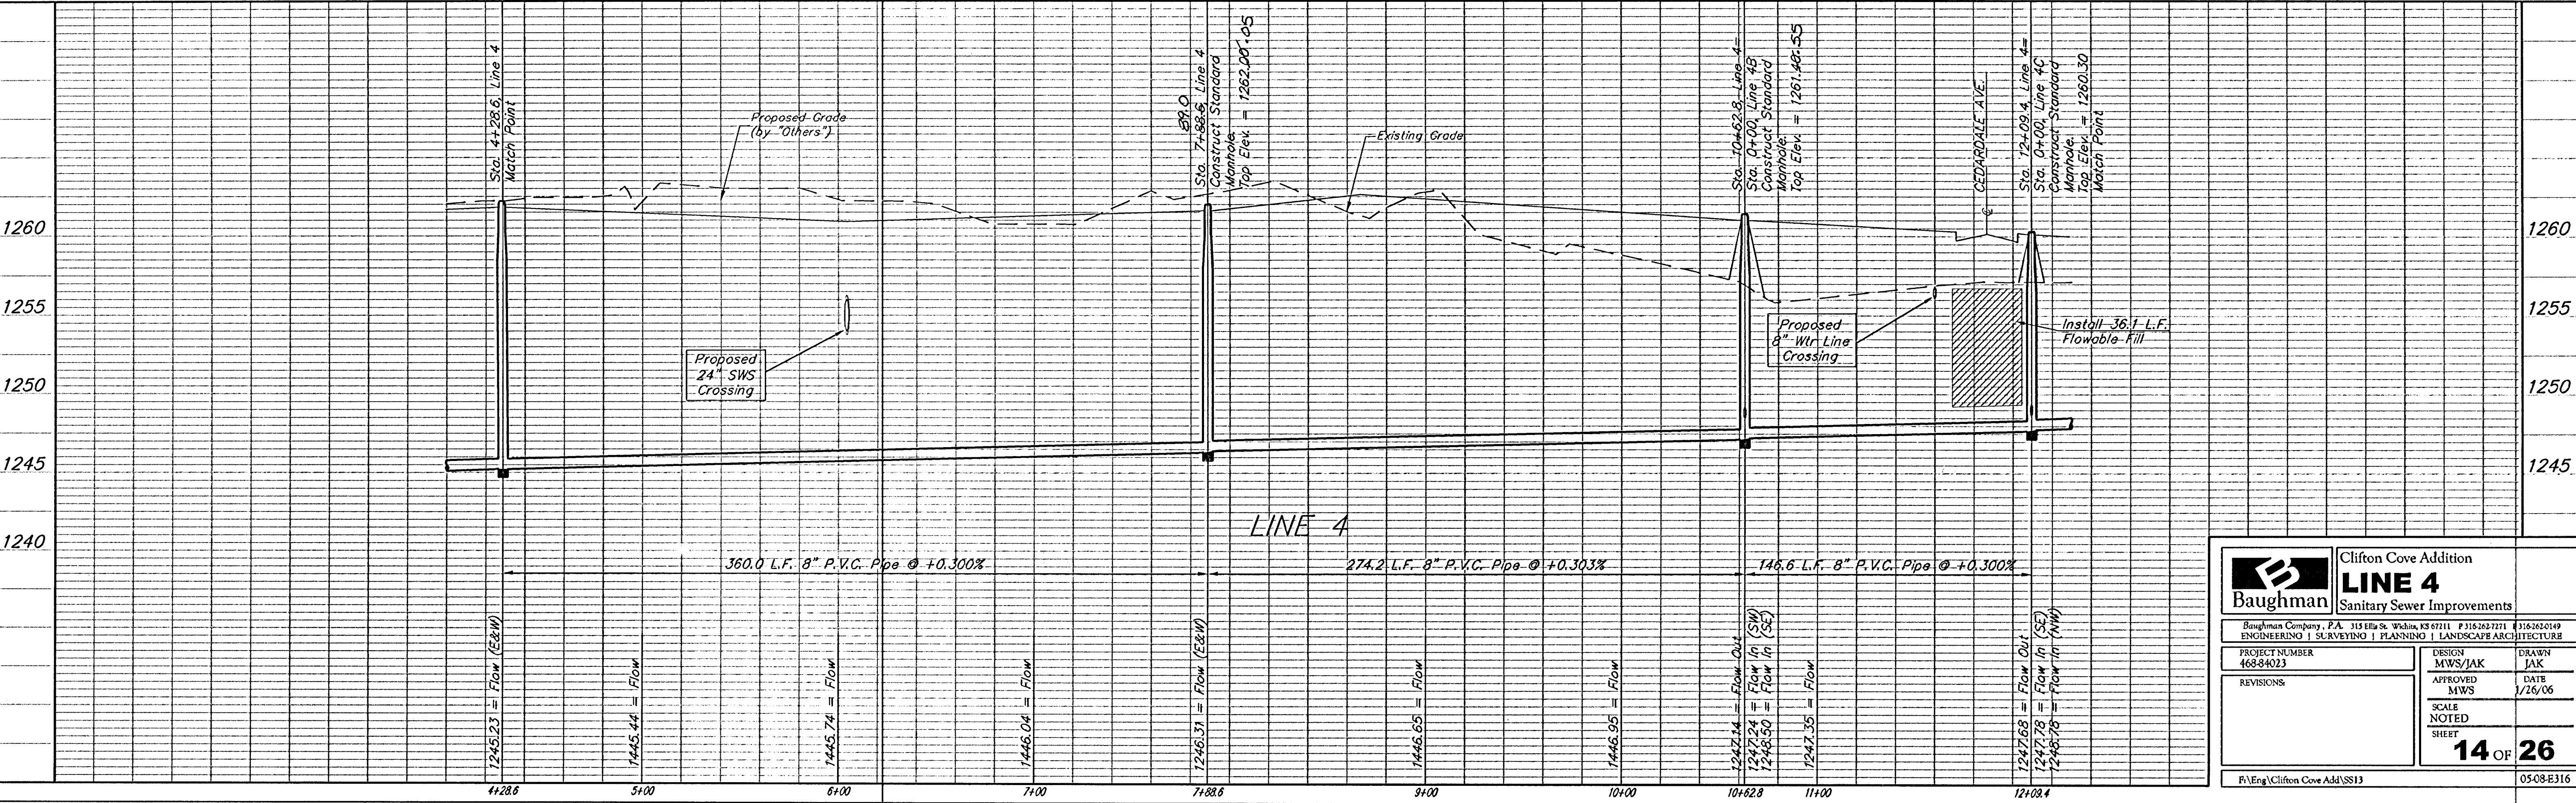

Clifton Cove Addition
LINE 4
Sanitary Sewer Improvements

PROJECT NUMBER
468-84023

DESIGN
MWS/JAK

DRAWN
JAK

REVISIONS

APPROVED
MWS

DATE
1/26/06

SCALE
NOTED
SHEET

14 OF **26**

FILE/Eng/Clifton Cove Add/SS13

0508-E316