



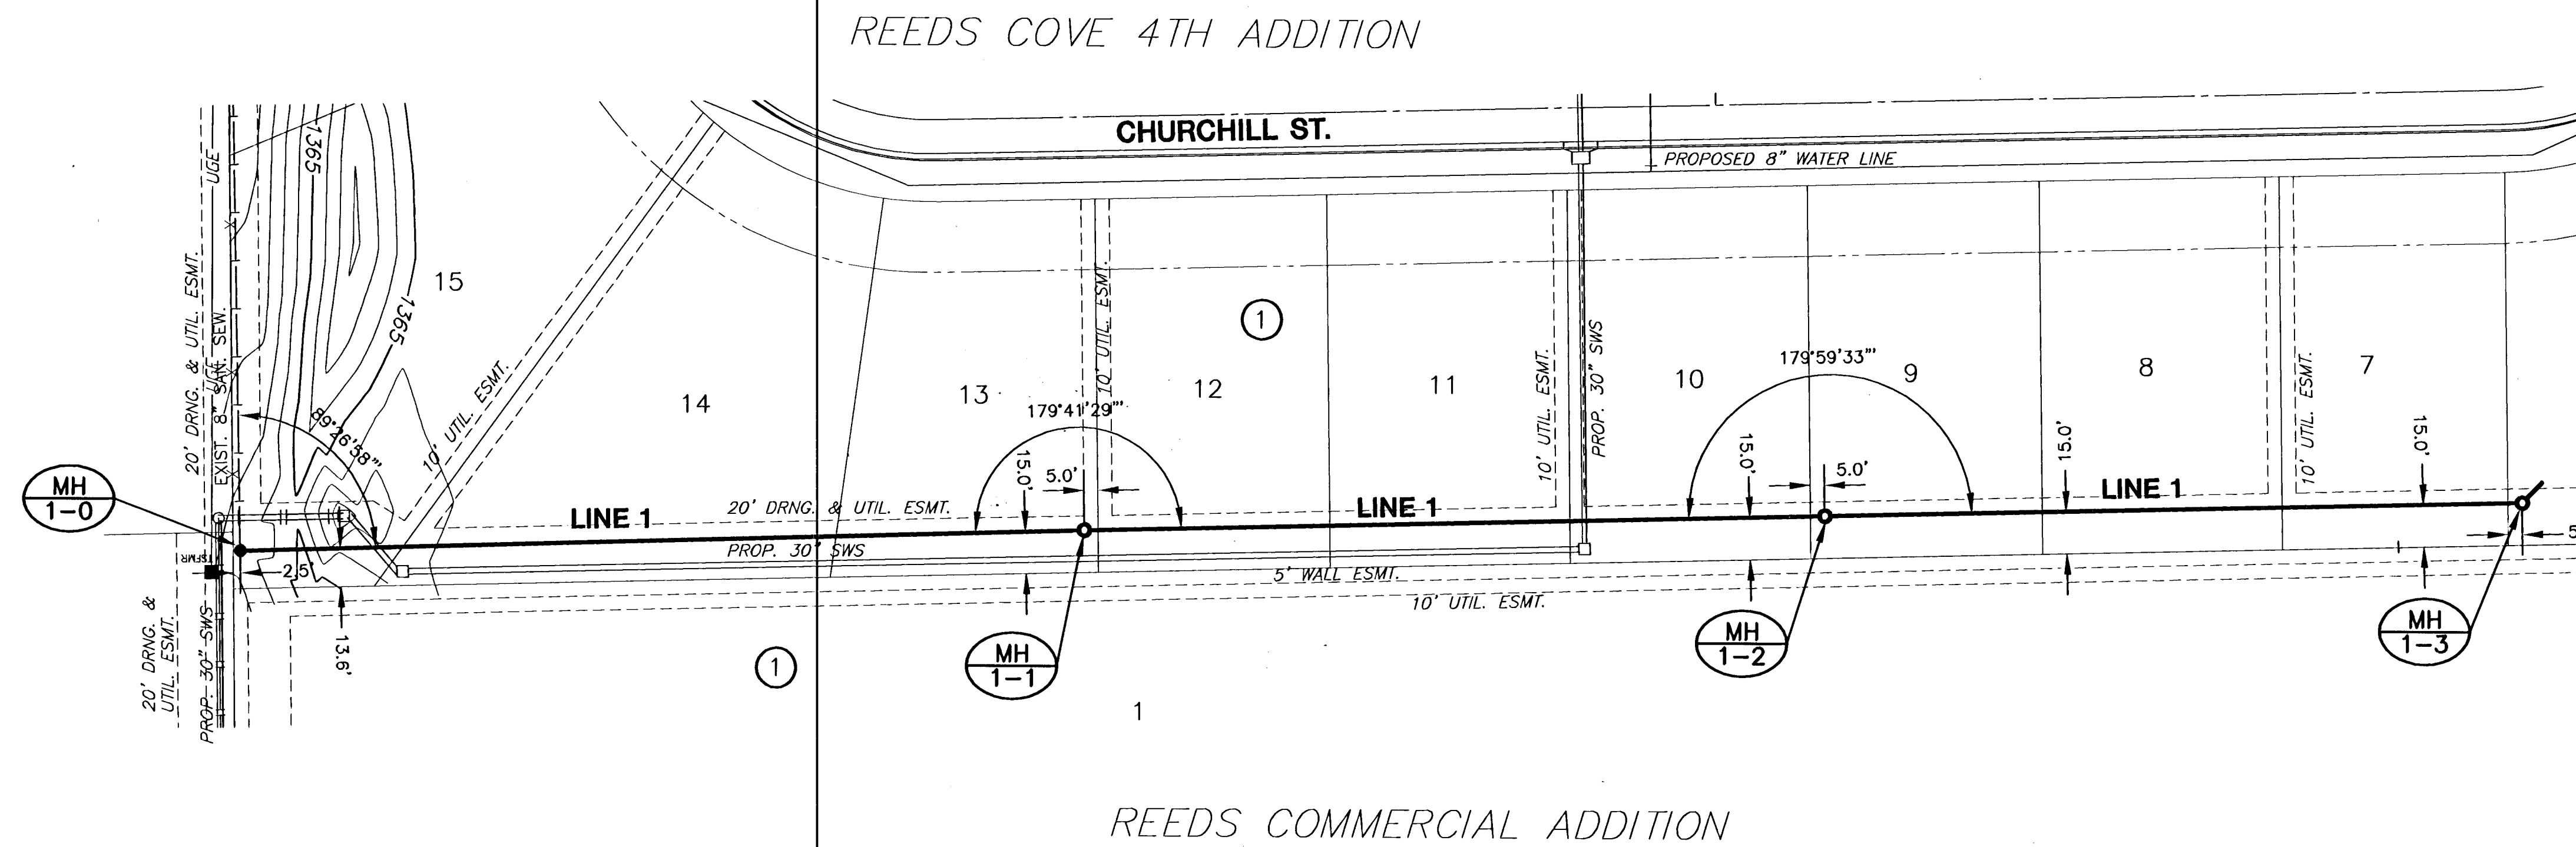

PLAN LINE 1

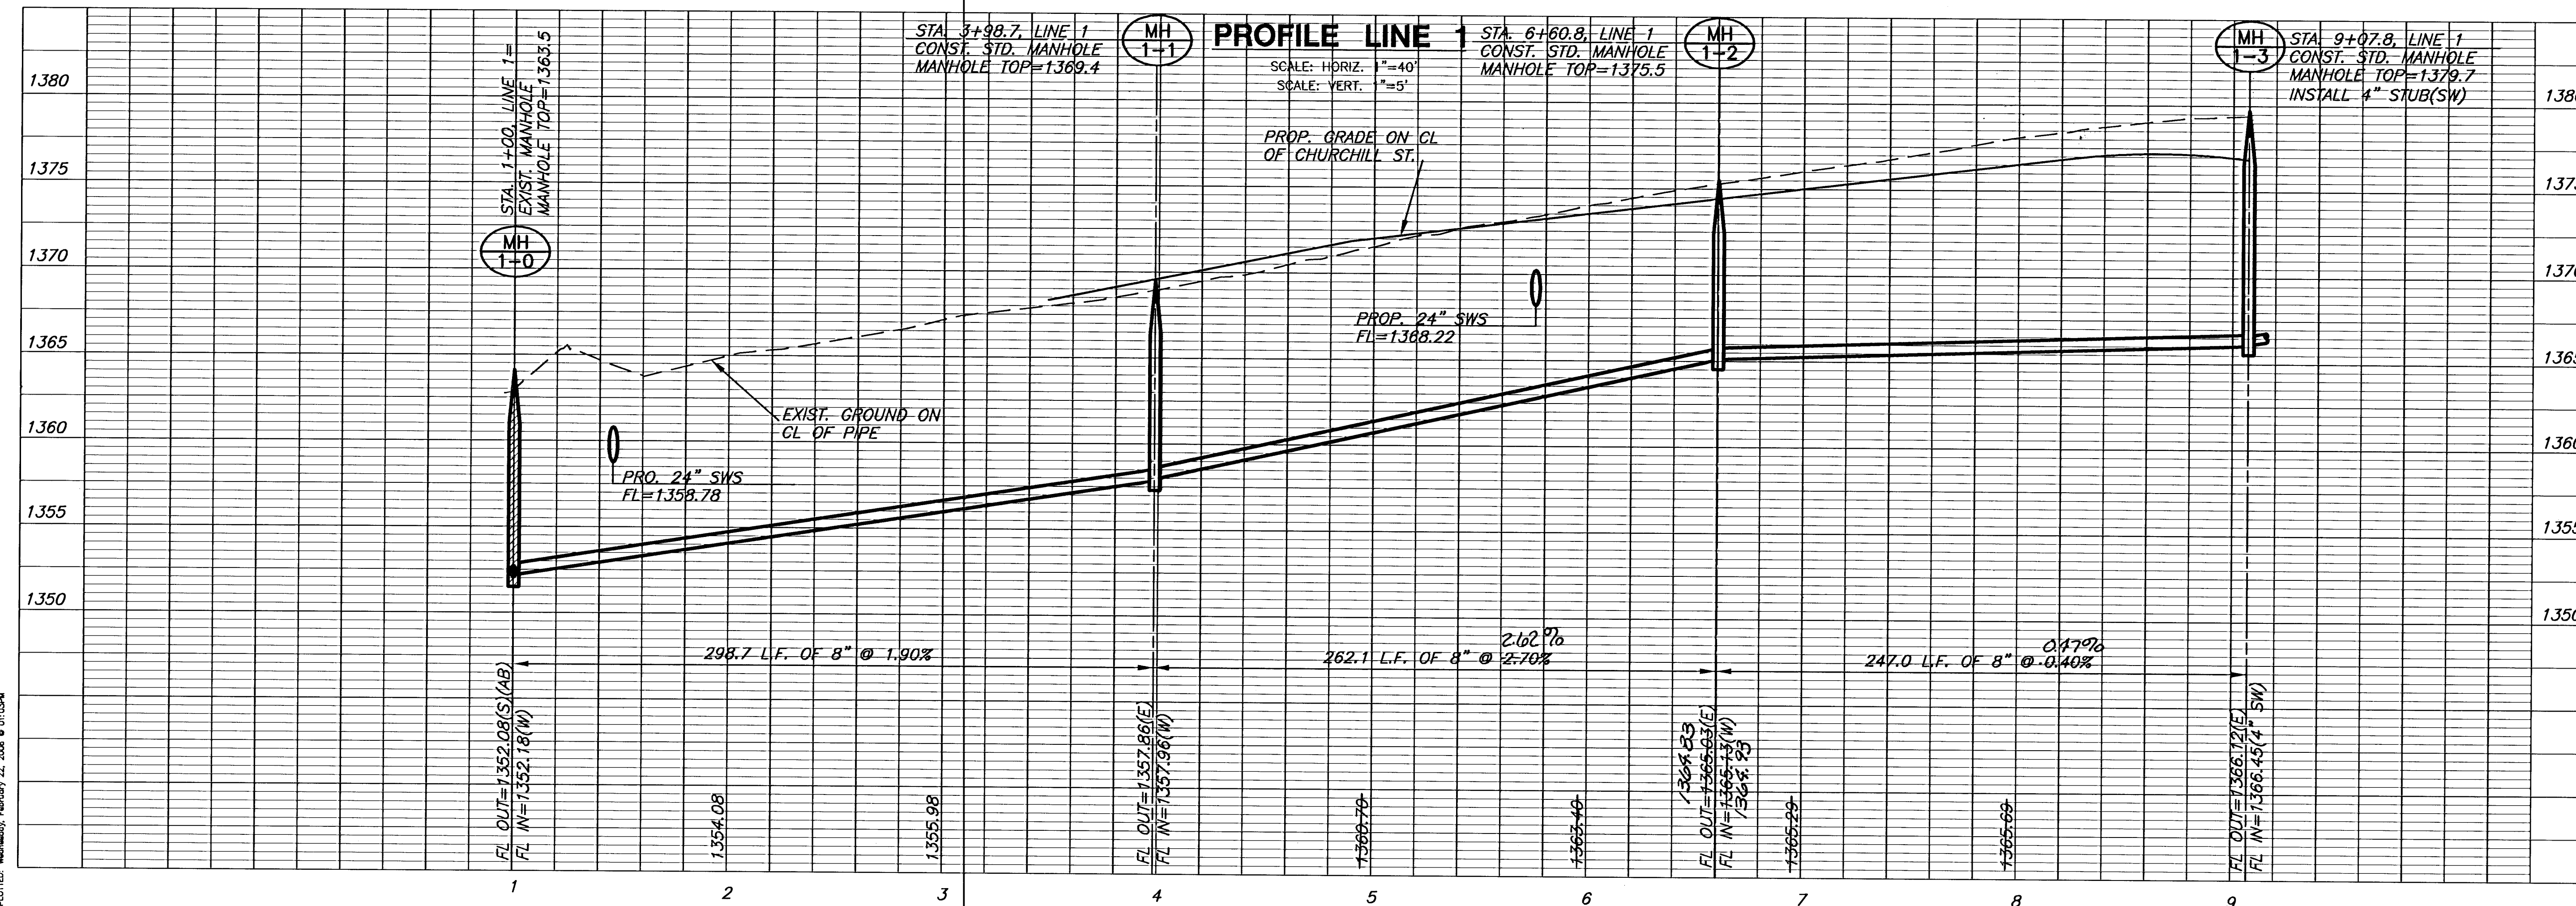

MKEC
ENGINEERING
CONSULTANTS, INC.

411 N. WEBB ROAD
WICHITA, KS. 67206
316-684-9600

SANITARY SEWER PLANS REED'S COVE FOURTH ADDITION

LINE 1

SHEET TITLE

448-00000

PROJECT NUMBER

DESIGN BY SRS

DRAWN BY DM/BFL

CHECKED BY GJA

ISSUED
FEBRUARY 2006

REVISÉ

SHEET NO.

3 of 11