
BENCHMARK:
BM #1: "□" Cut in middle of N headwall of RCBC on 21st St. North. 1004.3' W & 22.1' N of SE Cor., SE1/4, Sec. 2, T-27-S, R-2-E.
Elev. = 173.23 City Datum


BM #2: "□" Cut at the SE corner of the intersection of Castle Rock & Castle Rock Ct., Krug North Addition.
Elev. = 183.50 City Datum

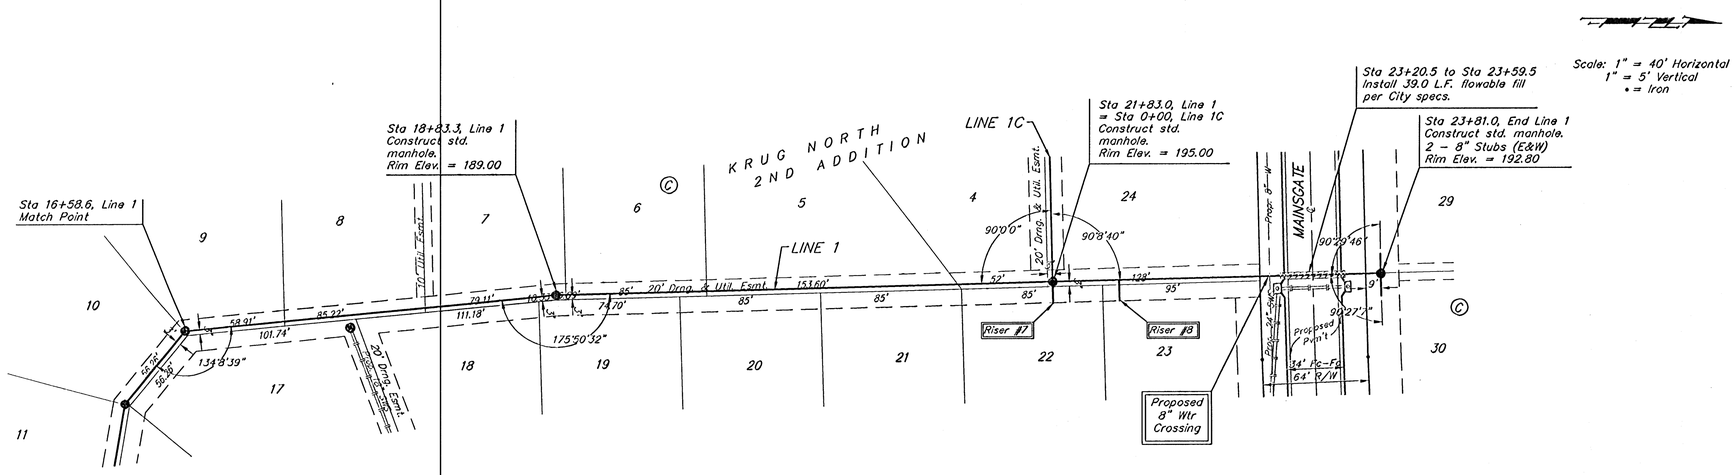


## SEWER SERVICE TABLE

| NUMBER | TYPE | LOCATION | | | STATION \ DIRECTION | FOR INFORMATION ONLY | |
|---|---|---|---|---|---|---|---|
| | | LOT NO. | BLOCK NO. | LINE NO. | | APPROXIMATE LENGTH 4" PIPE | |
| | | | | | | VERTICAL | HORIZONTAL |
| 7 | 4" Stub | 22 | C | 1 | 21+83/Rt. | 9.5' | ~~13'~~ 15' |
| 8 | 8" X 4" Tee | 23 | C | 1 | 22+~~83~~/Rt. | 9.5' | 13' |

NOTE: Vertical Riser Pipe shall be extended to 2' minimum above ground water elevation and 4' maximum below proposed ground elevation.

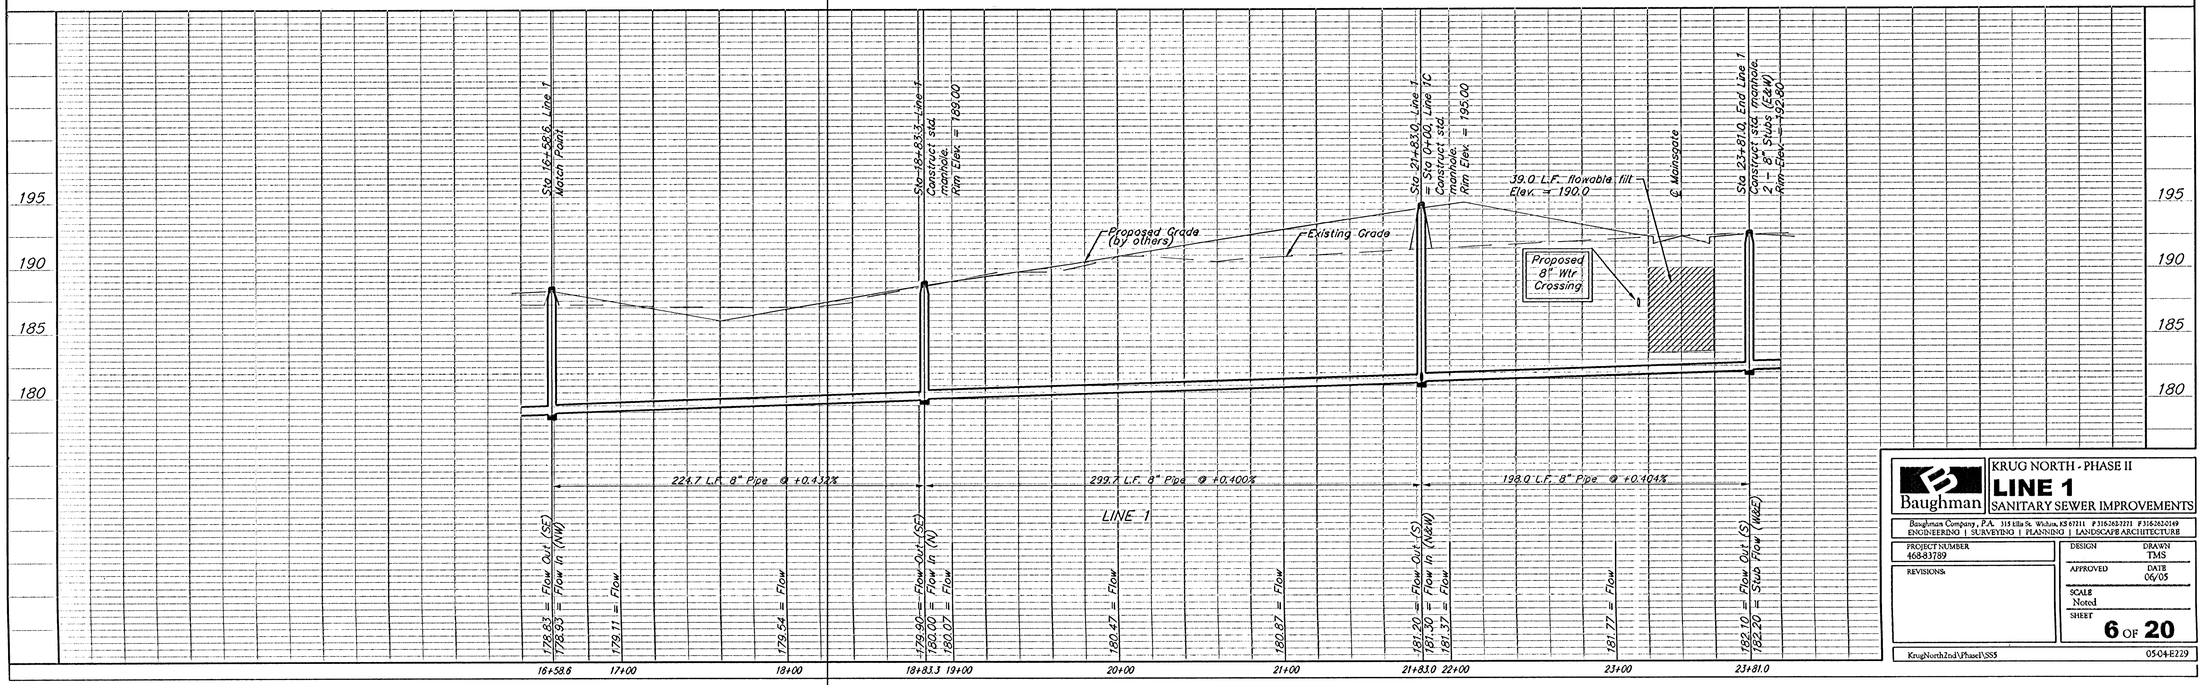


Baughman

KRUG NORTH - PHASE II
**LINE 1**
SANITARY SEWER IMPROVEMENTS


Baughman Company, P.A. 315 Ella St. Wichita, KS 67211 P 3162622771 F 3162620149
ENGINEERING | SURVEYING | PLANNING | LANDSCAPE ARCHITECTURE


| | |
|---|---|
| PROJECT NUMBER 46883789 | DESIGN / DRAWN TMS |
| REVISIONS | APPROVED / DATE 06/05 |
| | SCALE Noted |
| | SHEET 6 OF 20 |

KrugNorth2nd\Phase1\SS5 05-04-E229