
BENCHMARK:
BM #1: "□" Cut in middle of N headwall of RCBC on 21st St. North. 1004.3' W & 22.1' N of SE Cor., SE1/4, Sec. 2, T-27-S, R-2-E.
Elev. = 173.23 City Datum

BM #2: "□" Cut at the SE corner of the intersection of Castle Rock & Castle Rock Ct., Krug North Addition.
Elev. = 183.50 City Datum

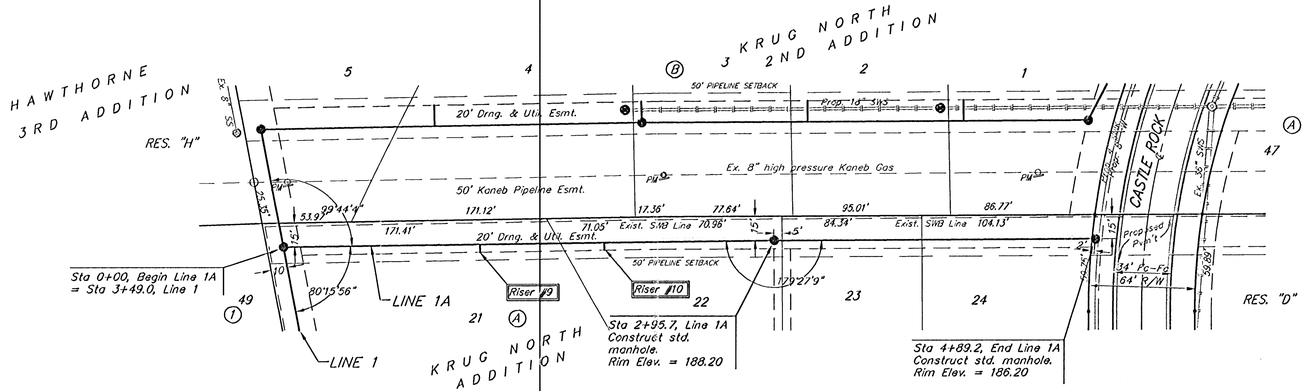


Scale: 1" = 40' Horizontal
1" = 5' Vertical
• = Iron

SEWER SERVICE TABLE

NUMBER	TYPE	LOCATION				FOR INFORMATION ONLY	
		LOT NO.	BLOCK NO.	LINE NO.	STATION \ DIRECTION	APPROXIMATE LENGTH 4" PIPE VERTICAL	HORIZONTAL
9	8" X 4" Tee	21	A	1A	1+~~20~~/Rt.← 19	10.0'	5'8'
10	8" X 4" Tee	22	A	1A	1+~~95~~/Rt.← ~~24~~	10.0'	5'8'

NOTE: Vertical Riser Pipe shall be extended to 2' minimum above ground water elevation and 4' maximum below proposed ground elevation.

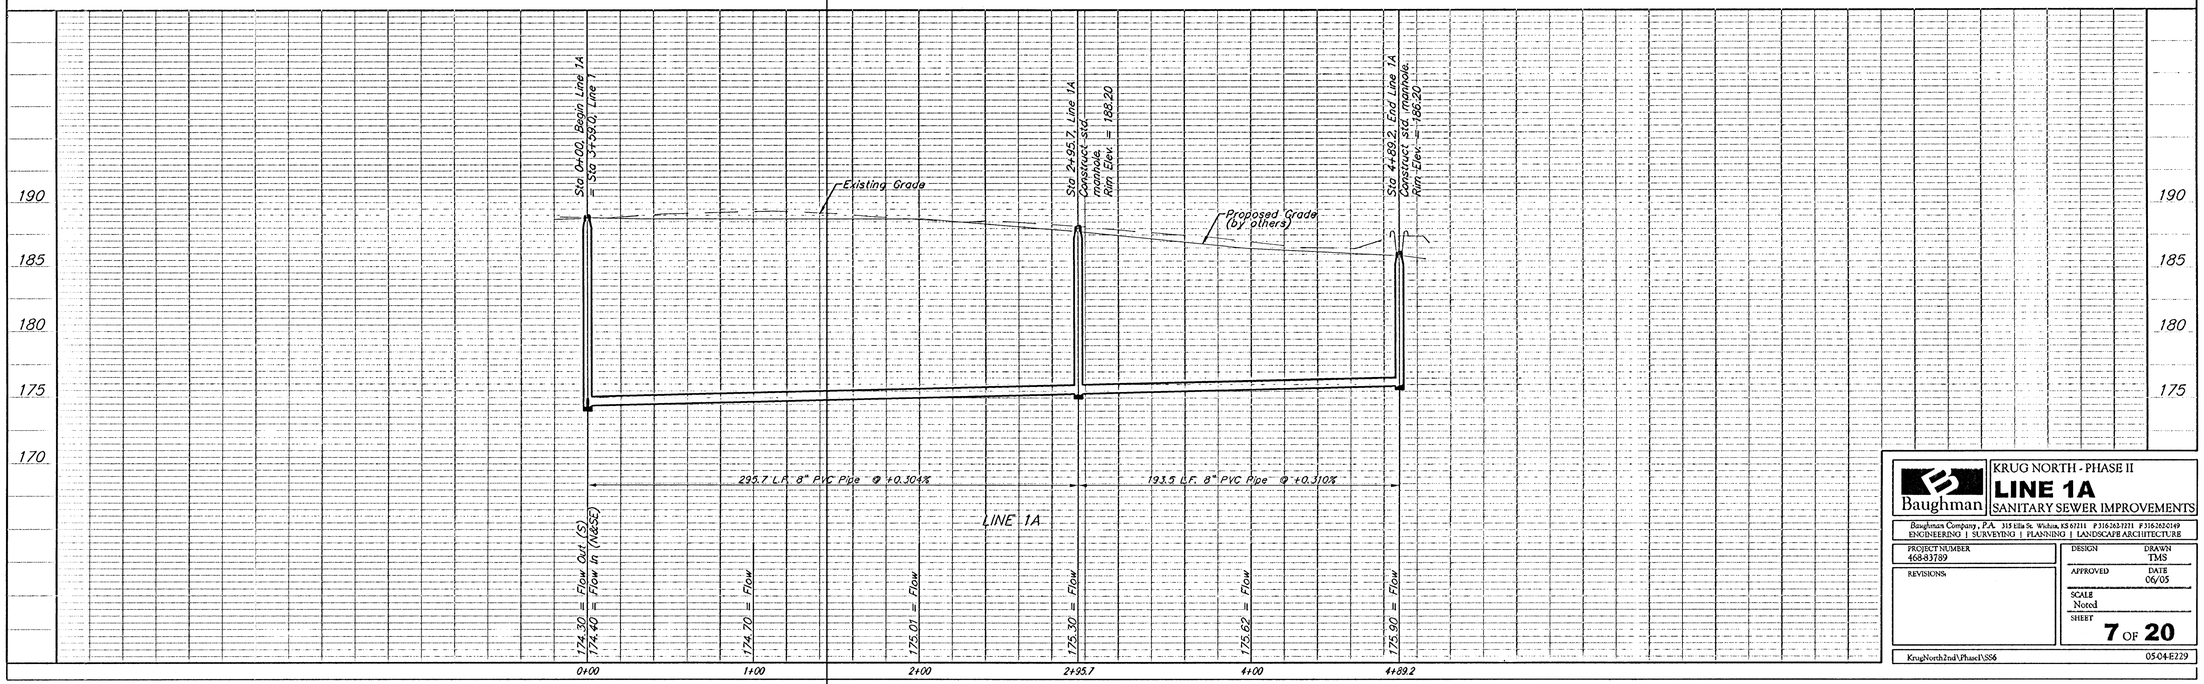

Baughman

KRUG NORTH - PHASE II
LINE 1A
SANITARY SEWER IMPROVEMENTS

Baughman Company, P.A. 315 Ella St. Wichita, KS 67211 P 316.263.7271 F 316.263.0149
ENGINEERING | SURVEYING | PLANNING | LANDSCAPE ARCHITECTURE

PROJECT NUMBER 468-83789
DESIGN
DRAWN TMS
APPROVED
DATE 06/05
REVISIONS
SCALE Noted
SHEET 7 OF 20

KrugNorth2nd\Phase1\SS6 0504E229