


PLAN	CHECKED	DATE

PROFILE	CHECKED	DATE

DSNR, MDK, OPER, CSI, SCALE: 1"=40.00
 01/2004/04219/002/SSPP10 ChangeOrderNo1 09-19-2005 05:02:06 pm

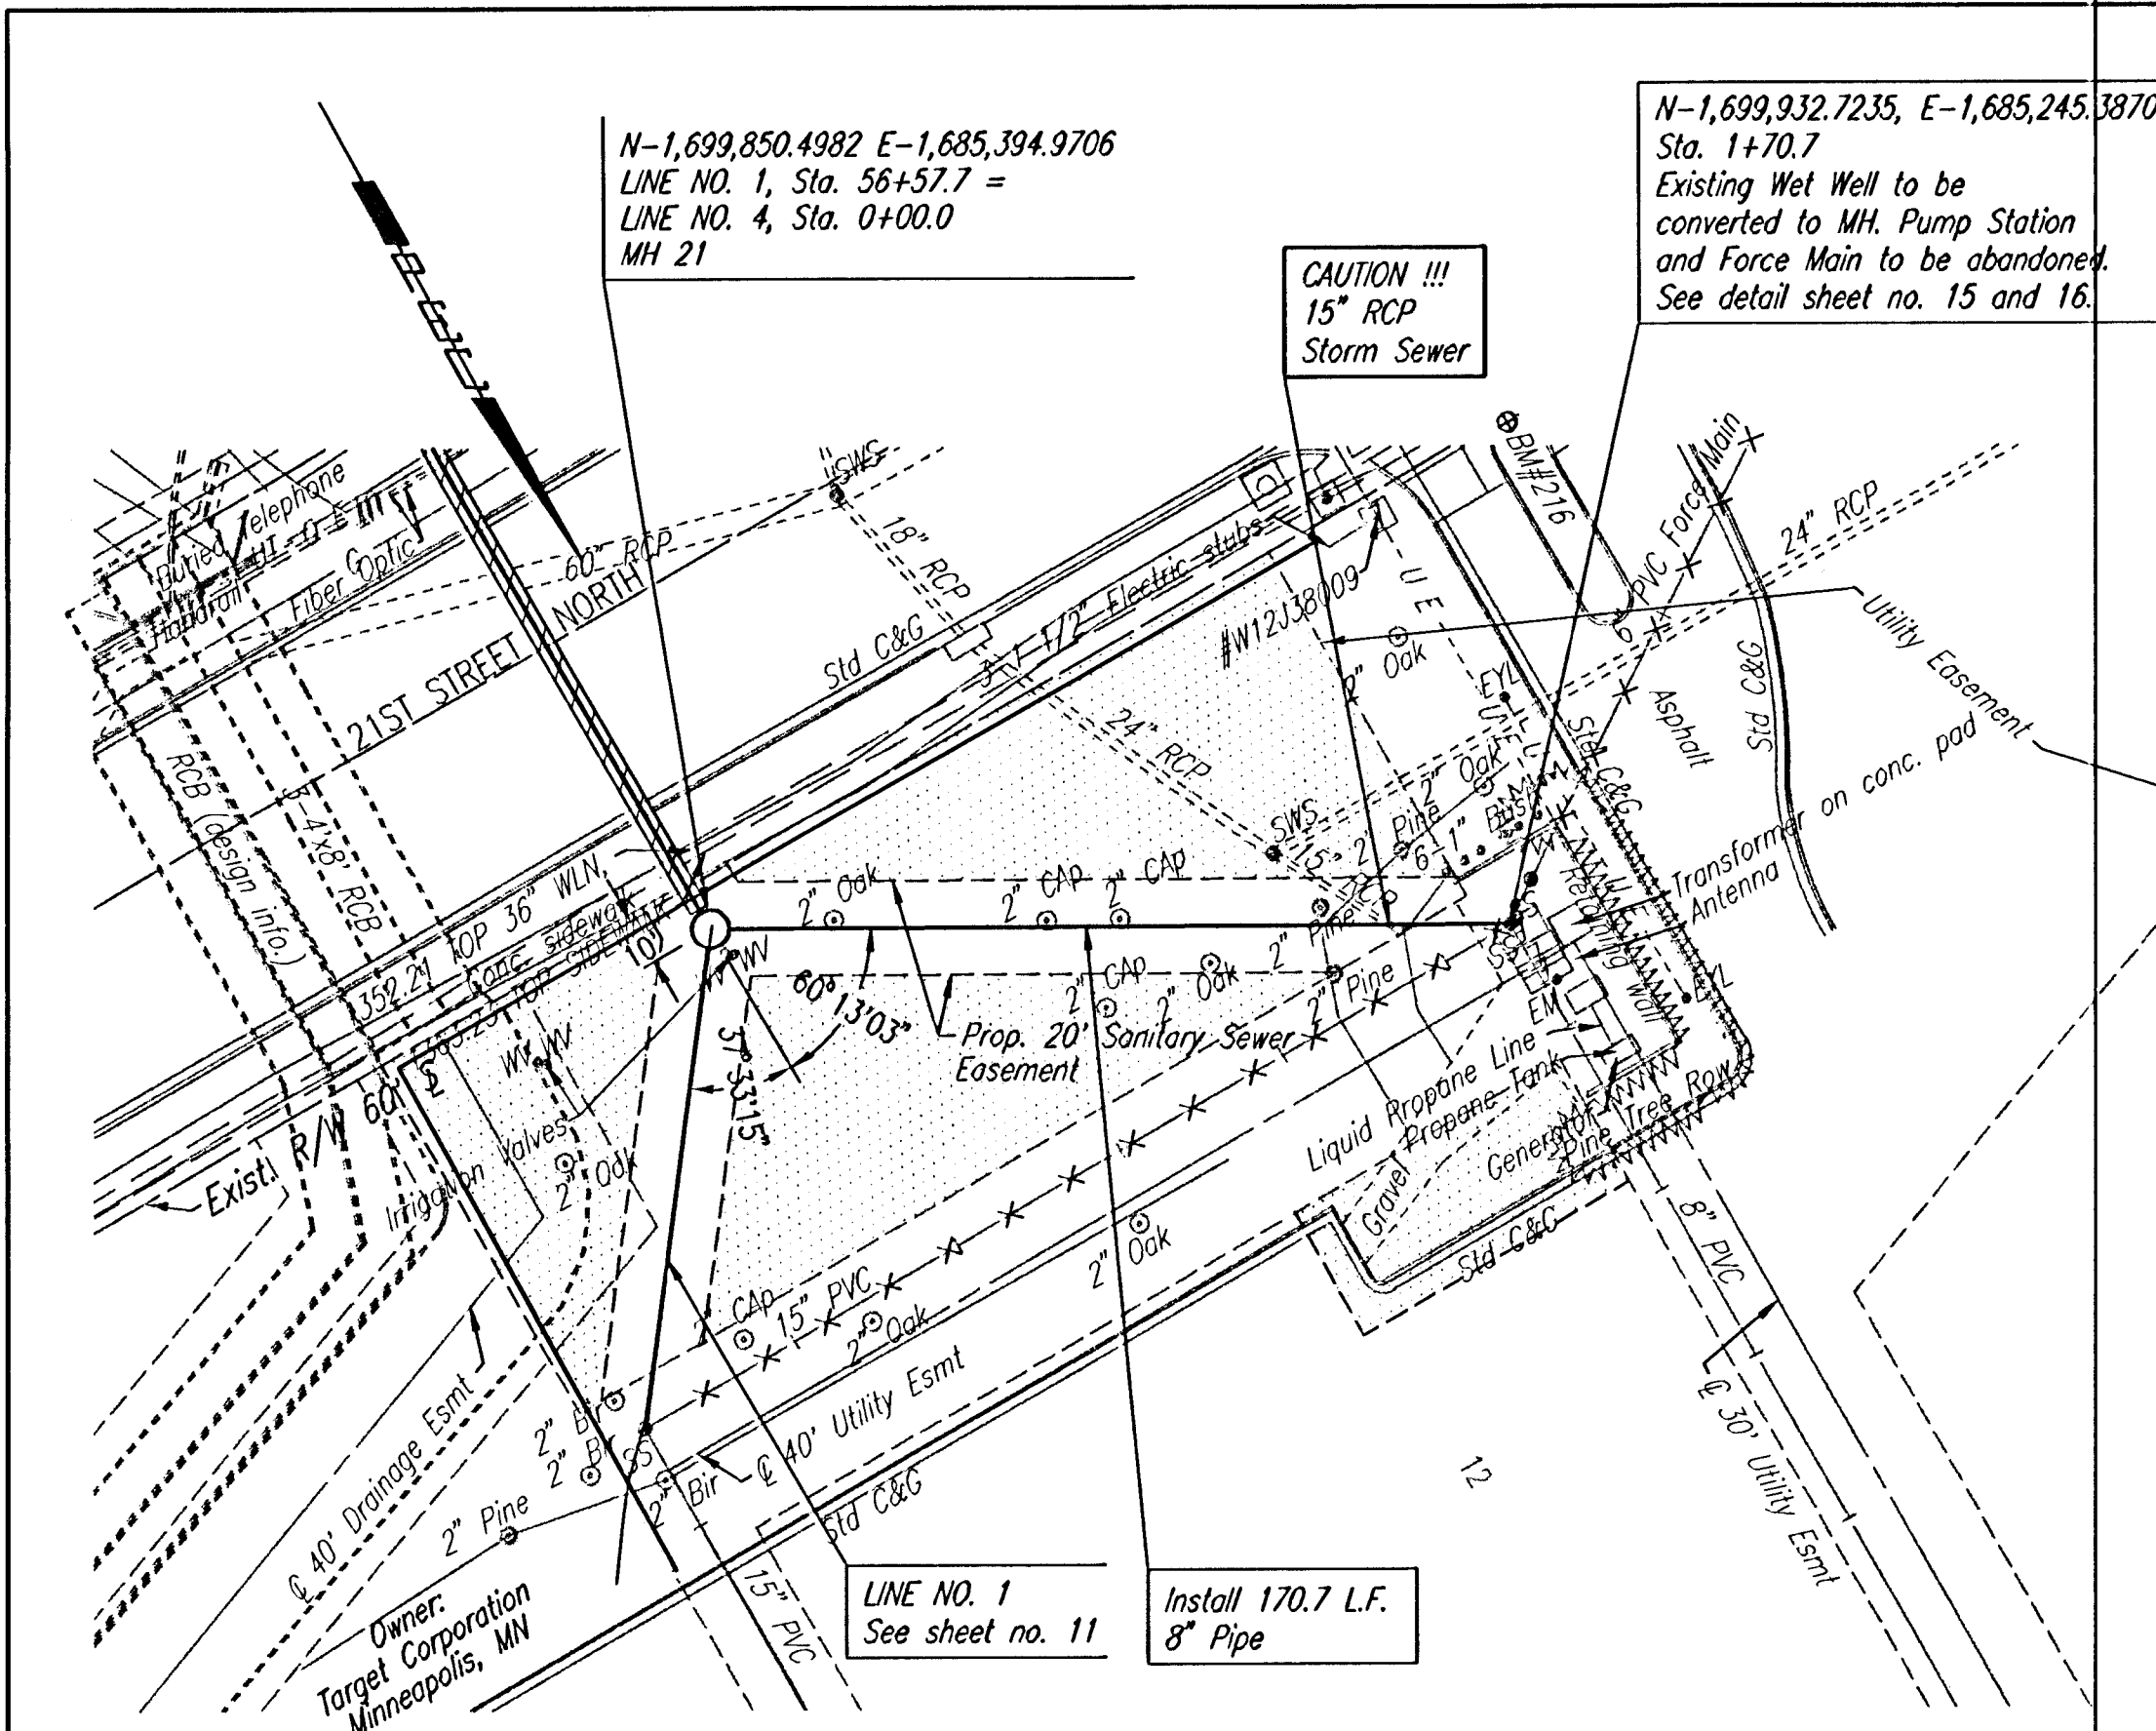


SANITARY SEWER LINE NO. 4

TEMPORARY CONSTRUCTION EASEMENT


X DENOTES SANITARY SEWER TO BE ABANDONED IN PLACE.

SANITARY SEWER LINE NO. 5

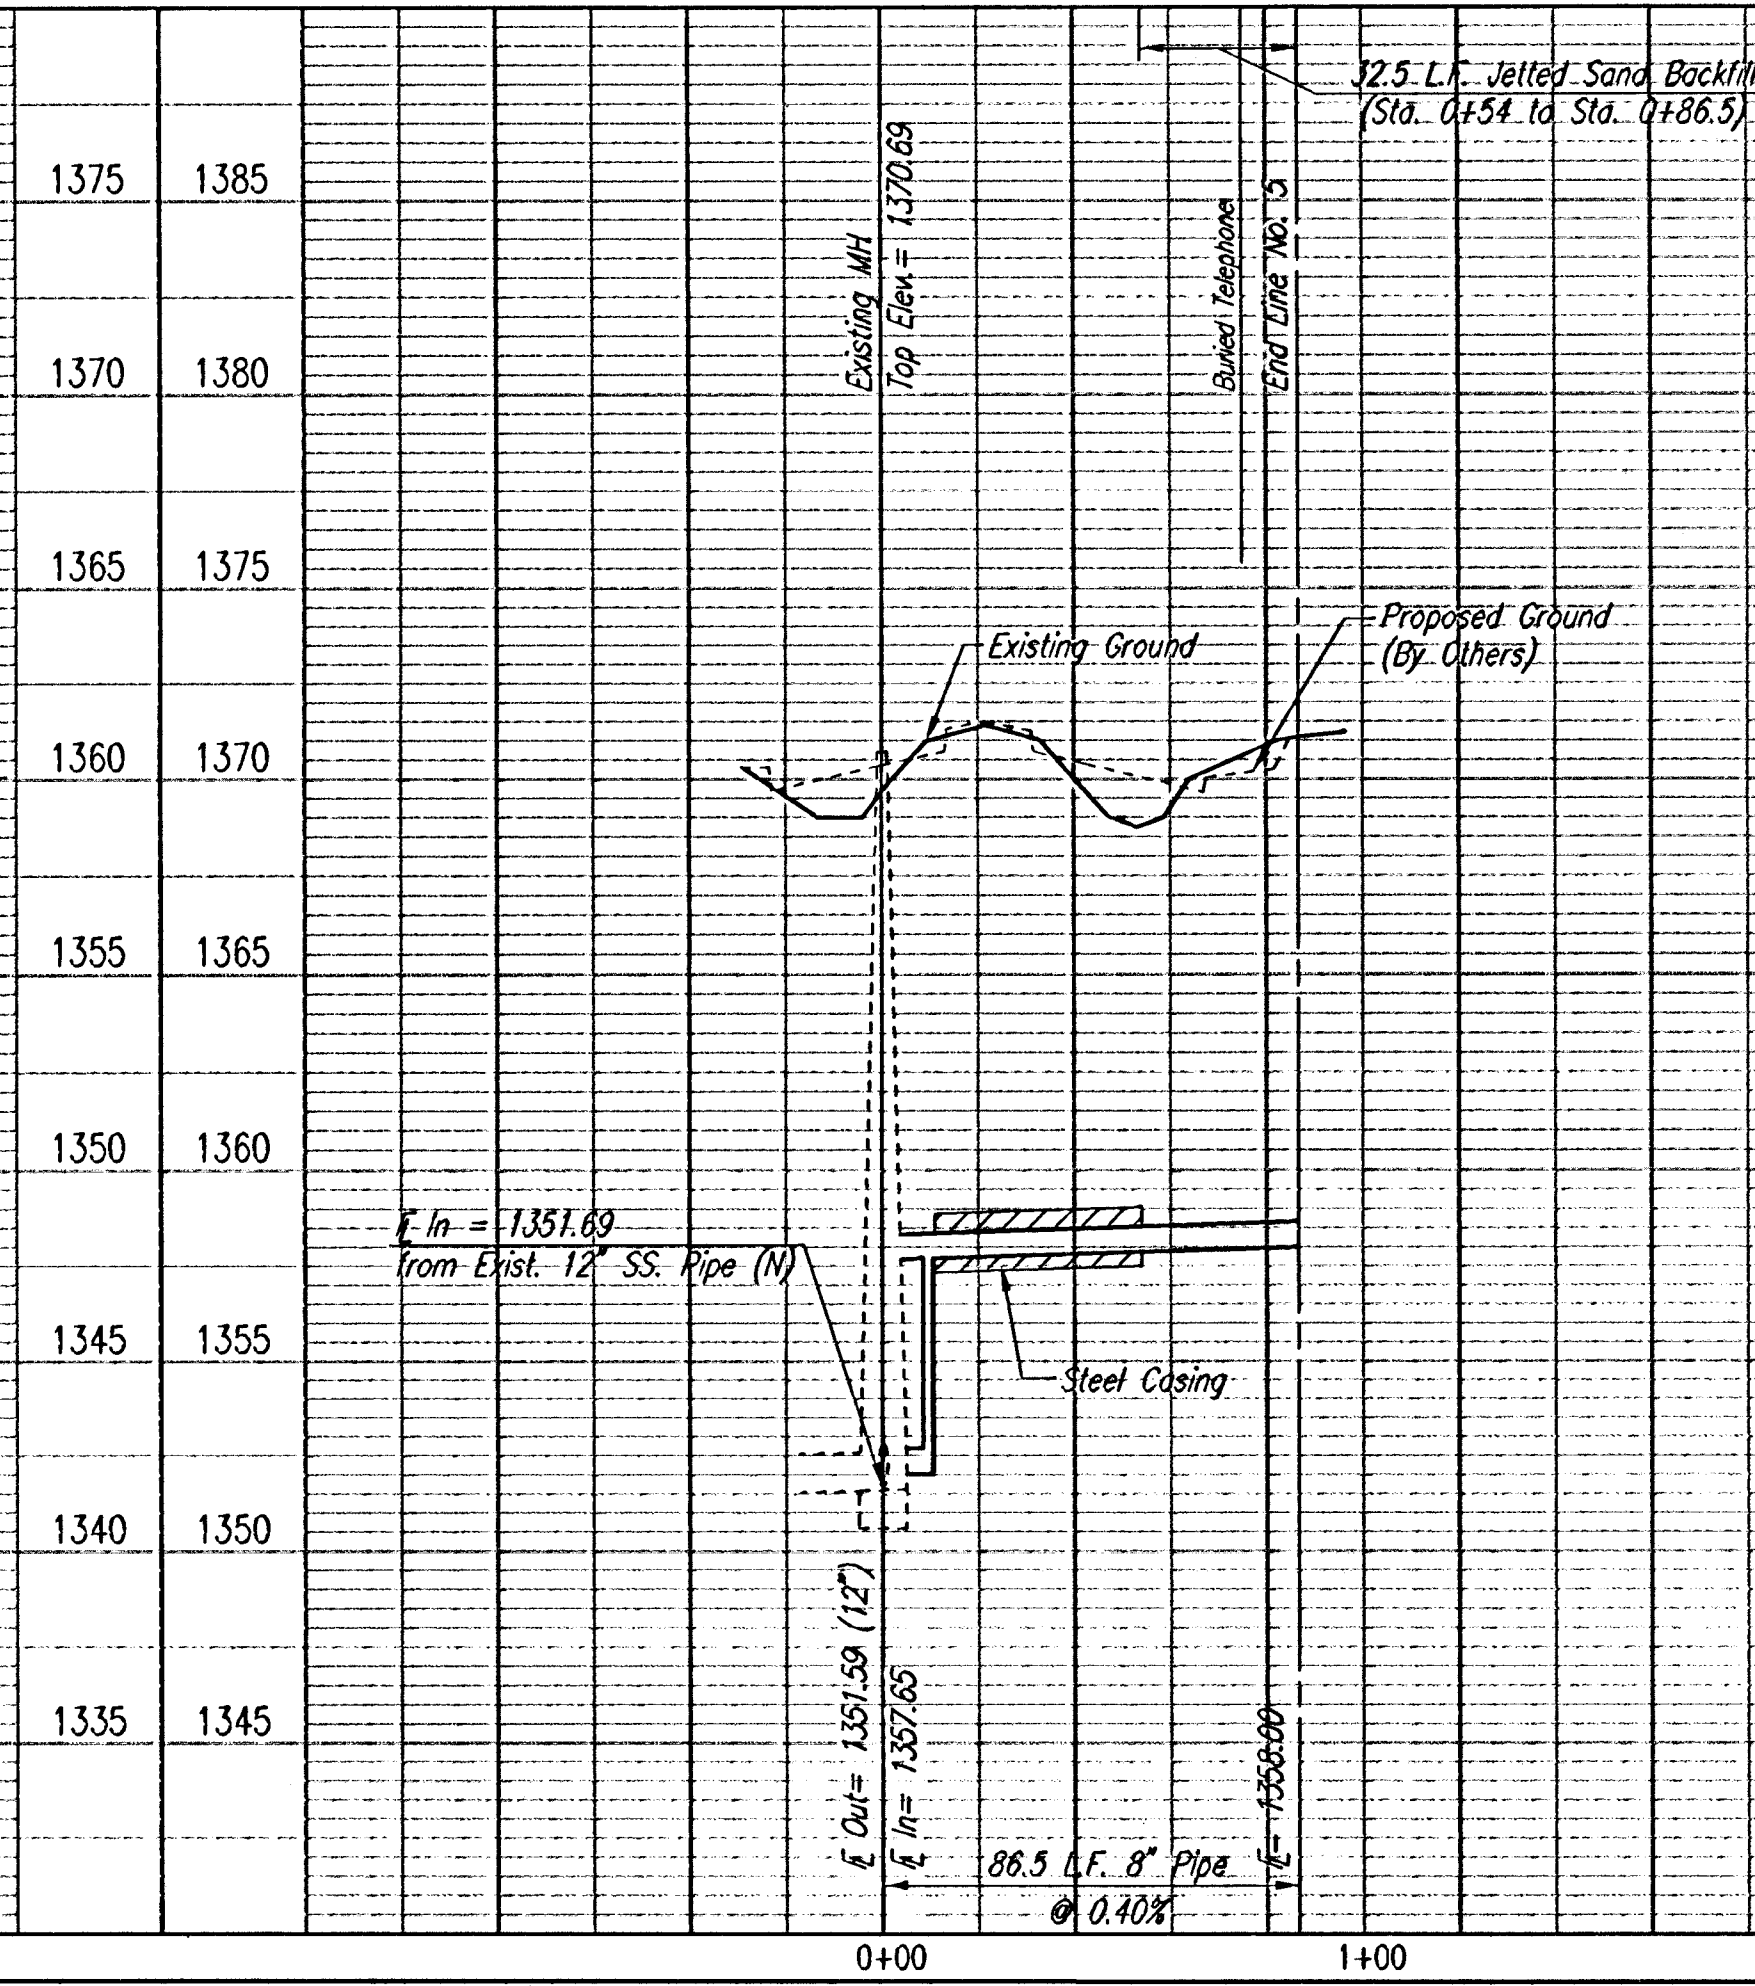

NOTE: SEE GENERAL NOTES ON SHEET NO. 2 FOR TRAFFIC CONTROL REQUIREMENTS. LANE CLOSURE NOT TO EXCEED 2 DAYS

SANITARY SEWER LINE NO. 6

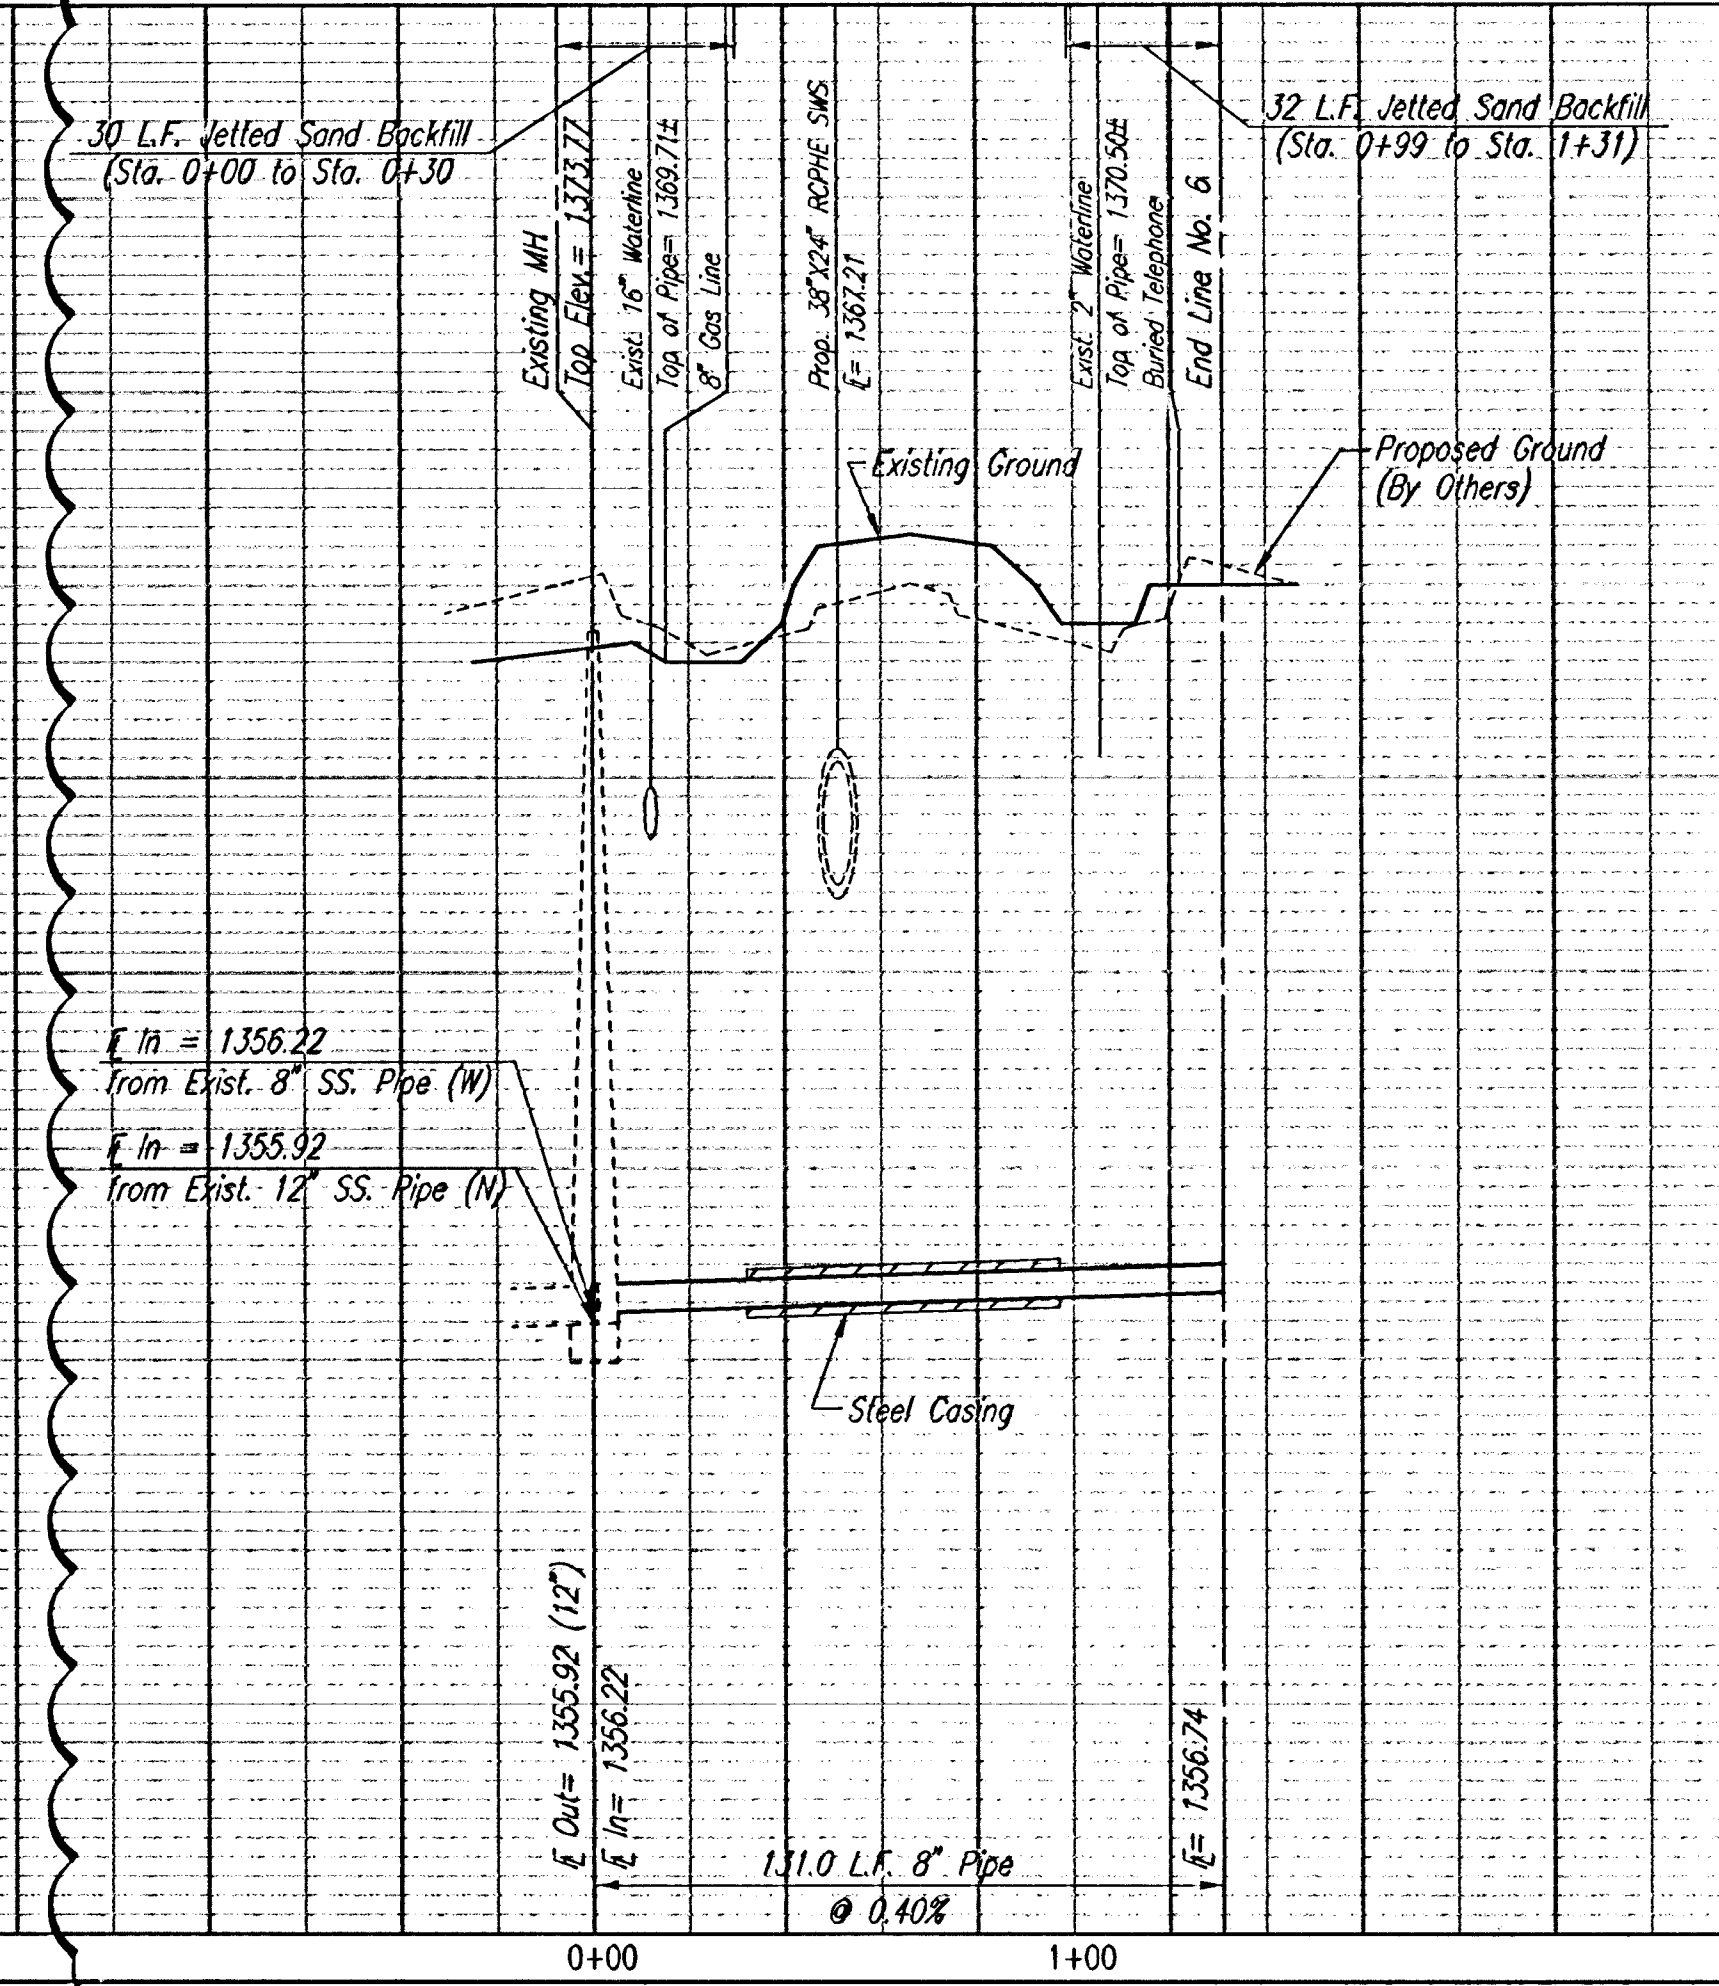

CHANGE ORDER NO. 1



MAIN 16 OF THE
 FOUR MILE CREEK SEWER
 SANITARY SEWER LINE NO. 4,
 NO. 5, AND NO. 6
 JAMES L. ARMOUR, P.E. - CITY ENGINEER
 CITY OF WICHITA PROJECT NO. 405-3503

Professional Engineering Consultants, P.A.
 303 S. TOPICKA • WICHITA, KANSAS 67202
 316-262-2691 • FAX 316-262-3003
 Designed By MDK
 Drawn By JCA, TRD
 Job No. 35-04219-002
 Date MAY 2004