


BENCHMARKS

BM #1: Brass Plate on North Hub Guard of R.C.B.C. 50' East of NW Corner NE 1/4, Sec. 22, Twp. 26-S, R-1-E.
Elev. = 1371.83 (NGVD29)

BM #2: "X" cut on East Hub Guard of R.C.B.C. 110' S. of the SE Cor., SE 1/4, Sec. 22, Twp. 26-S, R-1-E.
Elev. = 1359.54 (NGVD29)

Sta 0+00, Begin Line 1
Core into existing manhole and extend 10" pipe north west. Seal & grout around pipe and reshape invert. Cost to be incidental to "Site Clearing & Restoration" bid item.

Contractor to fill within 2' of Manhole Top and for 10' around Manhole and sewer line, grading back to existing ground at a 3:1 slope. Cost to be included in "Site Clearing & Restoration" bid item.

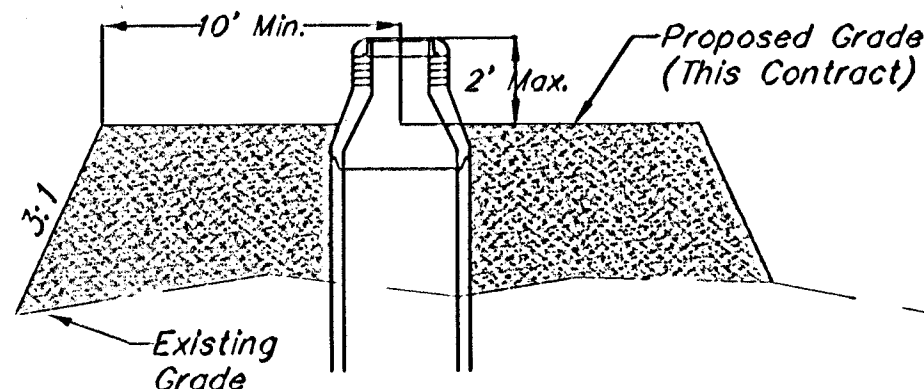

Fill Detail
Not to Scale

Sta 2+04.8, Line 1
Construct Std. Manhole
(5' Dia)
1 - 8" Stub (SW)
Top Elev. = 1350.40

Sta 2+74.9, Line 1
Construct Std. Manhole
(5' Dia)
1 - 4" Stub (NE)
Top Elev. = 1350.90

Sta 5+06.6, Line 1
Construct Std. Manhole
(5' Dia)
1 - 4" Stub (NE)
Top Elev. = 1352.30

Sta 6+73.2, Line 1
Construct Std. Manhole
(5' Dia)
Top Elev. = 1352.60
Match Point

All material and construction of Line 1, beyond Sta. 6+20.00 shall be included in bid for City of Wichita Project #468-84065

Remove trees only as necessary for sanitary sewer construction and only with permission of Developer or Baughman Co. Cost of removal to be incidental to lump sum bid item "Site Clearing & Restoration".

All excavation for Line 1, from Station 2+04.8 to Station 6+73.2, shall be sand backfilled to within two feet of existing grade. The sand shall be vibrated and water jatted during backfilling. Cost shall be incidental to pipe cost.

SEWER SERVICE TABLE


NUMBER	TYPE	LOCATION			STATION\ DIRECTION	FOR INFORMATION ONLY	
		LOT NO.	BLOCK NO.	LINE NO.		APPROXIMATE LENGTH 4" PIPE	
1	10" x 4" Tee Saddle	5	C	1	1+60/Rt.	14.5'	5'
2	4" x 4" Tee Saddle	6	C	1	2+75/Rt.	15.5'	10'
3	10" x 4" Tee Saddle	7	C	1	3+52/Rt.	18.0'	10'

NOTE: Vertical Riser Pipe shall be extended to 2' minimum above ground water elevation and 4' maximum below proposed ground elevation.

SEWER SERVICE TABLE

NUMBER	TYPE	LOCATION			STATION\ DIRECTION	FOR INFORMATION ONLY	
		LOT NO.	BLOCK NO.	LINE NO.		APPROXIMATE LENGTH 4" PIPE	
4	10" x 4" Tee Saddle	8	C	1	4+32/Rt.	16.0'	10'
5	4" x 4" Tee Saddle	9	C	1	5+07/Rt.	16.5'	15'
6	10" x 4" Tee Saddle	10	C	1	5+97/Rt.	16.0'	4'

NOTE: Vertical Riser Pipe shall be extended to 2' minimum above ground water elevation and 4' maximum below proposed ground elevation.

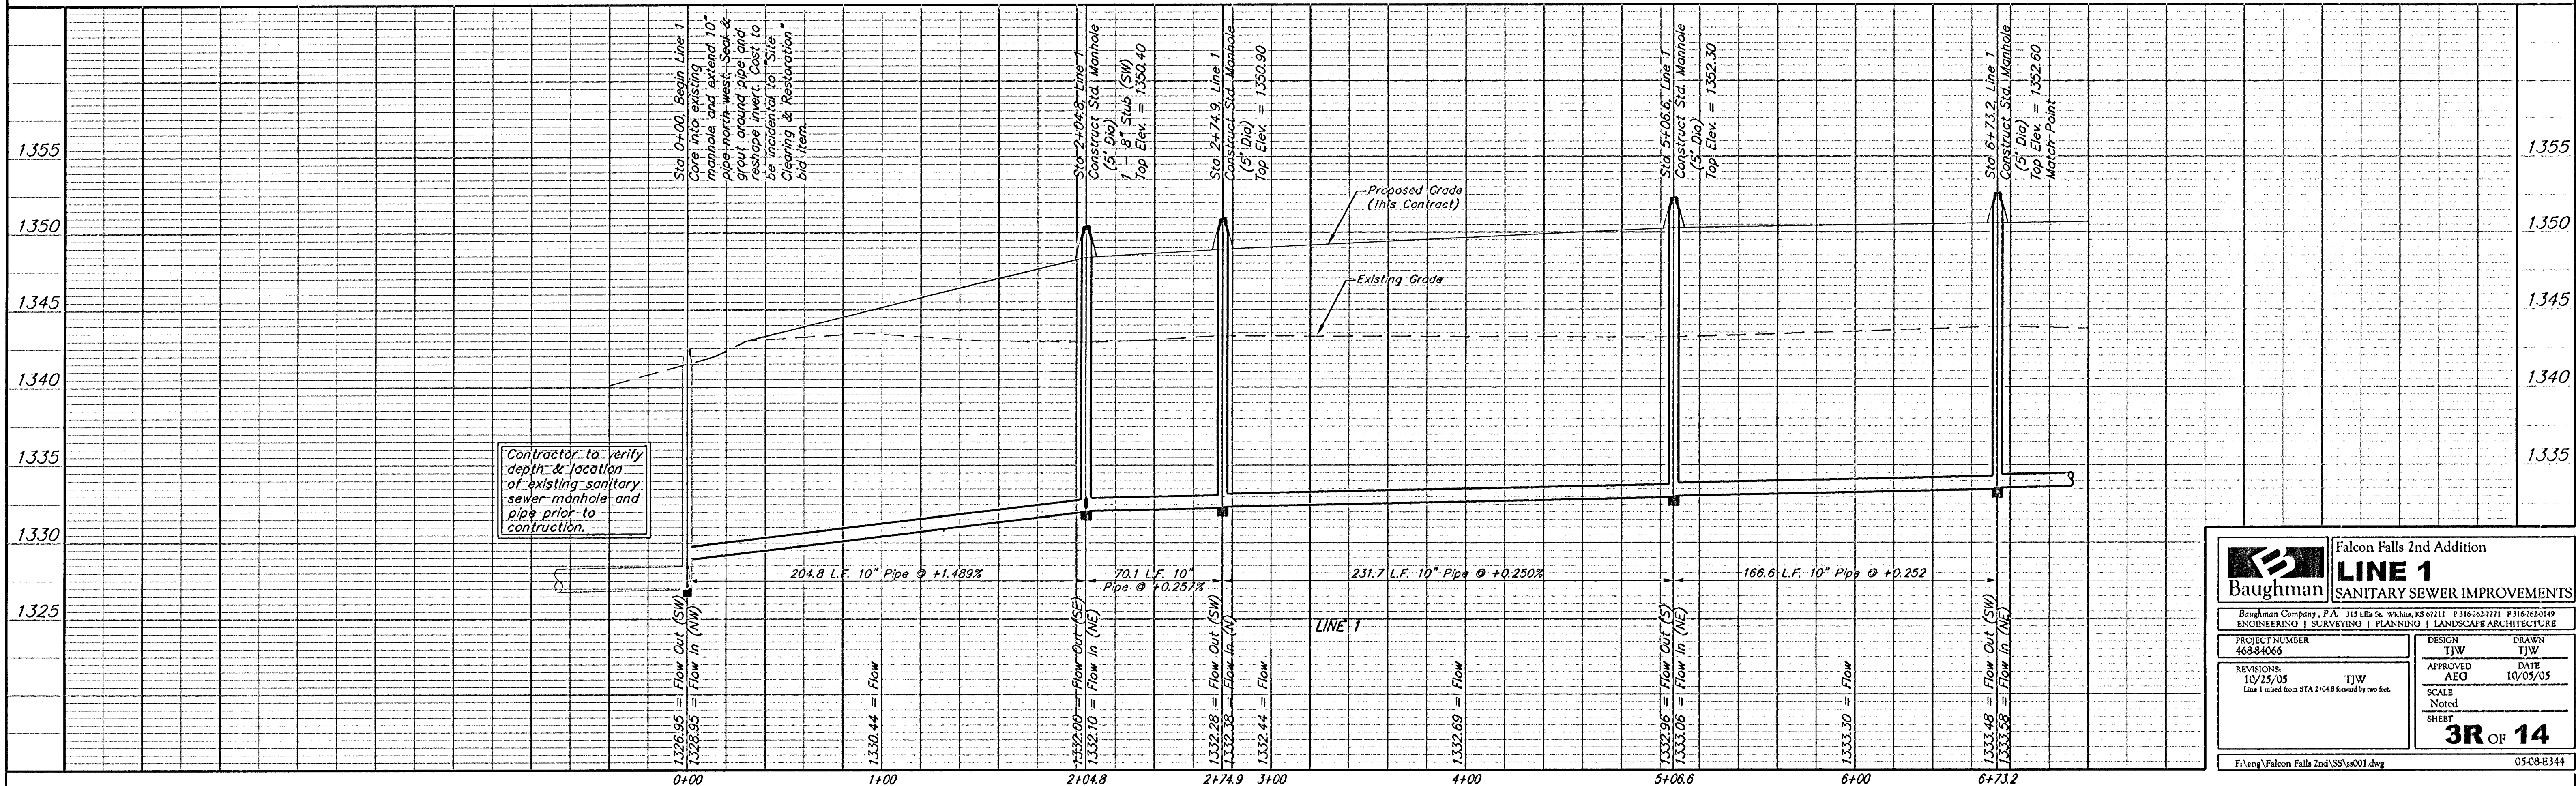



Falcon Falls 2nd Addition

LINE 1

SANITARY SEWER IMPROVEMENTS

Baughman Company, P.A. 315 Lila St. Wichita, KS 67211 P 316-262-7771 F 316-262-0149

ENGINEERING | SURVEYING | PLANNING | LANDSCAPE ARCHITECTURE

PROJECT NUMBER	468-84066	DESIGN	TJW	DRAWN	TJW
REVISIONS	10/25/05	APPROVED	ASO	DATE	10/05/05
Line 1 moved from STA 2+04.8 to STA 1+60.0 by two feet.		SCALE	Noted		
		SHEET	3R	OF 14	

F:\eng\Falcon Falls 2nd\SS\ss001.dwg 0508E344