

BENCHMARKS

BM #1: Brass Plate on North
Hub Guard of R.C.B.C. 50' East of
NW Corner NE 1/2, Sec. 22, Twp.
26-S, R-1-E.
Elev. = 1371.83 (NGVD29)

BM #2: "X" cut on East Hub
Guard of R.C.B.C. 110' S. of the
SE Cor., SE 1/4, Sec. 22, Twp.
26-S, R-1-E.
Elev. = 1359.54 (NGVD29)

SEWER SERVICE TABLE

NUMBER	TYPE	LOCATION				FOR INFORMATION ONLY	
		LOT NO.	BLOCK NO.	LINE NO.	STATION\ DIRECTION	APPROXIMATE LENGTH 4" PIPE	
1	10" x 4" Tee Saddle	1	A	1	1+83/Rt.	16.5'	10'
2	4" Riser w/ Stub	2	A	1	1+88.9/Rt.	16.5'	10'
3	10" x 4" Tee Saddle	3	A	1	2+71/Rt.	16.0'	10'
4	10" x 4" Tee Saddle	4	A	1	3+47/Rt.	14.5'	10'
5	10" x 4" Tee Saddle	5	A	1	4+22/Rt.	13.5'	10'
6	10" x 4" Tee Saddle	6	A	1	4+98/Rt.	12.0'	10'

NOTE: Vertical Riser Pipe shall be extended to 2' minimum above ground water elevation and 4' maximum below proposed ground elevation.



SEWER SERVICE TABLE

NUMBER	TYPE	LOCATION				FOR INFORMATION ONLY	
		LOT NO.	BLOCK NO.	LINE NO.	STATION\ DIRECTION	APPROXIMATE LENGTH 4" PIPE	
7	10" x 4" Tee Saddle	7	A	1	5+74/Rt.	10.0'	10'
8	10" x 4" Tee Saddle	8	A	1	6+50/Rt.	9.0'	10'
9	10" x 4" Tee Saddle	9	A	1	8+01/Lt.	9.0'	10'
10	10" x 4" Tee Saddle	10	A	1	8+12/Rt.	9.0'	10'
11	10" x 4" Tee Saddle	11	A	1	8+88/Rt.	9.0'	10'
12	10" x 4" Tee Saddle	12	A	1	9+64/Lt.	9.0'	10'

NOTE: Vertical Riser Pipe shall be extended to 2' minimum above ground water elevation and 4' maximum below proposed ground elevation.



Scale: 1" = 40' Horizontal
1" = 5' Vertical
• = Iron

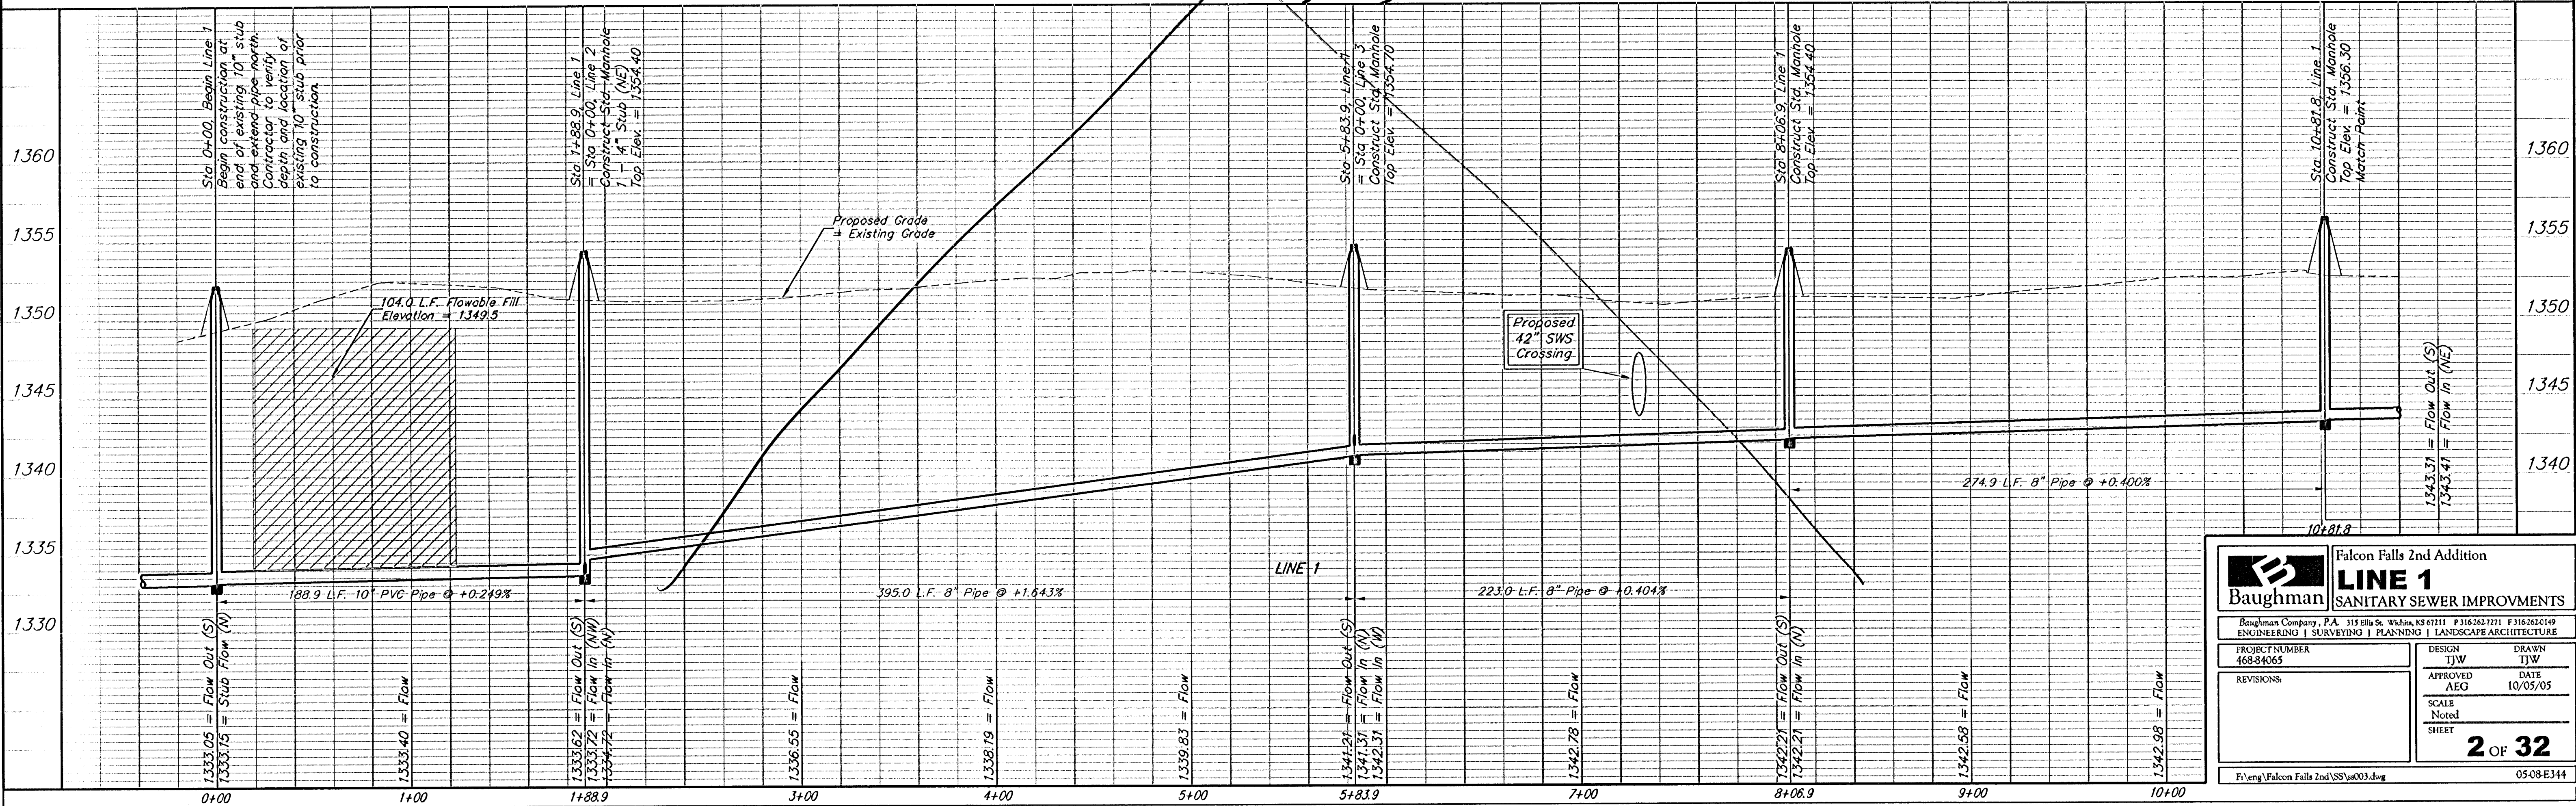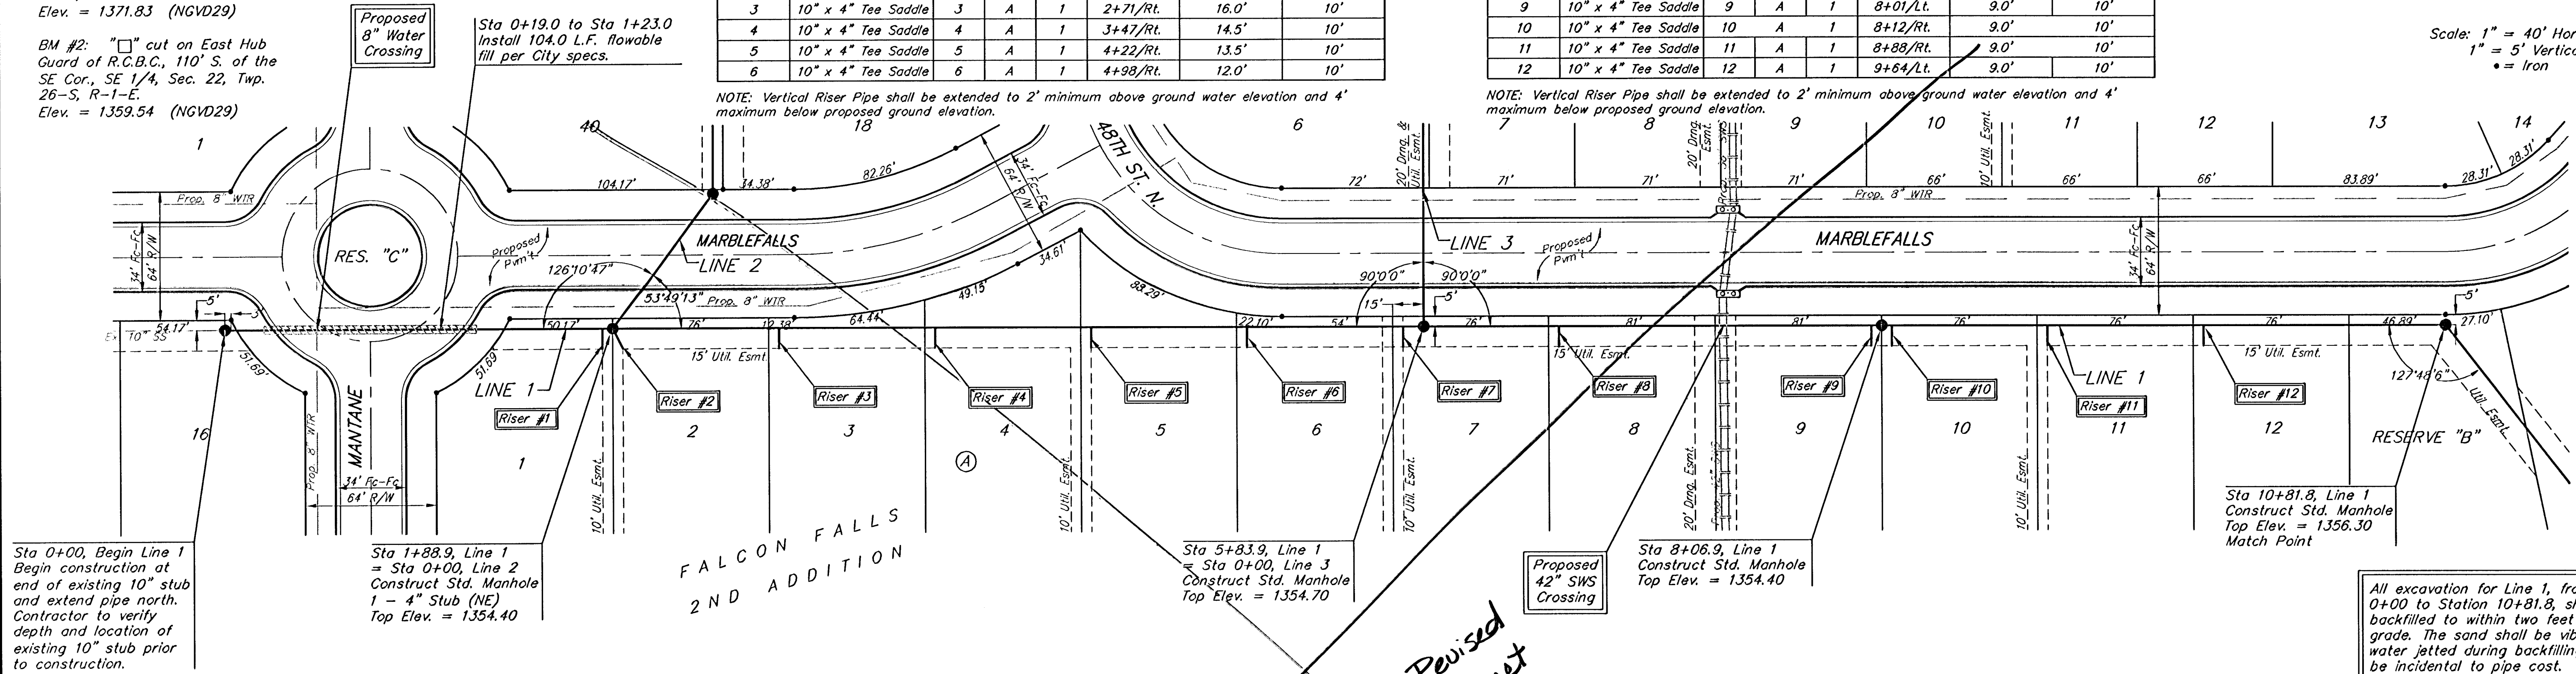



Baughman

Falcon Falls 2nd Addition
LINE 1
SANITARY SEWER IMPROVEMENTS

Baughman Company, P.A. 315 Ellis St. Wichita, KS 67211 P 316-262-7771 F 316-262-0149
ENGINEERING | SURVEYING | PLANNING | LANDSCAPE ARCHITECTURE

PROJECT NUMBER
468-84065

DESIGN
TJW

DATE
10/05/05

REVISIONS

APPROVED
AFG

SCALE
Noted

SHEET
2 OF 32

F:\eng\Falcon Falls 2nd\SS\ss003.dwg 05/08/2014