


BENCHMARKS

BM #1: Brass Plate on North  
Hub Guard of R.C.B.C. 50' East of  
NW Corner NE 1/2, Sec. 22, Twp.  
26-S, R-1-E.  
Elev. = 1371.83 (NGVD29)


BM #2: "X" cut on East Hub  
Guard of R.C.B.C., 110' S. of the  
SE Cor., SE 1/4, Sec. 22, Twp.  
26-S, R-1-E.  
Elev. = 1359.54 (NGVD29)



Scale: 1" = 40' Horizontal  
1" = 5' Vertical  
• = Iron

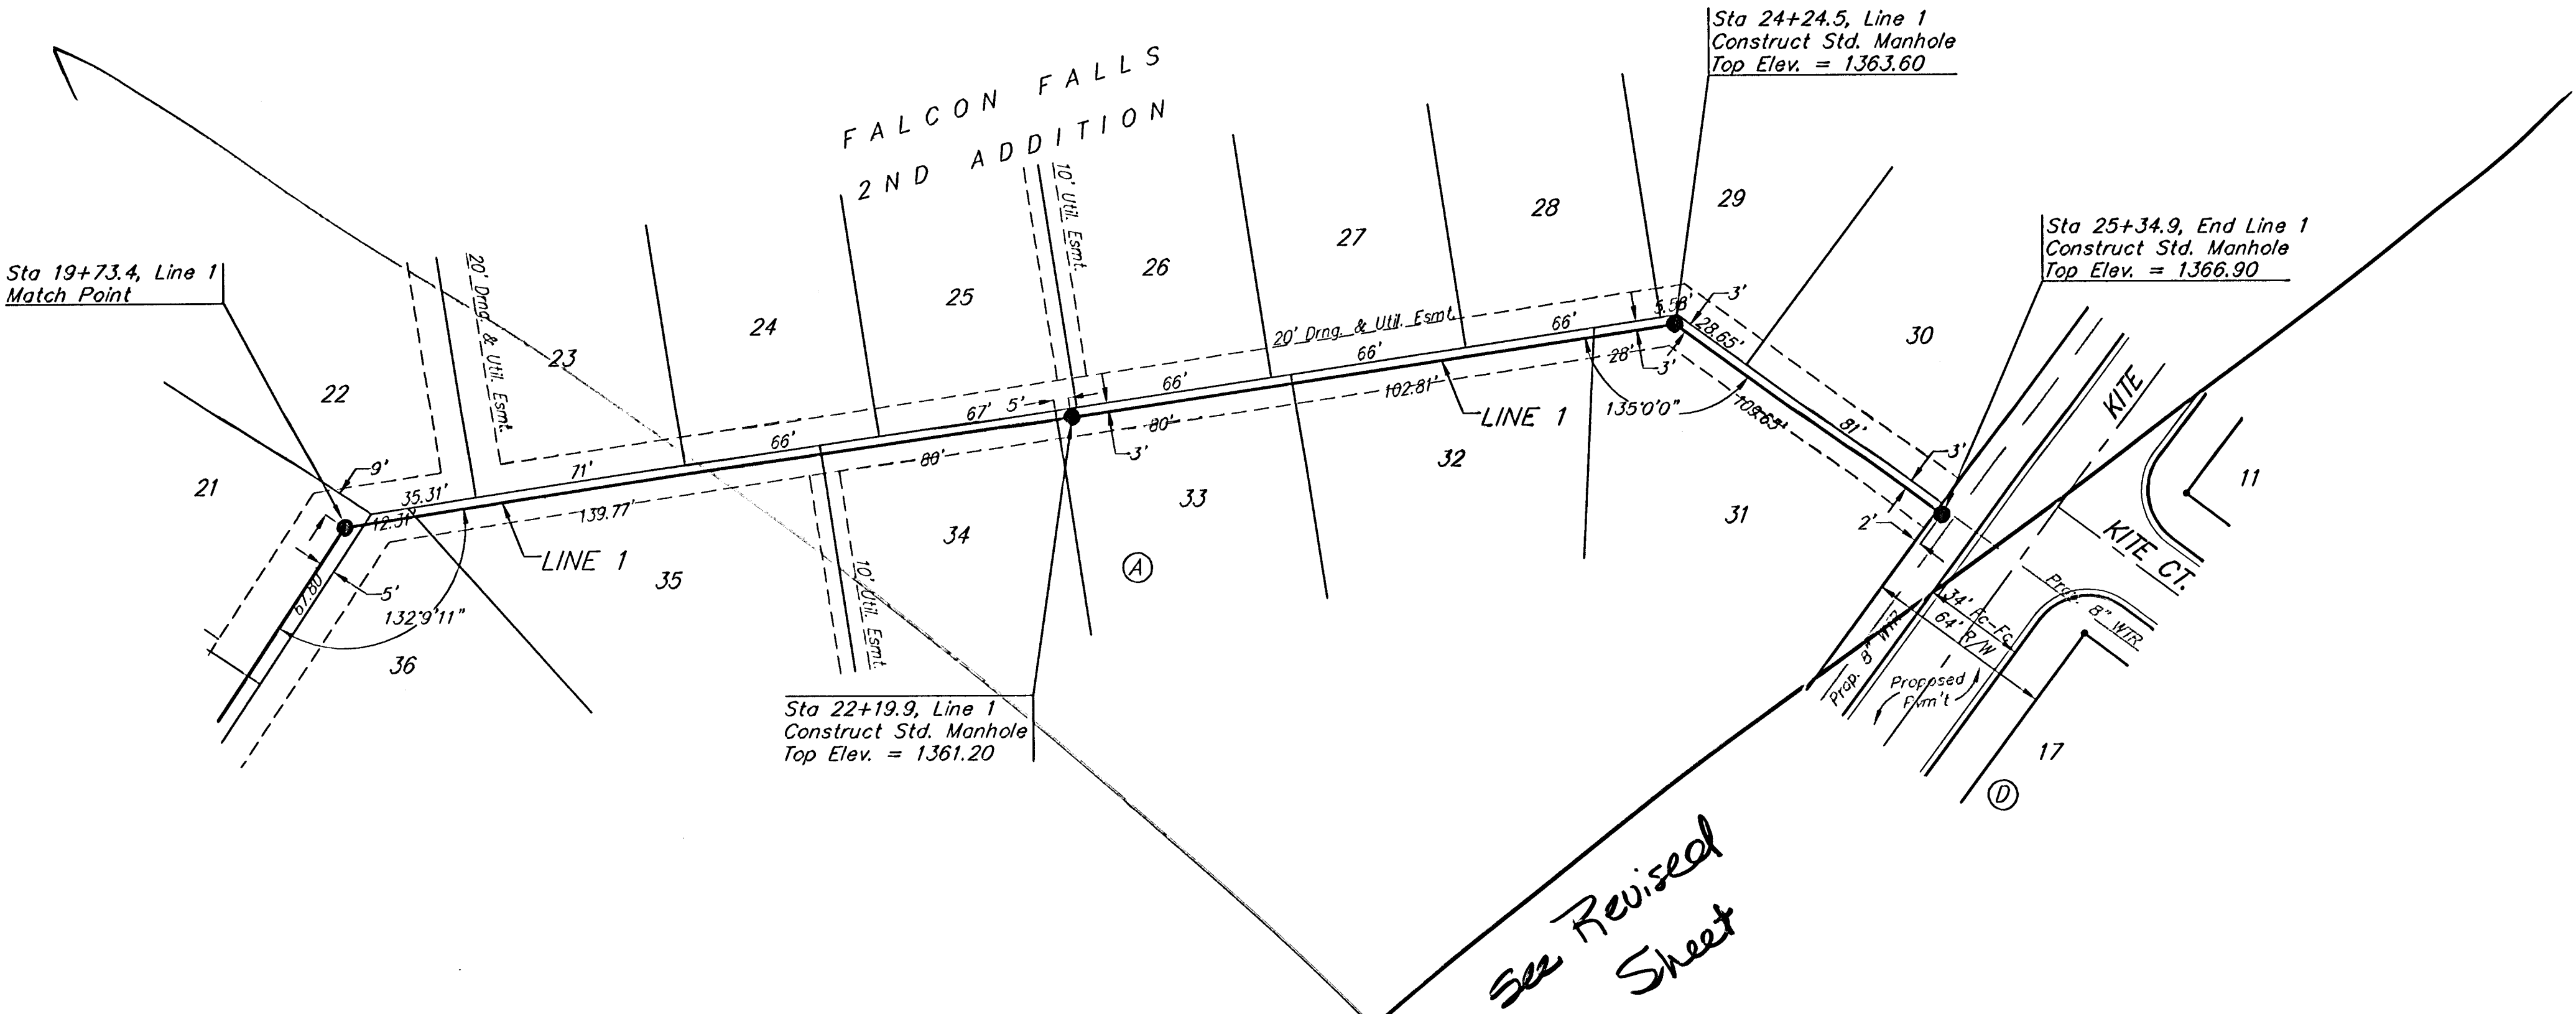

See Revised  
Sheet

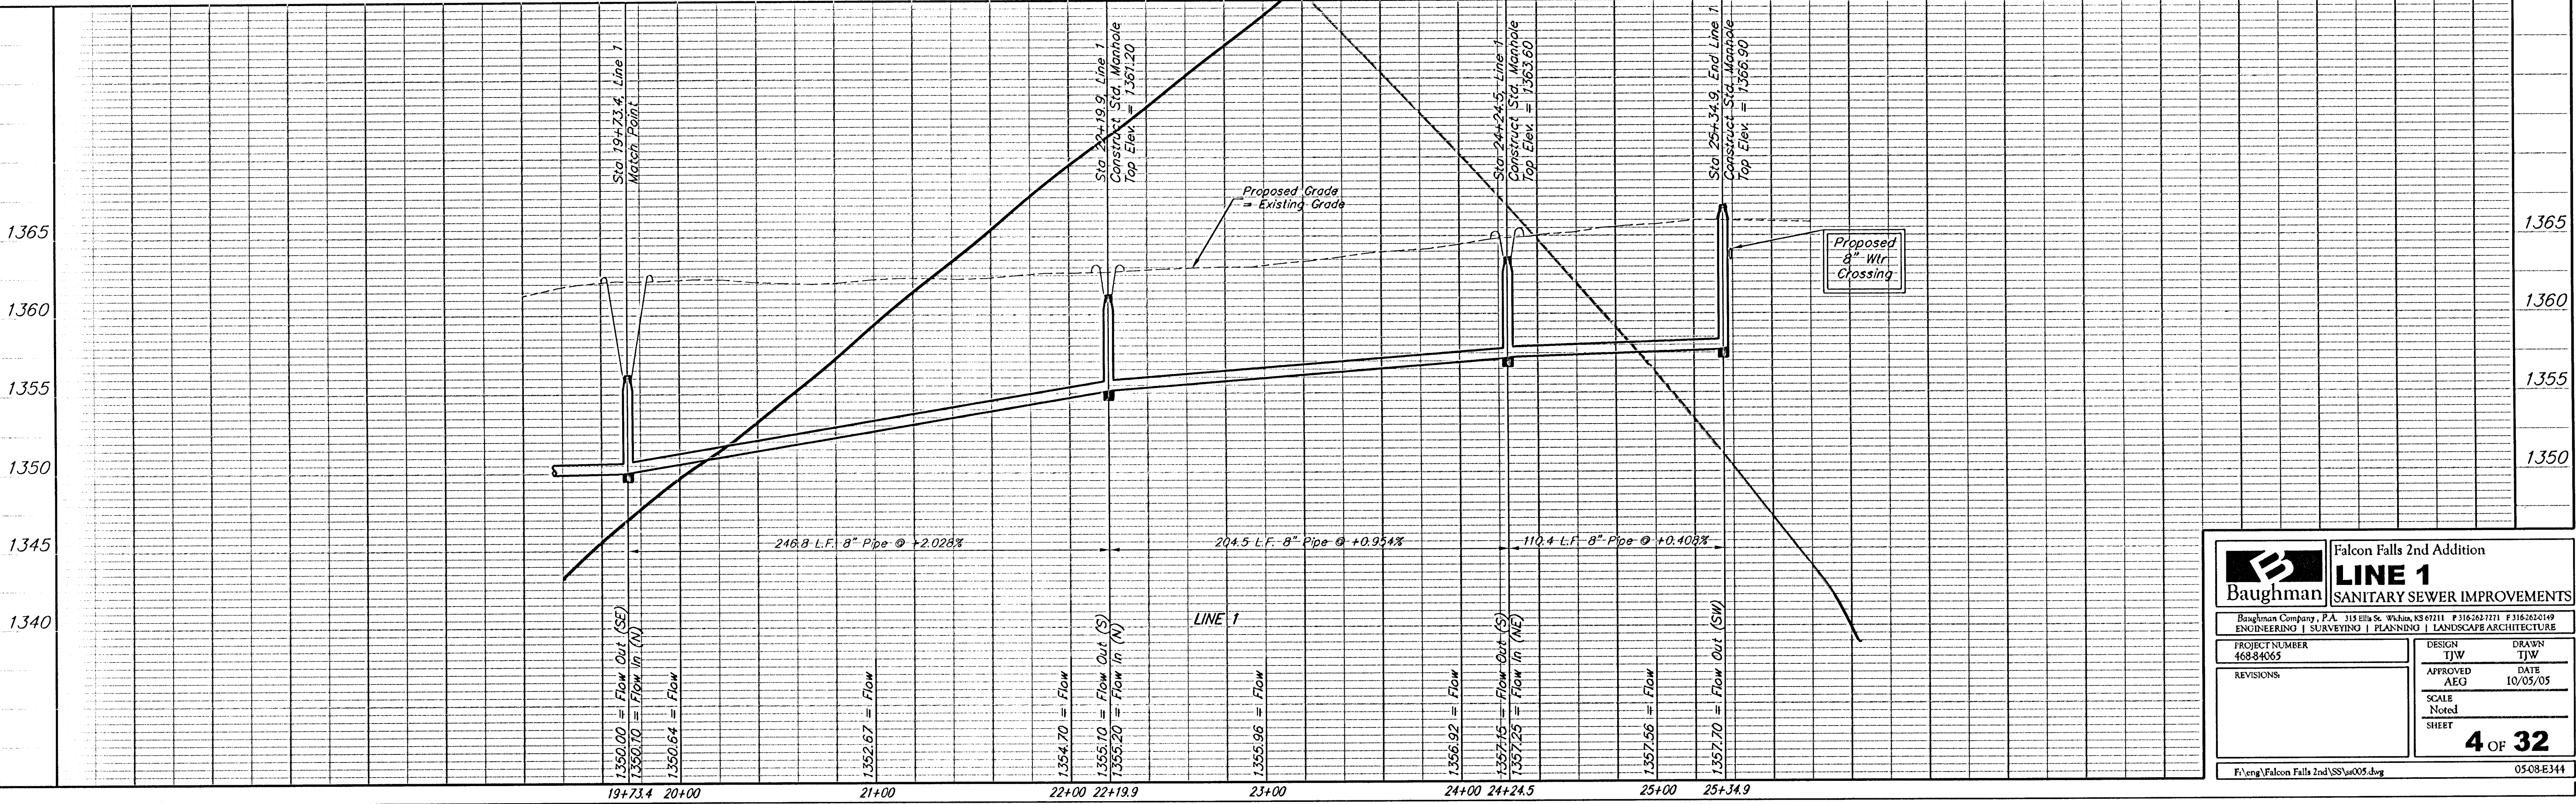

|                                                                                       |  |                             |                  |
|---------------------------------------------------------------------------------------|--|-----------------------------|------------------|
|  |  | Falcon Falls 2nd Addition   |                  |
| Baughman                                                                              |  | <b>LINE 1</b>               |                  |
| ENGINEERING   SURVEYING   PLANNING   LANDSCAPE ARCHITECTURE                           |  | SANITARY SEWER IMPROVEMENTS |                  |
| PROJECT NUMBER<br>46884065                                                            |  | DESIGN<br>TJW               | DRAWN<br>TJW     |
| REVISIONS                                                                             |  | APPROVED<br>AEG             | DATE<br>10/05/05 |
|                                                                                       |  | SCALE<br>Noted              |                  |
|                                                                                       |  | <b>4 OF 32</b>              |                  |
| F:\eng\Falcon Falls 2nd\SS\ss005.dwg                                                  |  | 0508-E344                   |                  |