

BENCHMARKS

BM #1: Brass Plate on North Hub Guard of R.C.B.C. 50' East of NW Corner NE 1/2, Sec. 22, Twp. 26-S, R-1-E.
Elev. = 1371.83 (NGVD29)

BM #2: "□" cut on East Hub Guard of R.C.B.C., 110' S. of the SE Cor., SE 1/4, Sec. 22, Twp. 26-S, R-1-E.
Elev. = 1359.54 (NGVD29)

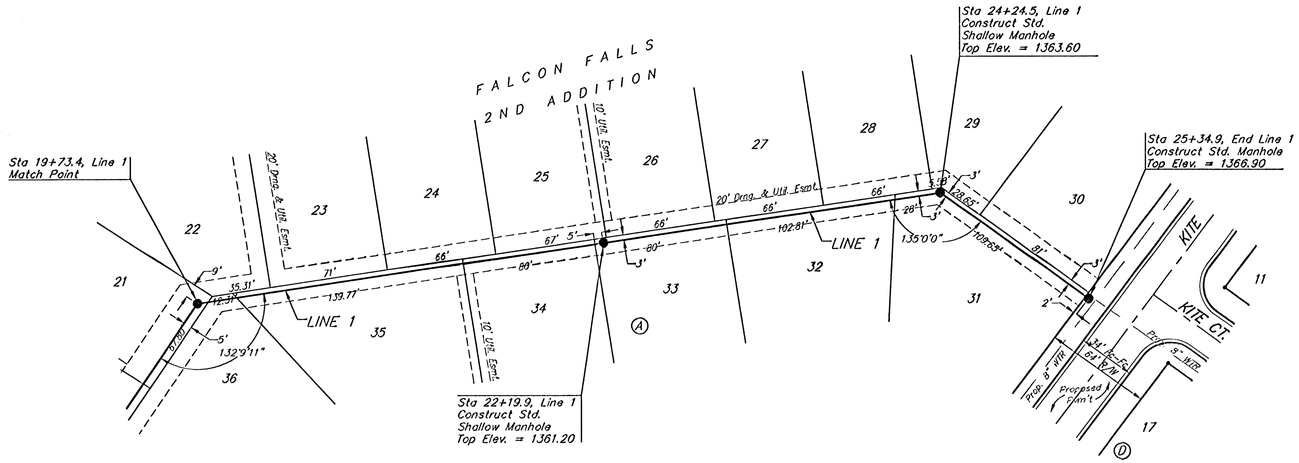

Scale: 1" = 40' Horizontal
1" = 5' Vertical
• = Iron

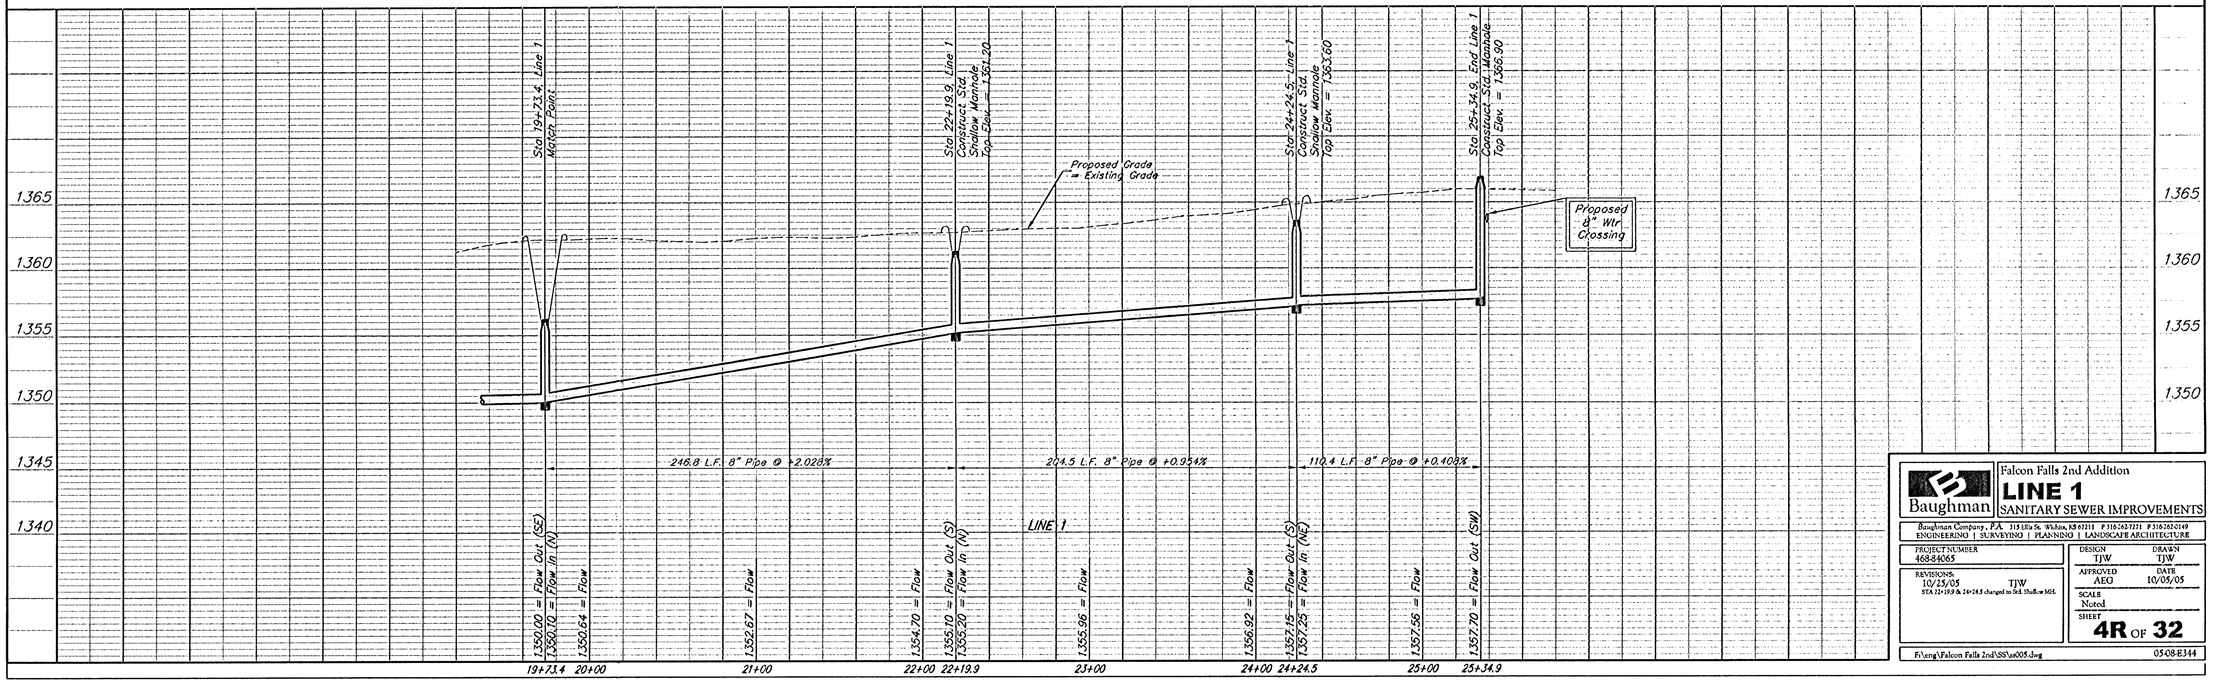

Baughman

Falcon Falls 2nd Addition

LINE 1

SANITARY SEWER IMPROVEMENTS

Baughman Company, P.A. 315 Ellis St. Wichita, KS 67211 P 3162632771 F 3162620149
ENGINEERING | SURVEYING | PLANNING | LANDSCAPE ARCHITECTURE

PROJECT NUMBER 468-84065

DESIGN TJW | DRAWN TJW

REVISIONS 10/25/05 TJW
STA 22+19.9 & 24+24.5 changed to Std. Shallow MH.

APPROVED AEG | DATE 10/05/05

SCALE Noted

SHEET **4R** OF **32**

F:\eng\Falcon Falls 2nd\SS\ss005.dwg

05-08-E344