

BENCHMARKS


BM #1: Brass Plate on North
Hub Guard of R.C.B.C. 50' East of
NW Corner NE 1/2, Sec. 22, Twp.
26-S, R-1-E.
Elev. = 1371.83 (NGVD29)

BM #2: "□" cut on East Hub
Guard of R.C.B.C. 110' S. of the
SE Cor., SE 1/4, Sec. 22, Twp.
26-S, R-1-E.
Elev. = 1359.54 (NGVD29)

SEWER SERVICE TABLE

NUMBER	TYPE	LOCATION			STATION\ DIRECTION	FOR INFORMATION ONLY	
		LOT NO.	BLOCK NO.	LINE NO.		APPROXIMATE LENGTH 4" PIPE	
13	10" x 4" Tee Saddle	40	A	2	1+65/Lt.	16.5'	5'
14	10" x 4" Tee Saddle	18	B	2	1+69/Rt.	16.5'	15'
15	10" x 4" Tee Saddle	39	A	2	1+85/Lt.	16.5'	5'
16	10" x 4" Tee Saddle	17	B	2	1+89/Rt.	16.5'	15'
17	10" x 4" Tee Saddle	16	B	2	2+55/Rt.	16.0'	15'
18	10" x 4" Tee Saddle	38	A	2	2+65/Lt.	16.0'	5'
19	4" x 4" Tee Saddle	15	B	2	3+40/Rt.	15.0'	15'
20	10" x 4" Tee Saddle	14	B	2	3+87/Rt.	14.5'	15'
21	10" x 4" Tee Saddle	37	A	2	4+05/Lt.	14.0'	5'

NOTE: Vertical Riser Pipe shall be extended to 2' minimum above ground water elevation and 4' maximum below proposed ground elevation.

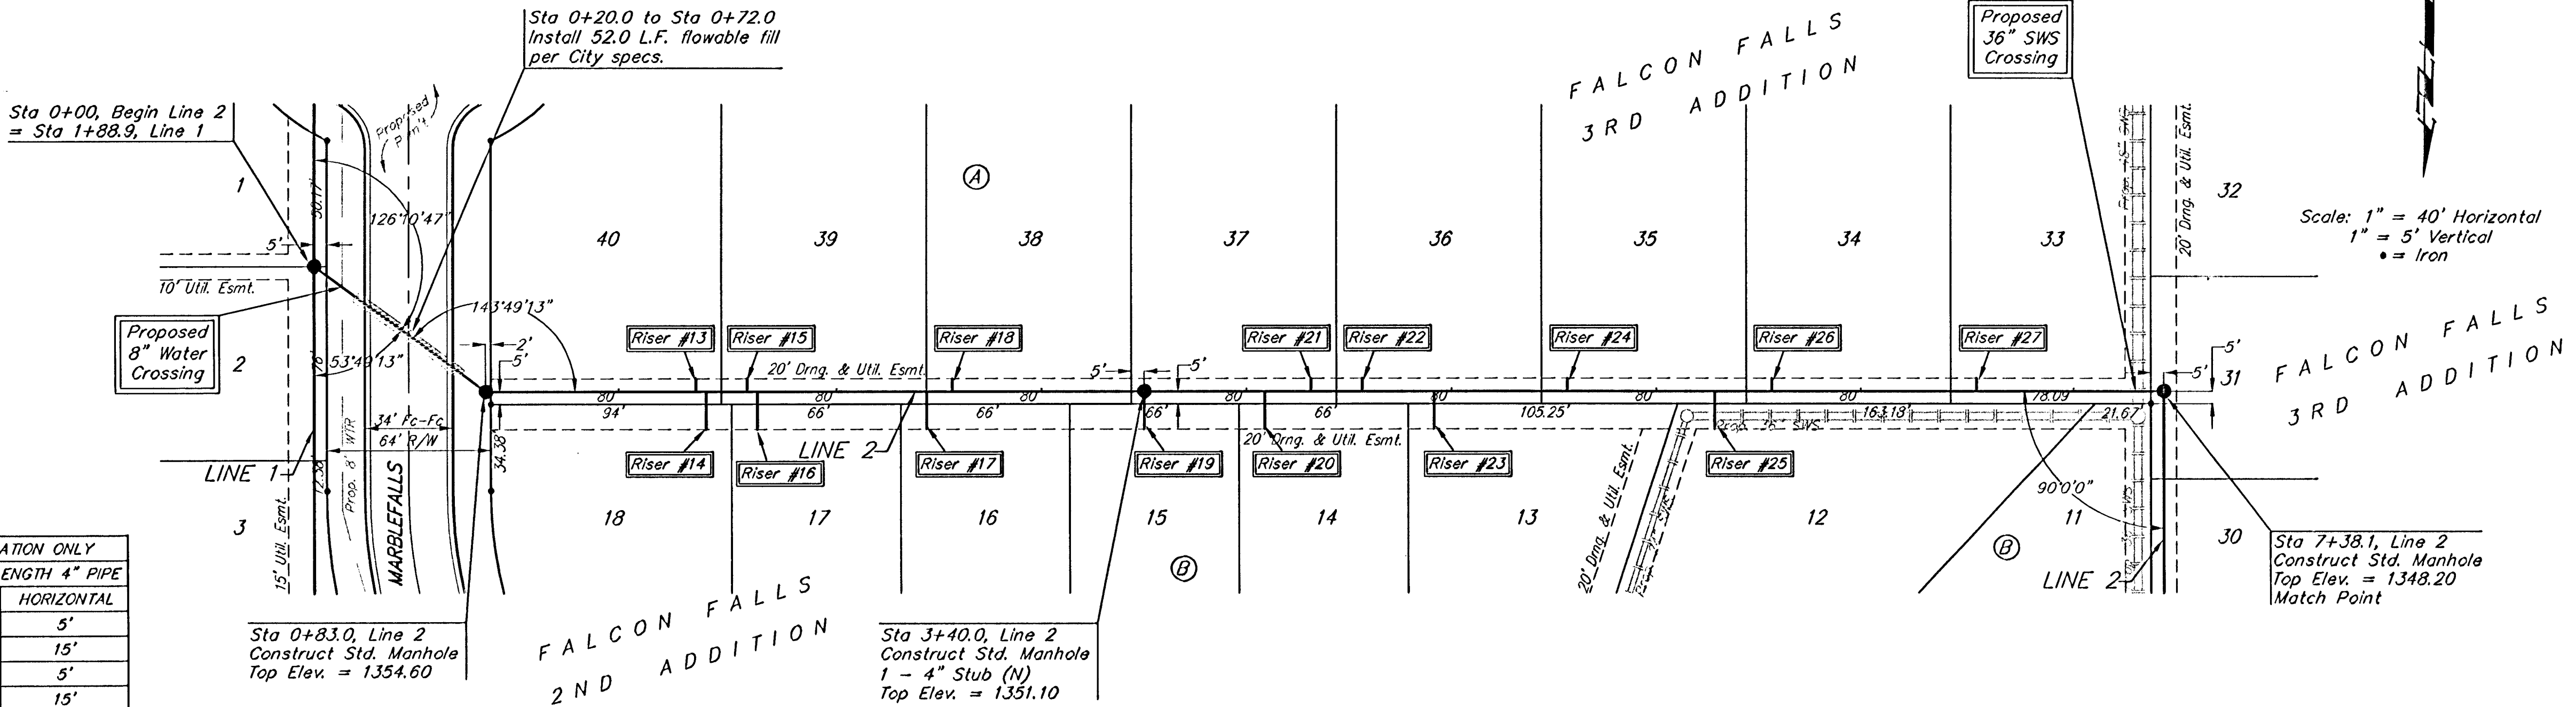

SEWER SERVICE TABLE


NUMBER	TYPE	LOCATION			STATION\ DIRECTION	FOR INFORMATION ONLY	
		LOT NO.	BLOCK NO.	LINE NO.		APPROXIMATE LENGTH 4" PIPE	
22	10" x 4" Tee Saddle	36	A	2	4+25/Lt.	13.5'	5'
23	10" x 4" Tee Saddle	13	B	2	4+53/Rt.	13.0'	15'
24	10" x 4" Tee Saddle	35	A	2	5+05/Lt.	16.0'	5'

NOTE: Vertical Riser Pipe shall be extended to 2' minimum above ground water elevation and 4' maximum below proposed ground elevation.

SEWER SERVICE TABLE

NUMBER	TYPE	LOCATION			STATION\ DIRECTION	FOR INFORMATION ONLY	
		LOT NO.	BLOCK NO.	LINE NO.		APPROXIMATE LENGTH 4" PIPE	
25	10" x 4" Tee Saddle	12	B	2	5+63/Rt.	12.5'	15'
26	10" x 4" Tee Saddle	34	A	2	5+85/Lt.	12.5'	5'
27	10" x 4" Tee Saddle	33	A	2	6+65/Lt.	12.5'	5'

NOTE: Vertical Riser Pipe shall be extended to 2' minimum above ground water elevation and 4' maximum below proposed ground elevation.

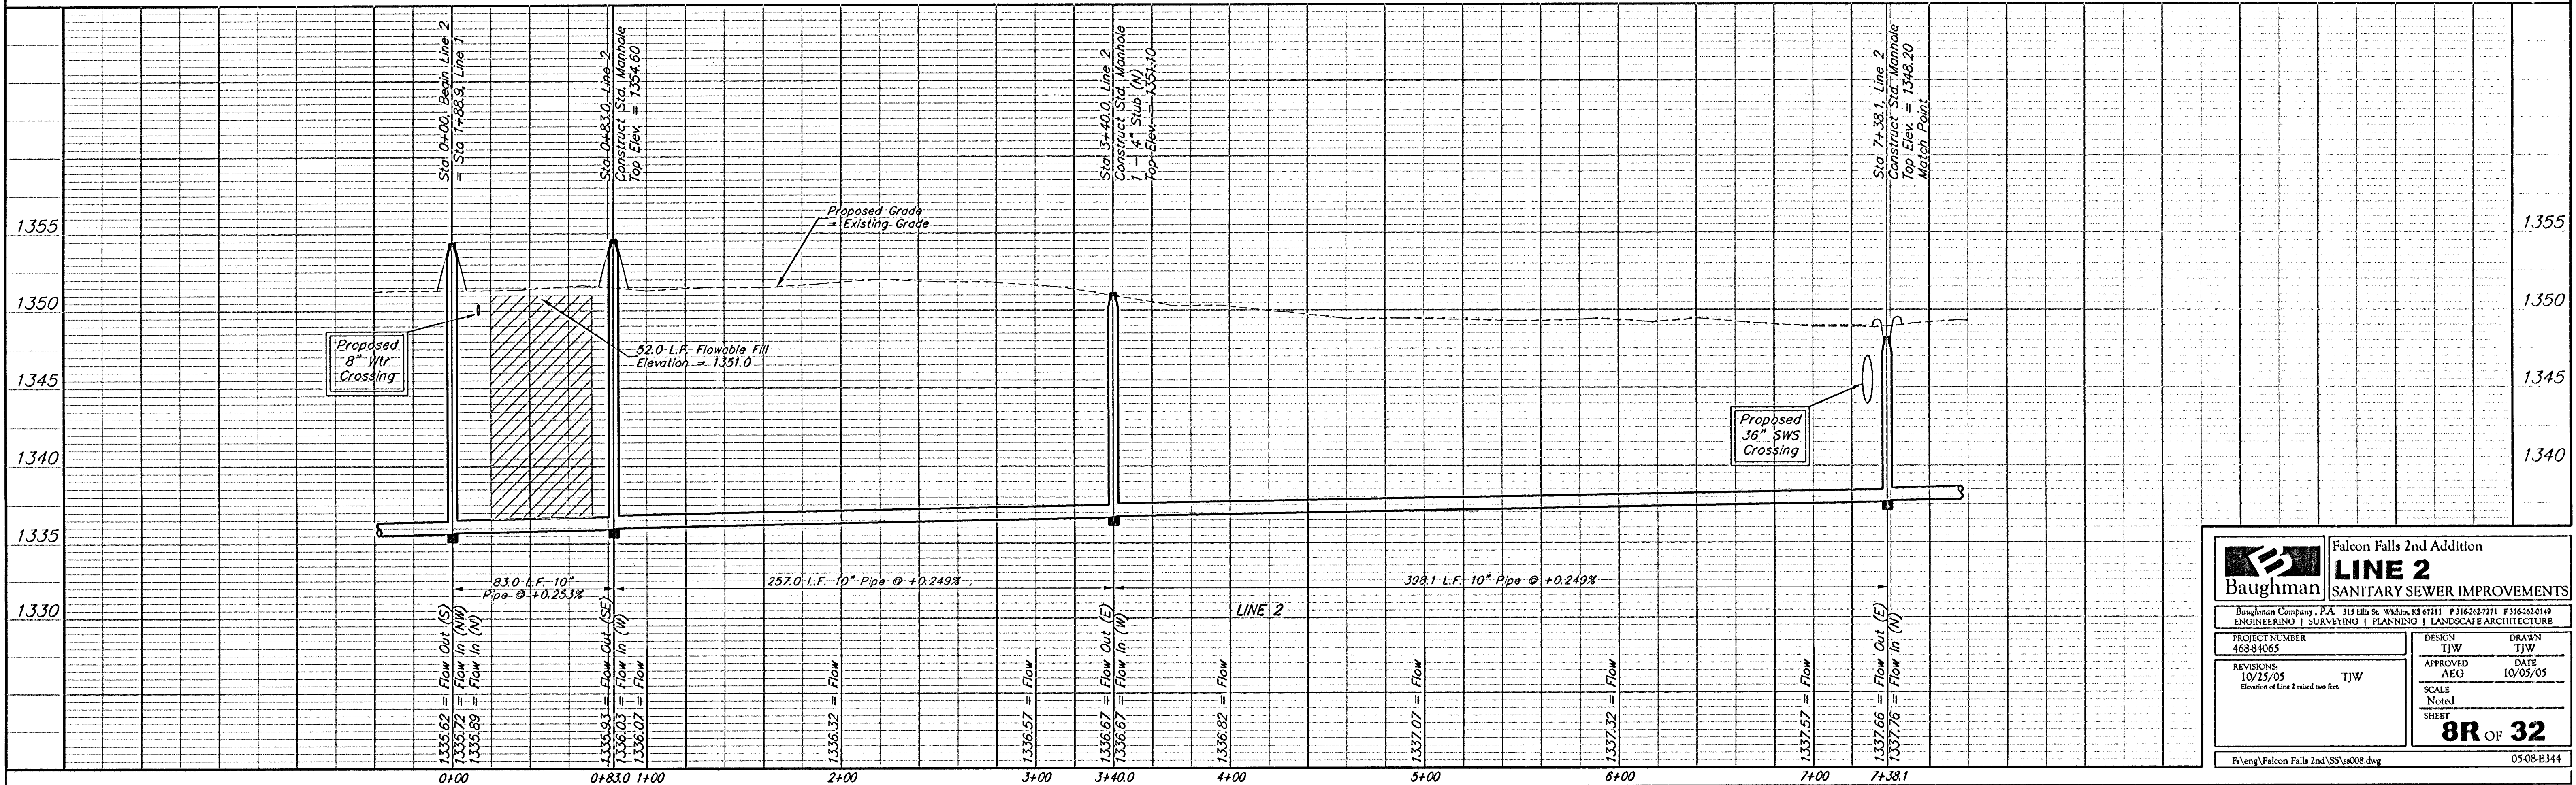

Falcon Falls 2nd Addition
LINE 2
SANITARY SEWER IMPROVEMENTS

PROJECT NUMBER
468-84065

DESIGN
TJW

APPROVED
AEO

DATE
10/05/05

SCALE
Noted

SHEET
8R OF 32

REVISIONS:
10/25/05
Elevation of Line 2 raised two feet.

TJW

F:\eng\Falcon Falls 2nd\SS\ss008.dwg

05-08-B344