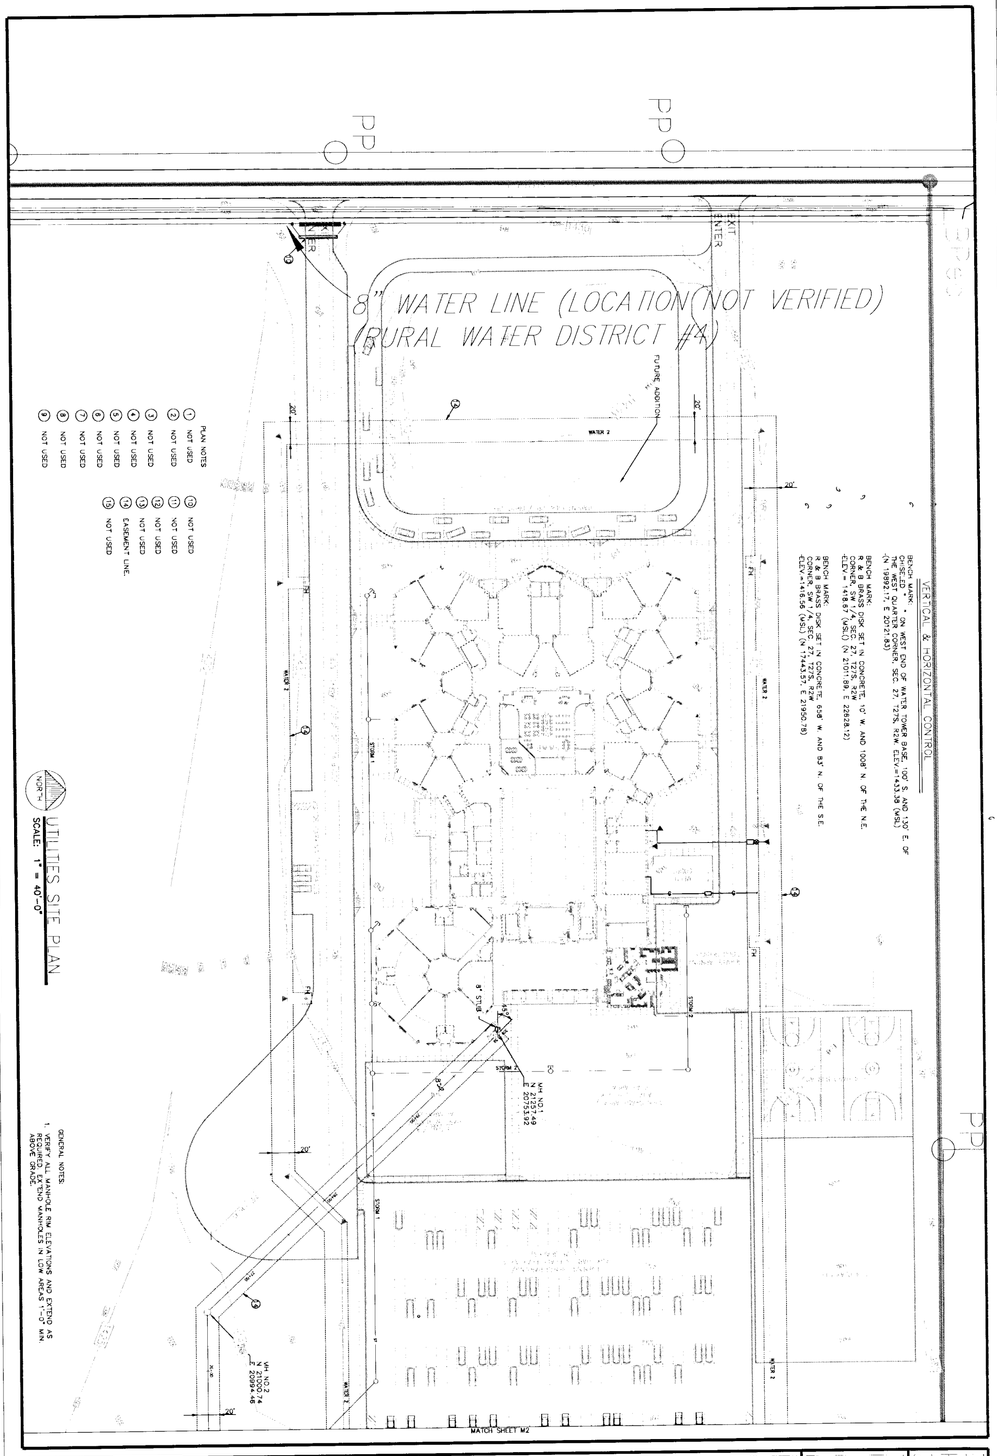


SHEET NO.	DESIGN JJL DRAWN DFP DATE JUNE 2005 FILE NO. X4-420-078	**GODDARD FACILITY IMPROVEMENTS** **#1 - New Elementary School** **GODDARD PUBLIC SCHOOLS U.S.D. No. 265** **201 S. MAIN, GODDARD, KANSAS**	**WILSON & COMPANY** *Engineers & Architects* 1700 East Iron · Salina, Kansas 67401 Tel 785 · 827-0433 Fax 785 · 827-0949	REVISION DATE BY