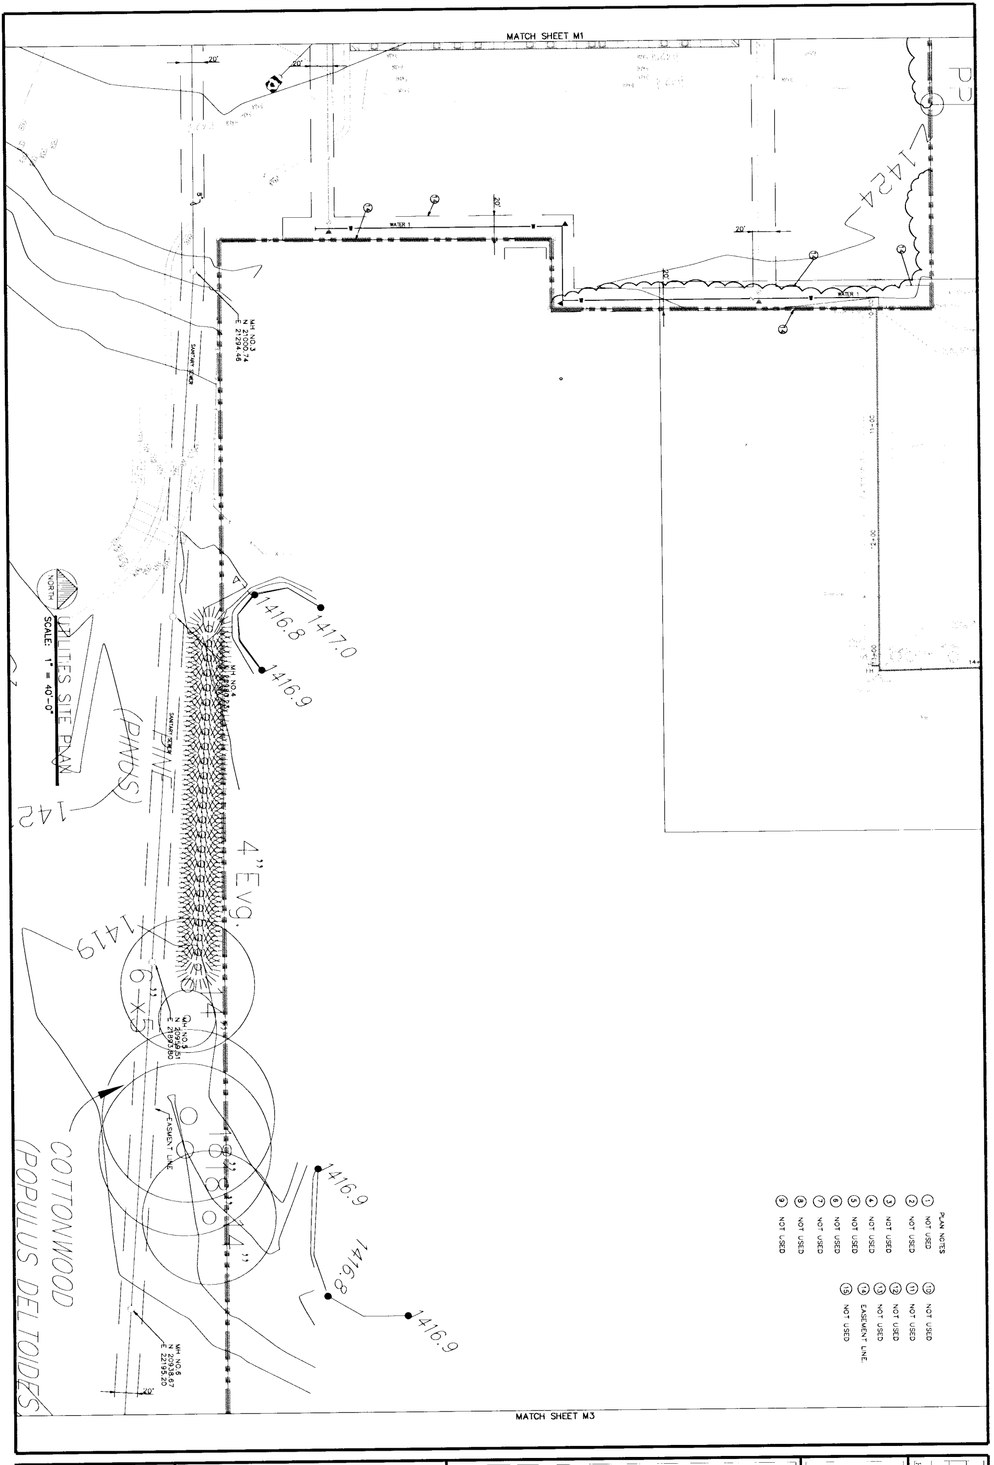



| | | | | | |
|---|---|---|---|---|---|
| SHEET NO. | DESIGN JLL<br>DRAWN DPP<br>DATE JUNE 2005<br>FILE NO. X4-420-078 | **GODDARD FACILITY IMPROVEMENTS**<br>**#1 - New Elementary School**<br>**GODDARD PUBLIC SCHOOLS U.S.D. No. 265**<br>**201 S. MAIN, GODDARD, KANSAS** | **WILSON & COMPANY**<br>*Engineers & Architects*<br>1700 East Iron - Salina, Kansas 67401 Tel 785 - 827-0433 Fax 785 - 827-5949 | | REVISION DATE BY |