
BENCHMARKS

BM #1: Brass Plate on North Hub Guard of R.C.B.C. 50' East of NW Corner NE 1/2, Sec. 22, Twp. 26-S, R-1-E.
Elev. = 1371.83 (NGVD29)

BM #2: "□" cut on East Hub Guard of R.C.B.C., 110' S. of the SE Cor., SE 1/4, Sec. 22, Twp. 26-S, R-1-E.
Elev. = 1359.54 (NGVD29)

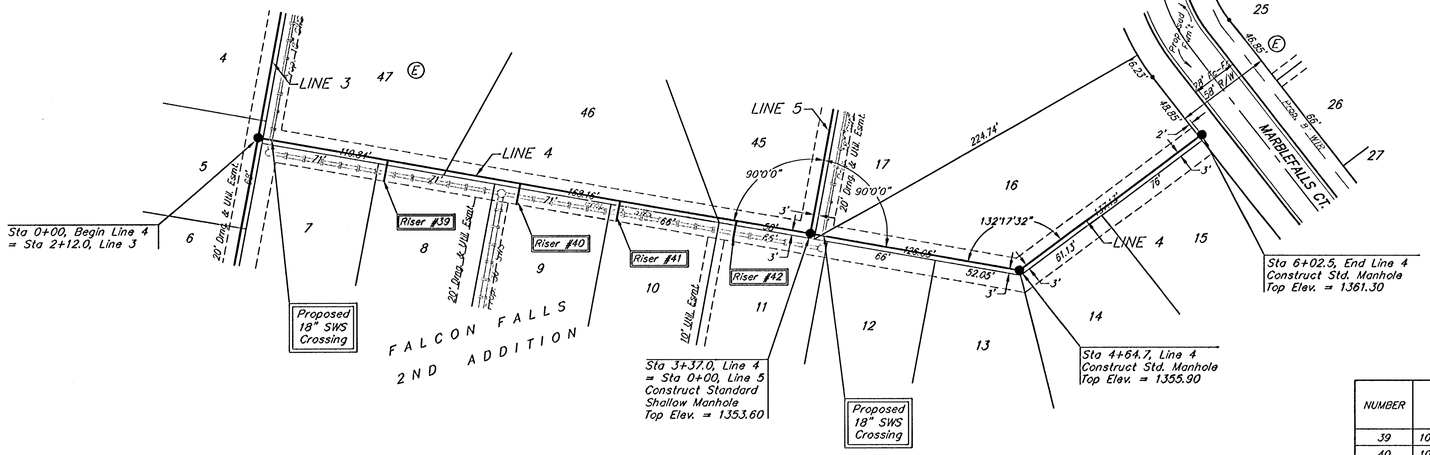


Scale: 1" = 40' Horizontal
1" = 5' Vertical
• = Iron

SEWER SERVICE TABLE

NUMBER	TYPE	LOCATION LOT NO.	LOCATION BLOCK NO.	LOCATION LINE NO.	STATION\ DIRECTION	FOR INFORMATION ONLY APPROXIMATE LENGTH 4" PIPE VERTICAL	FOR INFORMATION ONLY APPROXIMATE LENGTH 4" PIPE HORIZONTAL
39	10" x 4" Tee Saddle	8	E	4	0+79/Rt.	5.0'	13'
40	10" x 4" Tee Saddle	9	E	4	1+60/Rt.	5.0'	13'
41	10" x 4" Tee Saddle	10	E	4	2+21/Rt.	5.0'	13'
42	10" x 4" Tee Saddle	11	E	4	2+92/Rt.	5.0'	13'

NOTE: Vertical Riser Pipe shall be extended to 2' minimum above ground water elevation and 4' maximum below proposed ground elevation.

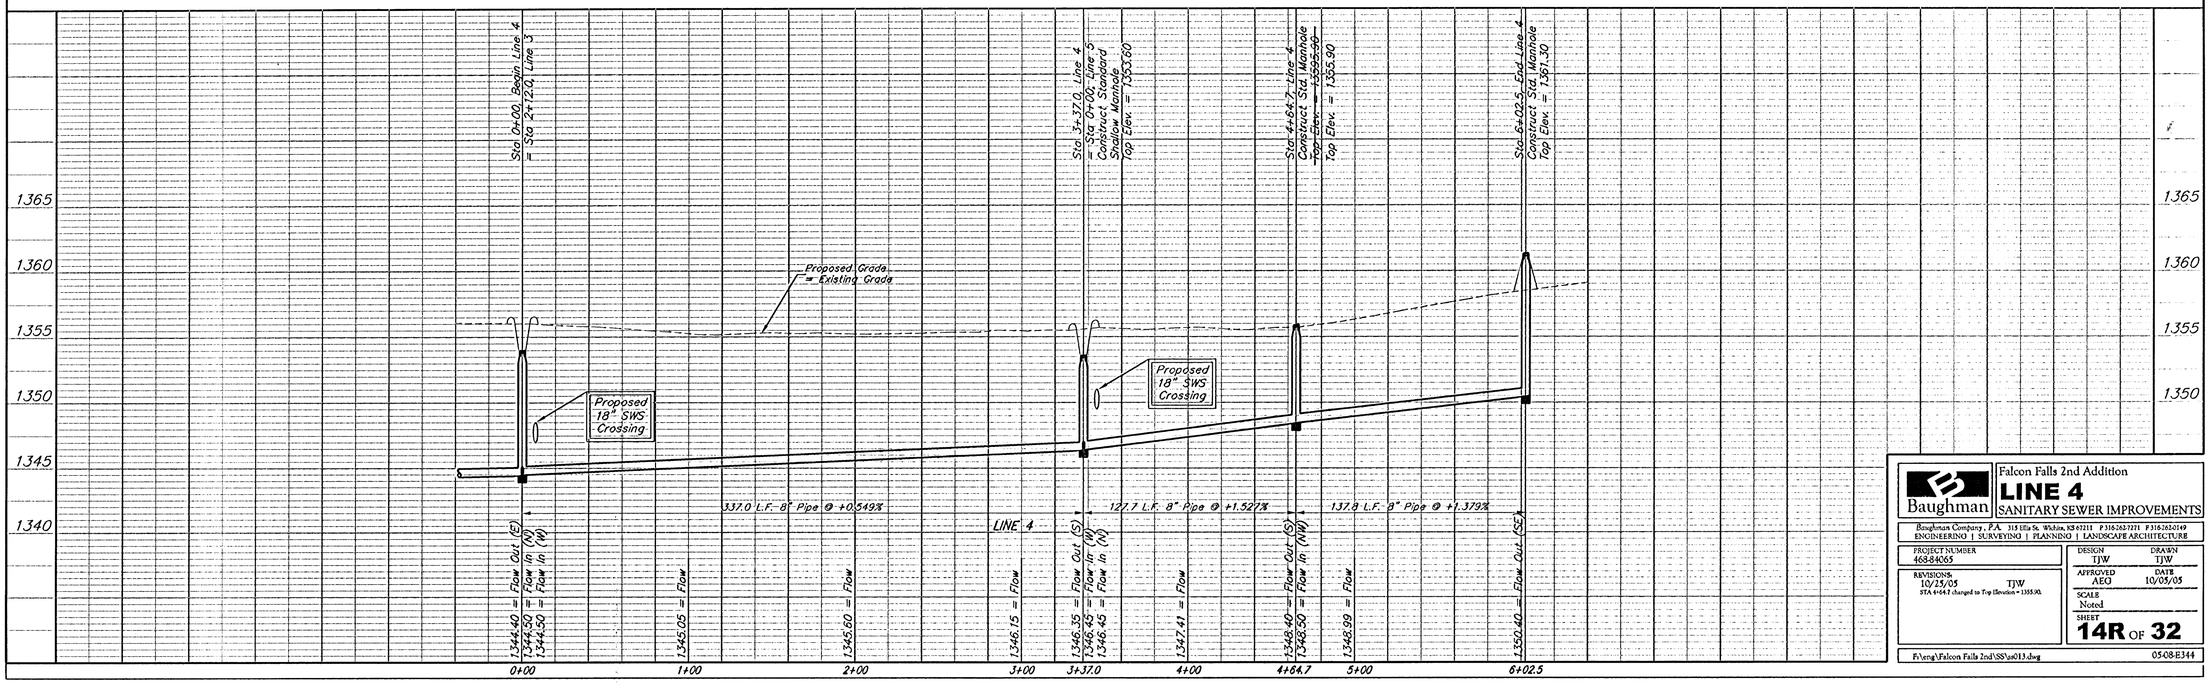

Baughman

Falcon Falls 2nd Addition
LINE 4
SANITARY SEWER IMPROVEMENTS

Baughman Company, P.A. 315 Ella St. Wichita, KS 67211 P 316.263.7271 F 316.263.0149
ENGINEERING | SURVEYING | PLANNING | LANDSCAPE ARCHITECTURE

PROJECT NUMBER 468-84065
DESIGN TJW
DRAWN TJW
APPROVED AEG
DATE 10/05/05
REVISIONS: 10/25/05 TJW
STA 4+64.7 changed to Top Elevation = 1355.90.
SCALE Noted
SHEET **14R** OF **32**

F:\eng\Falcon Falls 2nd\SS\ss013.dwg
05-08-E344