
Benchmarks:

BM #1: "X" on the West End of the Steel Casing Pipe at the Railroad Crossing South of 37th Street North Sta. 25+90, 41' Rt. Elev. = 149.18 (1336.58 MSL)

BM #2: Steel T-Post Driven 4' Deep Sta. 18+00, 25' Rt. Elev. = 150.33 (1337.73 MSL)

BM #3: "□" in the Concrete Footing of the SBC Pedestal in the South West Corner of 37th Street North and Tyler Road Sta. 8+56, 95' Rt. Elev. = 154.77 (1342.17 MSL)

BM #4: Railroad Spike in the East Face of the 2nd Power Pole North of 37th Street and West of Tyler Road Sta. 94+24, 48' Lt. Elev. = 155.45 (1342.85 MSL)

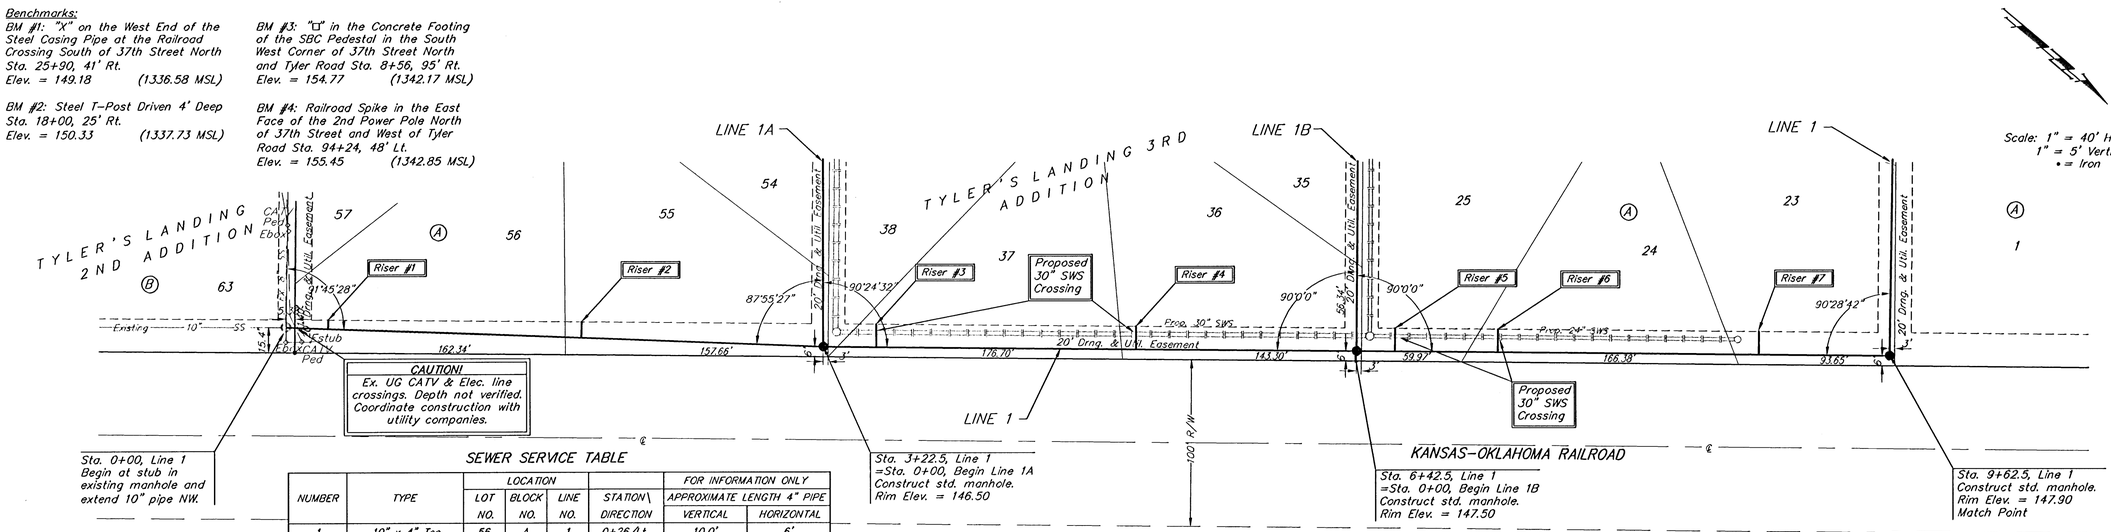


Scale: 1" = 40' Horizontal
1" = 5' Vertical
• = Iron

SEWER SERVICE TABLE

NUMBER	TYPE	LOCATION				FOR INFORMATION ONLY	
		LOT NO.	BLOCK NO.	LINE NO.	STATION\ DIRECTION	APPROXIMATE LENGTH 4" PIPE VERTICAL	HORIZONTAL
1	10" x 4" Tee	56	A	1	0+26/Lt.	10.0'	6'
2	10" x 4" Tee	55	A	1	1+78/Lt.	10.5'	10'
3	10" x 4" Tee	37	A	1	3+~~56~~55/Lt.	9.5'	14'
4	10" x 4" Tee	36	A	1	5+12/Lt.	10.5'	14'
5	10" x 4" Tee	25	A	1	6+~~88~~67/Lt.	9.5'	14'
6	10" x 4" Tee	24	A	1	7+30/Lt.	10.0'	14'
7	10" x 4" Tee	23	A	1	8+~~32~~94/Lt.	8.5'	14'

NOTE: Vertical Riser Pipe shall be extended to 2' minimum above ground water elevation and 4' maximum below proposed ground elevation.

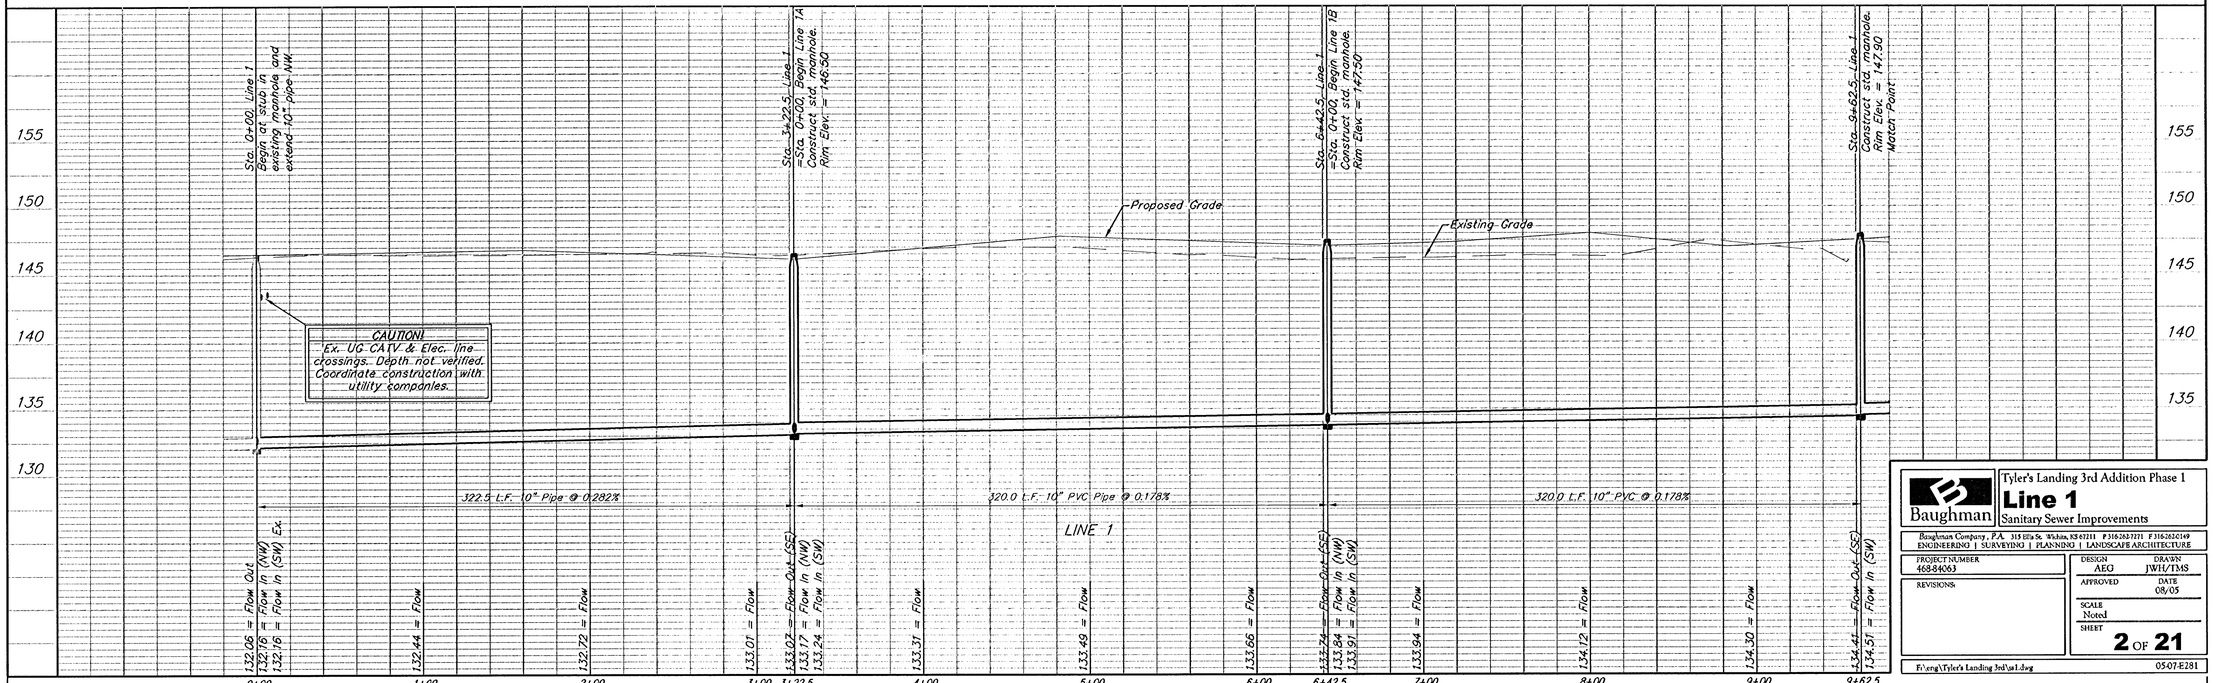

Baughman

Tyler's Landing 3rd Addition Phase 1

Line 1

Sanitary Sewer Improvements

Baughman Company, P.A. 315 Ellis St. Wichita, KS 67211 P 316.263.7271 F 316.263.0149
ENGINEERING | SURVEYING | PLANNING | LANDSCAPE ARCHITECTURE

PROJECT NUMBER 468.84063	DESIGN AEG / DRAWN JWH/TMS
REVISIONS	APPROVED / DATE 08/05
	SCALE Noted
	SHEET 2 OF 21

F:\eng\Tyler's Landing 3rd\ss1.dwg 05-07-E281