
BENCHMARKS:
BM #1: COW Disc in top of curb adjacent to the fire hydrant at the SW corner of Yosemite and Lamp Cir.
Elev. = 146.73 (City Datum)

BM #2: COW Disc in top of curb adjacent to the fire hydrant on the west side of Westgate along the southwesterly line of Lot 13, Block B, Southern Ridge Addition.
Elev. = 144.10 (City Datum)

SEWER SERVICE TABLE

Riser #	Line #	Station	Distance from Main to Riser (Lt/Rt)	Distance From Upstream MH	Distance From Downstream MH
1	1	0+58	Rt. 10'	216.00	58.00
2	1	0+68	Rt. 10'	236.00	68.00
3	1	1+34	Rt. 10'	170.00	134.00
4	1	2+00	Rt. 10'	104.00	200.00
5	1	2+74	Rt. 10'	33.00	274.00
6	1A	0+30	Rt. 10'	308.40	41.60

Scale: 1" = 40' Horizontal
1" = 5' Vertical
• = Iron

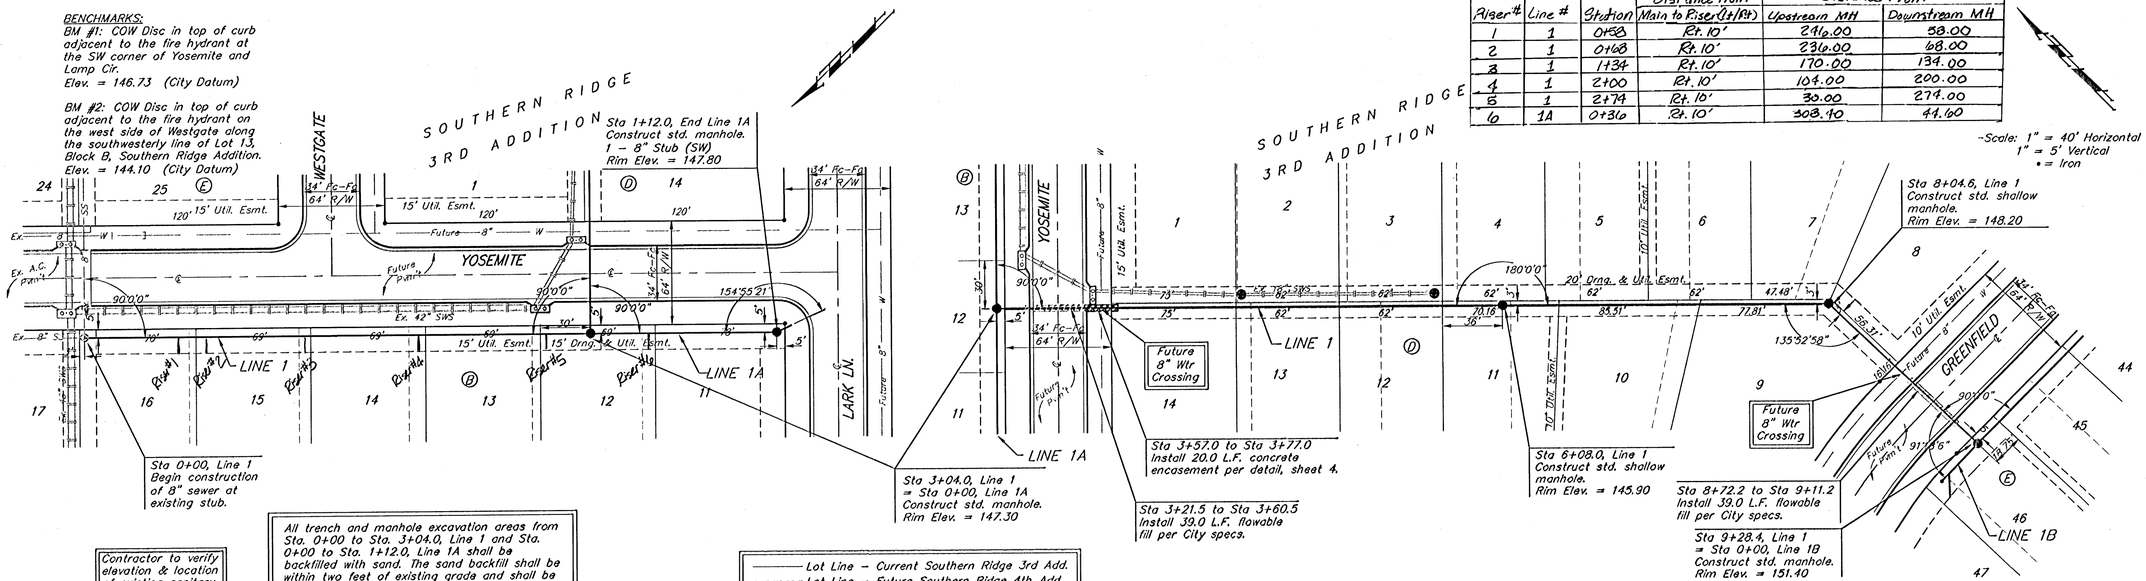


Contractor to verify elevation & location of existing sanitary sewer stub prior to contruction.

All trench and manhole excavation areas from Sta. 0+00 to Sta. 3+04.0, Line 1 and Sta. 0+00 to Sta. 1+12.0, Line 1A shall be backfilled with sand. The sand backfill shall be within two feet of existing grade and shall be water-jetted and vibrated during backfilling. All costs shall be subsidiary to pipe cost.

——— Lot Line – Current Southern Ridge 3rd Add.
- - - - Lot Line – Future Southern Ridge 4th Add.

Note: Risers follow future Southern Ridge 4th Add. lot lines.

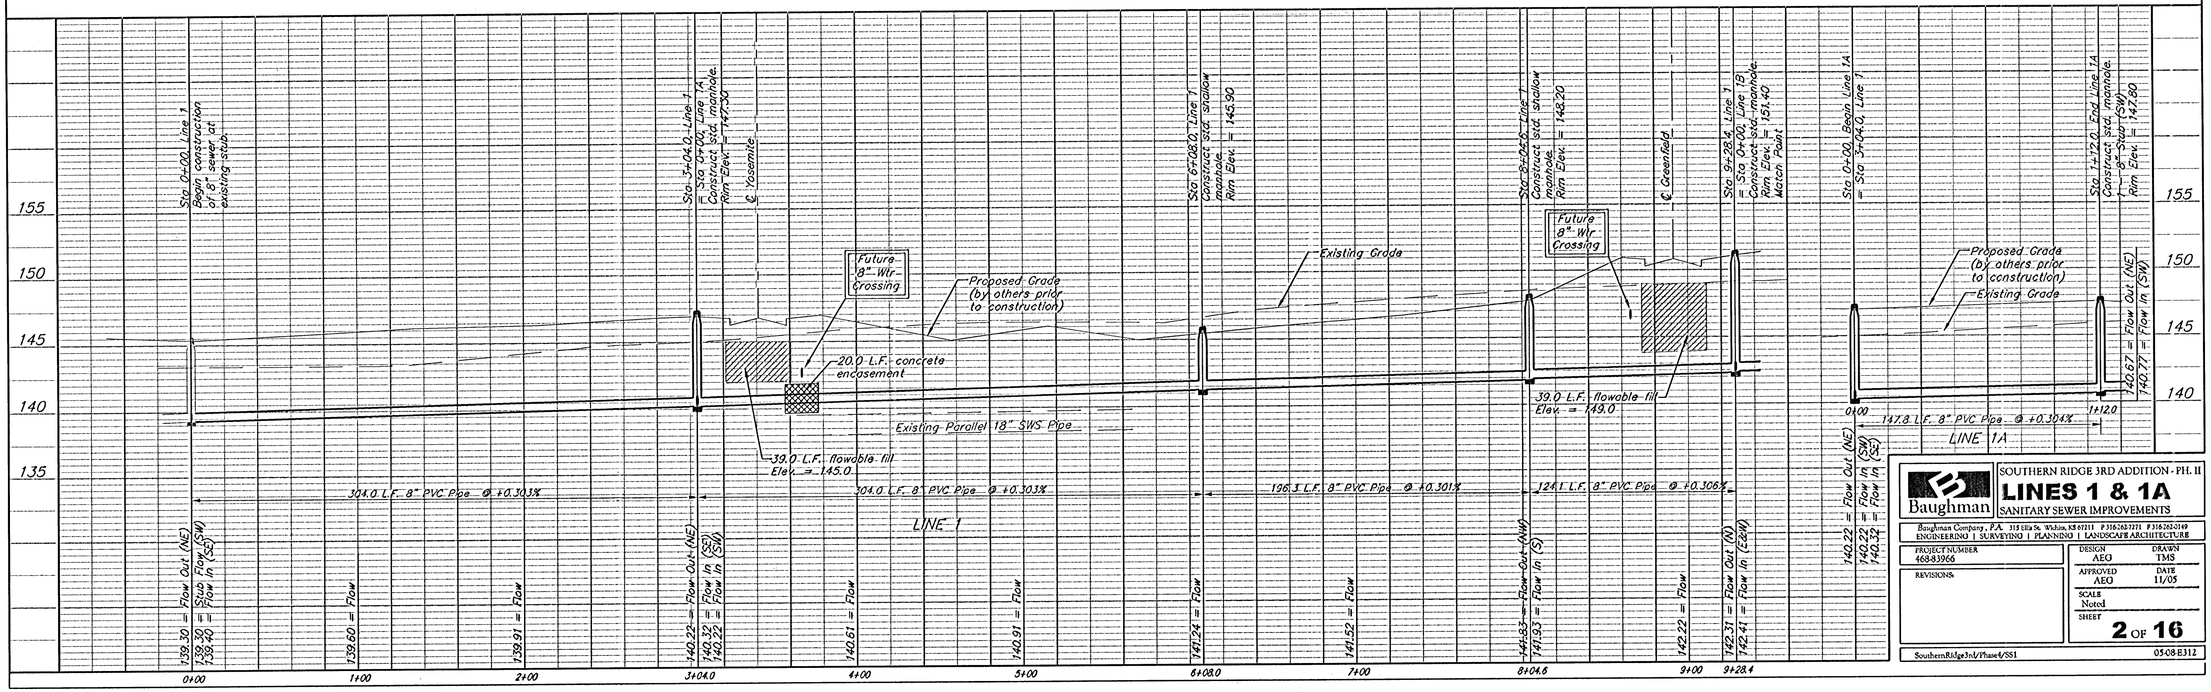

Baughman
SOUTHERN RIDGE 3RD ADDITION - PH. II
LINES 1 & 1A
SANITARY SEWER IMPROVEMENTS

Baughman Company, P.A. 315 Ellis St. Wichita, KS 67211 P 316.262.7271 F 316.262.0149
ENGINEERING | SURVEYING | PLANNING | LANDSCAPE ARCHITECTURE

PROJECT NUMBER 468-83966
REVISIONS

DESIGN AEG | DRAWN TMS
APPROVED AEG | DATE 11/05
SCALE Noted
SHEET 2 OF 16

SouthernRidge3rd/Phase4/SS1 05-08-EJ12