84050

LATERAL 377
OF THE
FOUR MILE CREEK SEWER
IN
THE CITY OF WICHITA


OCA NO. 744153

CITY OF WICHITA PROJECT NO. 468-84050

JAMES L. ARMOUR, P.E. - CITY ENGINEER

INDEX OF SHEETS

SHEET NO. 1	TITLE SHEET
SHEET NO. 2	KEY MAP AND GENERAL NOTES
SHEET NO. 3-4	PLATS
SHEET NO. 5	PROJECT COORDINATES
SHEET NO. 6	PLAN/PROFILE
SHEET NO. 7	TYPE "P" MANHOLE DETAILS
SHEET NO. 8	TYPE "P" SHALLOW MANHOLE DETAILS
SHEET NO. 9	FRAME & COVER DETAILS
SHEET NO. 10-13	SOIL EROSION BMP DETAILS

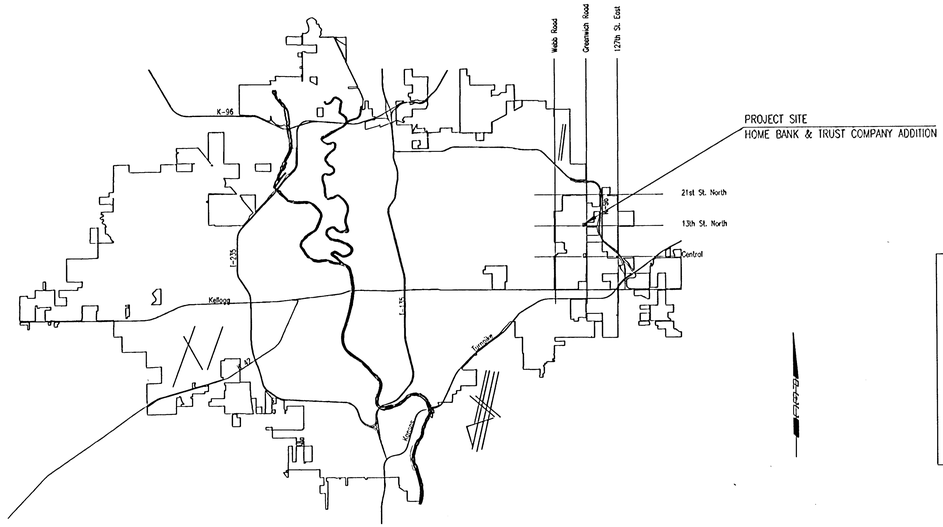

LOCATION MAP

WB Carter Construction Co, Inc. - Contractor
Strothman, City Inspector
Released 1/9/06
As-Built
Stubs
.pdf by JDL 5/8/06

CONSTRUCTION SCHEDULE/SEQUENCE

THE CONTRACTOR FOR EACH OF THE FOLLOWING GATEWAY CENTER/KIZER WEST PROJECTS SHALL COORDINATE THEIR EFFORTS WITH OTHER CONTRACTORS PERFORMING WORK IN THIS AREA SUCH THAT ANY NECESSARY SIMULTANEOUS CONSTRUCTION CAN PROCEED CONCURRENTLY WITHOUT CAUSING UNDUE DELAYS SO THAT CONSTRUCTION CAN BE COMPLETED WITHIN THE TIME FRAMES AS NOTED.

SANITARY SEWER (468-84050):

THE CONSTRUCTION OF SANITARY SEWER LINE NO. 1 SHALL BE COMPLETED BY DECEMBER 16, 2005.

OCTOBER 2005

PLANS PREPARED BY

PROFESSIONAL ENGINEERING CONSULTANTS, P.A.

ENGINEERS

WICHITA, KANSAS

MICHAEL K. KEEL
13944
11/1/05
KANSAS
PROFESSIONAL ENGINEER

DSNR: MDK OPER: REI SCALE: 1=1.00
C:\2005\05582\05582-000-G-TITLE 11-01-2005 10:51:32 am