
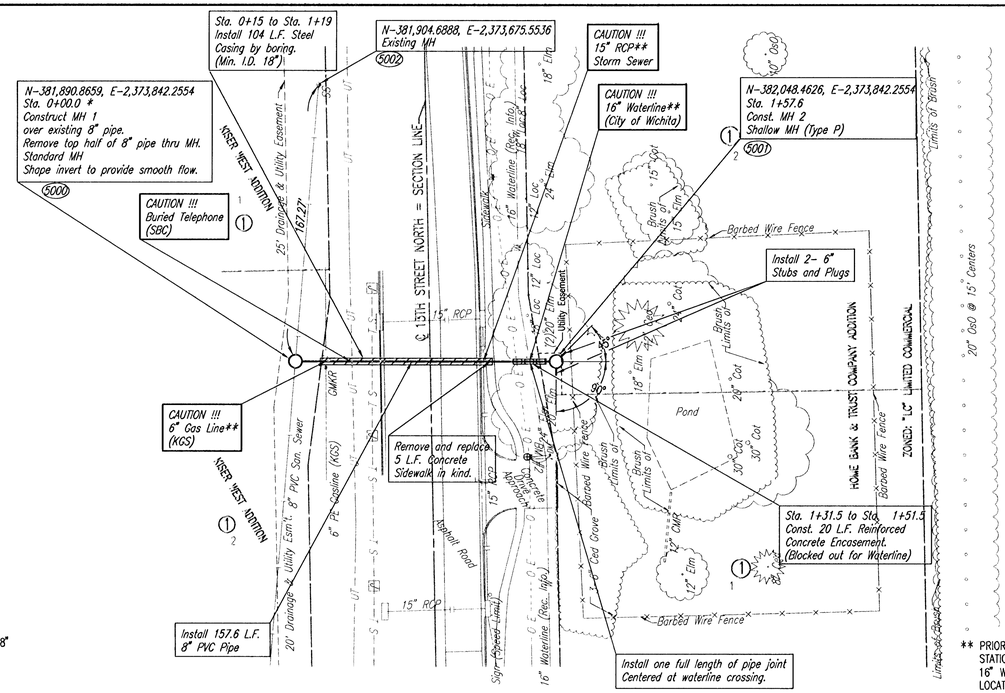


* PRIOR TO BEGINNING CONSTRUCTION, THE CONTRACTOR SHALL EXCAVATE THE EXISTING 8" PVC PIPE AT SANITARY SEWER STATION 0+00.0 TO VERIFY ITS HORIZONTAL AND VERTICAL LOCATION. THE PIPE LOCATION SHALL BE REPORTED TO THE ENGINEER SO THAT ANY NECESSARY PLAN MODIFICATIONS CAN BE MADE. ANY ADDITIONAL LABOR OR MATERIALS NECESSARY TO COMPLETE THE CONNECTION SHALL BE CONSIDERED SUBSIDIARY TO THE PROJECT.

** PRIOR TO BEGINNING CONSTRUCTION, THE CONTRACTOR SHALL EXCAVATE THE EXISTING 6" GAS LINE AT SANITARY SEWER STATION 0+18.4, THE EXISTING 15" RCP STORM SEWER AT SANITARY SEWER STATION 1+13.6, AND THE EXISTING 16" WATERLINE AT SANITARY SEWER STATION 1+41.5 TO VERIFY HORIZONTAL AND VERTICAL LOCATIONS. THE PIPE LOCATIONS SHALL BE REPORTED TO THE ENGINEER SO THAT ANY NECESSARY PLAN MODIFICATIONS CAN BE MADE. ANY ADDITIONAL LABOR OR MATERIALS NECESSARY TO COMPLETE THE WORK SHALL BE CONSIDERED SUBSIDIARY TO THE PROJECT.

MICHAEL D. KEISER
ENGINEER
13944
11/1/05
KANSAS
PROFESSIONAL ENGINEER

SANITARY SEWER LINE NO. 1

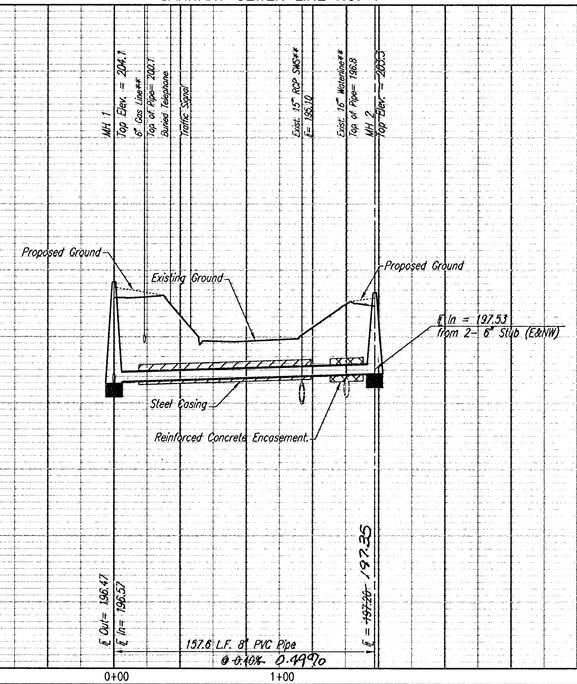

PLAN

	CHECKED	BY	DATE
	CHECKED		

PROFILE

	CHECKED	BY	DATE
	CHECKED		

DSNR: MDK OPER: REJ SCALE: 1=40.00
Q:\2005\05582\05582-000-C-SSPP01 11-01-2005 11:24:39 am

LATERAL 377
FOUR MILE CREEK SEWER

SANITARY SEWER LINE NO. 1

JAMES L. ARMOUR, P.E. - CITY ENGINEER
CITY OF WICHITA PROJECT NO. 468-84050

Professional Engineering Consultants, P.A.
303 S. TOPEKA • WICHITA, KANSAS 67202
316.262.2691 • FAX 316.262.3003

Designed By	MDK	Job No.	35-05582-042
Drawn By	TLS	Date	OCTOBER 2005