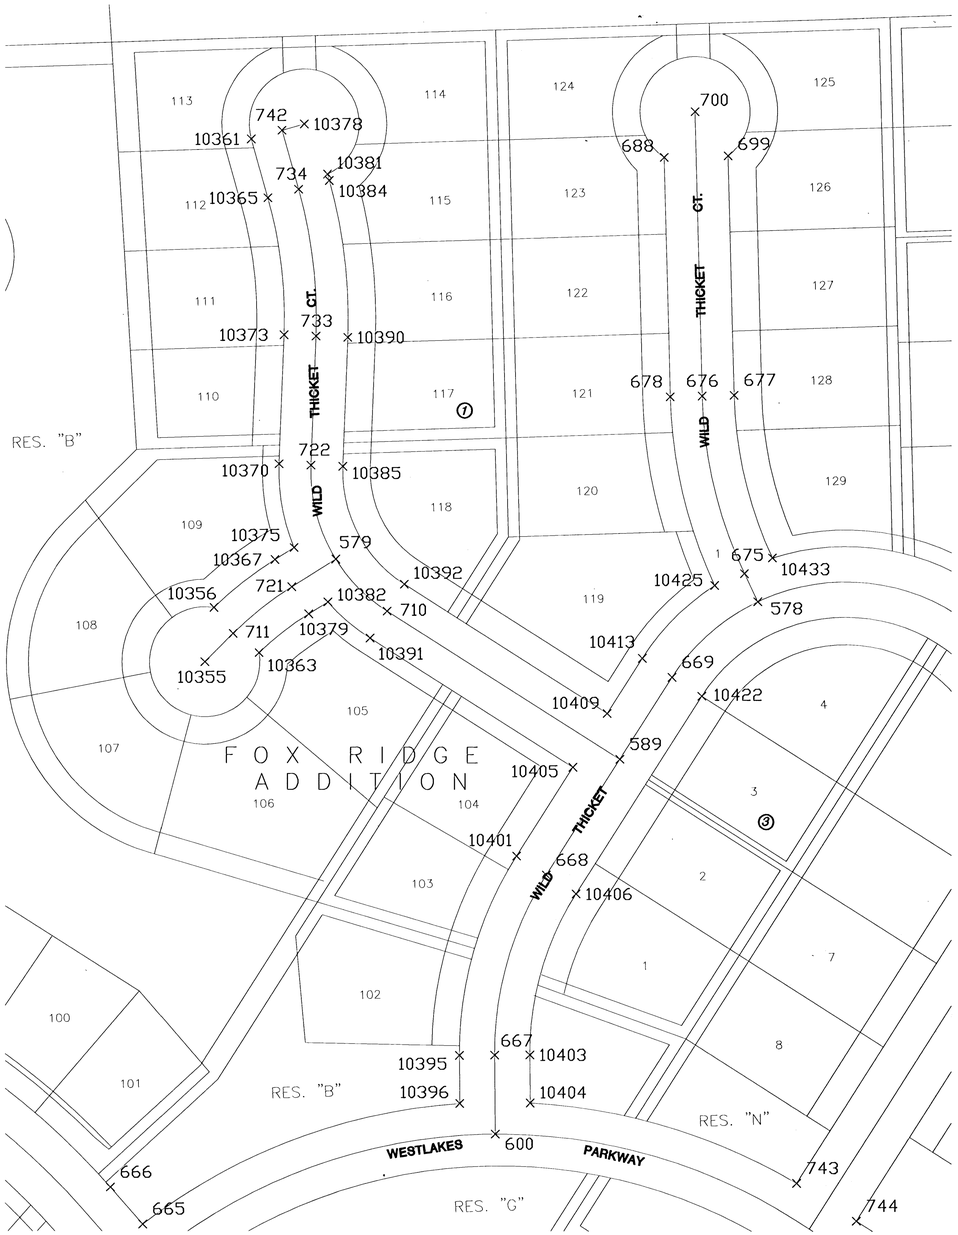


Point No.	North	East
665	1615281	1705586
666	1615252	1705620
667	1615601	1705740
668	1615647	1705903
669	1615762	1706083
675	1615827	1706177
676	1615789	1706338
677	1615818	1706338
678	1615760	1706337
688	1615754	1706554
699	1615812	1706555
700	1615782	1706595
710	1615503	1706142
711	1615363	1706122
721	1615416	1706165
722	1615434	1706275
733	1615438	1706392
734	1615422	1706525
742	1615407	1706578
743	1615875	1705623
744	1615929	1705589
10355	1615337	1706096
10356	1615346	1706146
10361	1615379	1706570
10363	1615387	1706105
10365	1615395	1706517
10367	1615401	1706189
10373	1615409	1706393
10375	1615418	1706200
10378	1615428	1706584
10379	1615432	1706140
10381	1615449	1706539
10382	1615449	1706151
10384	1615450	1706533
10390	1615467	1706391
10391	1615487	1706118
10392	1615519	1706167
10395	1615569	1705739
10396	1615569	1705696
10401	1615620	1705920
10403	1615633	1705740
10404	1615633	1705696
10405	1615672	1706001
10406	1615674	1705886
10409	1615703	1706050
10413	1615735	1706100
10422	1615789	1706065
10425	1615800	1706166
10433	1615853	1706191

N

SCALE: 1" = 60'

C:\CIVIL\99118\DWG\RAYA PH 13 PART2\99118BM.DWG

MKEC ENGINEERING CONSULTANTS
411 N. WEBB ROAD
WICHITA, KS. 67206
316 - 684 - 9600

FOX RIDGE ADDITION - PHASE 13 - PART 2
PROJECT NAME

BUBBLE MAP
SHEET TITLE

DFL	MKrk	GJA
DESIGN BY:	DRAWN BY:	CHECKED BY:
OCTOBER 2005	99118	28 / 29
DATE	JOB NO.	SHEET/OF