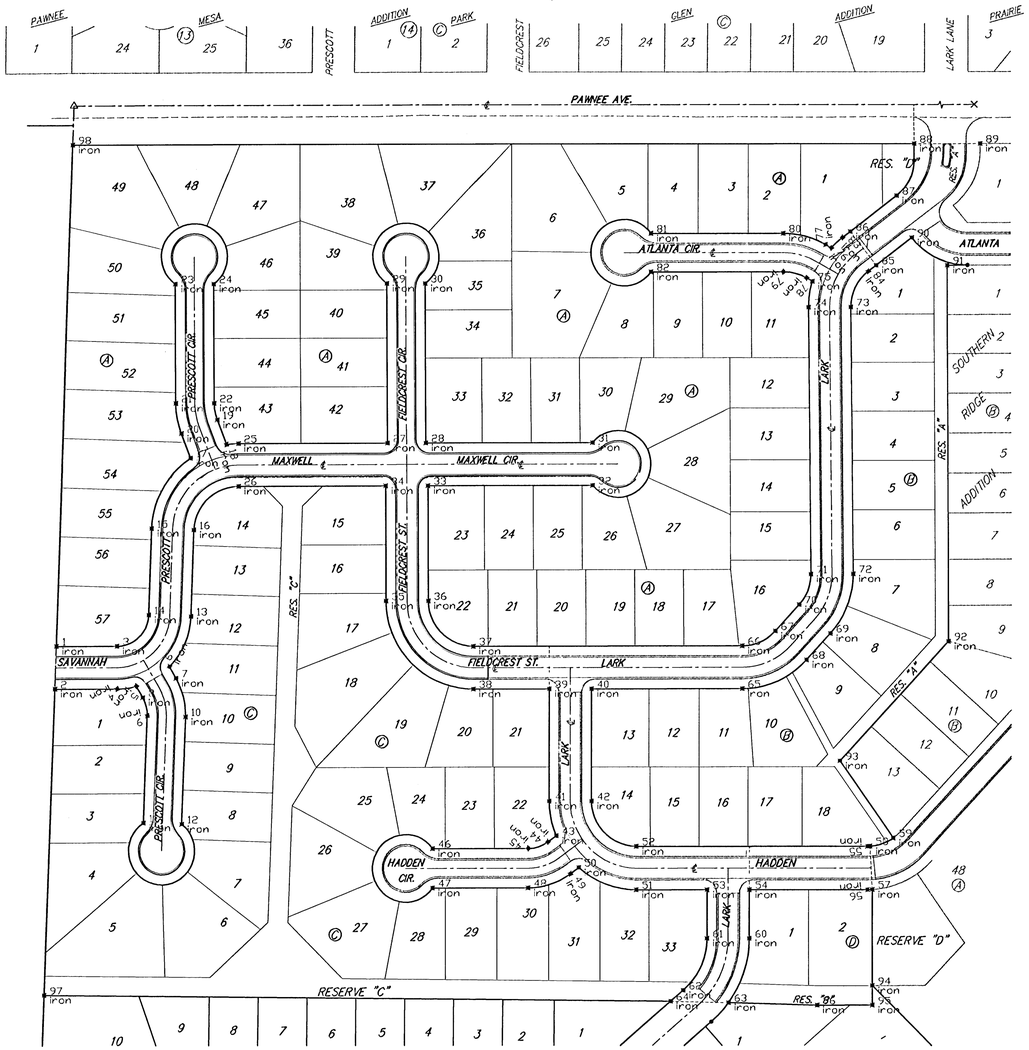


Scale: 1" = 100'

IRONS

POINT	NORTHING	EASTING	DESC
1	9449.29	17338.36	Iron
2	9385.29	17336.35	Iron
3	9449.35	17430.30	Iron
4	9385.35	17430.34	Iron
5	9389.16	17459.26	Iron
6	9418.17	17509.49	Iron
7	9400.92	17519.45	Iron
8	9371.91	17469.22	Iron
9	9344.65	17476.02	Iron
10	9342.64	17533.99	Iron
11	9181.66	17470.39	Iron
12	9179.66	17528.35	Iron
13	9493.48	17542.21	Iron
14	9495.69	17478.25	Iron
15	9627.02	17482.79	Iron
16	9624.81	17546.75	Iron
17	9732.78	17542.23	Iron
18	9753.20	17596.52	Iron
19	9789.97	17582.69	Iron
20	9769.35	17528.40	Iron
21	9814.89	17520.14	Iron
22	9814.92	17578.14	Iron
23	9996.67	17520.03	Iron
24	9996.71	17578.03	Iron
25	9754.46	17614.63	Iron
26	9690.46	17614.67	Iron
27	9754.59	17840.18	Iron
28	9754.63	17898.18	Iron
29	9996.86	17840.03	Iron
30	9996.90	17898.03	Iron
31	9754.78	18150.19	Iron
32	9690.78	18150.22	Iron
33	9690.63	17901.22	Iron
34	9690.59	17837.22	Iron
35	9515.59	17837.32	Iron
36	9515.63	17901.32	Iron
37	9447.67	17969.36	Iron
38	9383.67	17969.40	Iron
39	9383.74	18084.10	Iron
40	9383.78	18148.10	Iron
41	9213.74	18084.20	Iron
42	9213.78	18148.20	Iron
43	9161.59	18094.97	Iron
44	9152.46	18082.42	Iron
45	9142.72	18052.47	Iron
46	9142.63	17907.99	Iron
47	9084.63	17908.02	Iron
48	9084.72	18052.50	Iron
49	9105.54	18116.51	Iron
50	9114.66	18129.07	Iron
51	9081.82	18216.28	Iron
52	9145.82	18216.24	Iron
53	9081.88	18323.44	Iron
54	9081.92	18387.44	Iron
55	9146.03	18566.36	Iron
56	9082.03	18566.40	Iron
57	9082.22	18573.44	Iron
58	9146.13	18569.99	Iron
59	9158.12	18605.02	Iron
60	9008.73	18387.48	Iron
61	9008.69	18323.48	Iron
62	8928.83	18287.45	Iron
63	8909.86	18355.93	Iron
64	8912.02	18268.38	Iron
65	9383.92	18376.26	Iron
66	9447.92	18376.22	Iron
67	9470.05	18426.38	Iron
68	9426.88	18473.63	Iron
69	9466.38	18509.72	Iron
70	9509.55	18462.47	Iron
71	9555.78	18480.27	Iron
72	9556.12	18544.27	Iron
73	9960.71	18542.12	Iron
74	9960.37	18478.12	Iron
75	9999.69	18483.89	Iron
76	10050.07	18512.63	Iron
77	10055.00	18503.99	Iron
78	10004.62	18475.25	Iron
79	10013.95	18440.02	Iron
80	10071.95	18439.99	Iron
81	10071.83	18239.72	Iron
82	10013.83	18239.75	Iron
83	10065.73	18529.68	Iron
84	10014.99	18568.68	Iron
85	10024.04	18580.46	Iron
86	10074.79	18541.46	Iron
87	10128.51	18611.37	Iron
88	10208.07	18637.80	Iron
89	10208.13	18737.80	Iron
90	10065.51	18634.43	Iron
91	10024.10	18688.09	Iron
92	9454.43	18688.43	Iron
93	9274.77	18524.29	Iron
94	8936.11	18573.53	Iron
95	8906.11	18573.54	Iron
96	8906.06	18490.11	Iron
97	8921.77	17320.31	Iron
98	10207.31	17364.77	Iron

Baughman

SOUTHERN RIDGE 2ND ADD. - PH. II

COORDINATE INFORMATION

Baughman Company, P.A. 315 Ella St. Wichita, KS 67211 P 316.263.7721 F 316.263.0149
ENGINEERING | SURVEYING | PLANNING | LANDSCAPE ARCHITECTURE

PROJECT NUMBER	DESIGN	DRAWN
472-84098	AEG	TMS
REVISIONS:	APPROVED	DATE 10/05
	SCALE Noted	
	SHEET **19** OF **29**	

SouthernRidge2nd/PhaseII/StrCoords 05-09-B350