
BRENTWOOD SOUTH

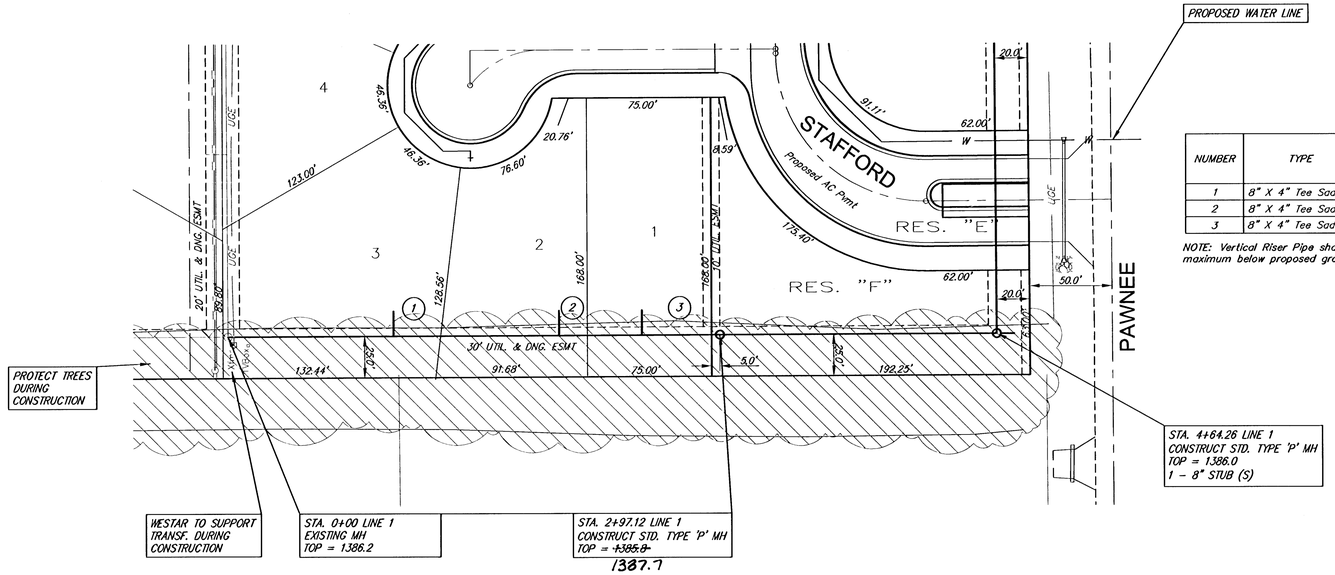


SCALE 1" = 40'
IRON = ●

SEWER SERVICE TABLE

NUMBER	TYPE	LOCATION			STATION/ DIRECTION	FOR INFORMATION ONLY	
		LOT NO.	BLOCK NO.	LINE NO.		APPROXIMATE LENGTH 4" PIPE VERTICAL	HORIZONTAL
1	8" X 4" Tee Saddle	3	7	1	~~1+00~~/E 0+95	12.1'	~~15~~ 13.5'
2	8" X 4" Tee Saddle	2	7	1	2+00/E	12.3'	15'
3	8" X 4" Tee Saddle	1	7	1	2+50/E	12.5'	~~18~~ 16'

NOTE: Vertical Riser Pipe shall be extended to 2' minimum above ground water elevation and 4' maximum below proposed ground elevation.

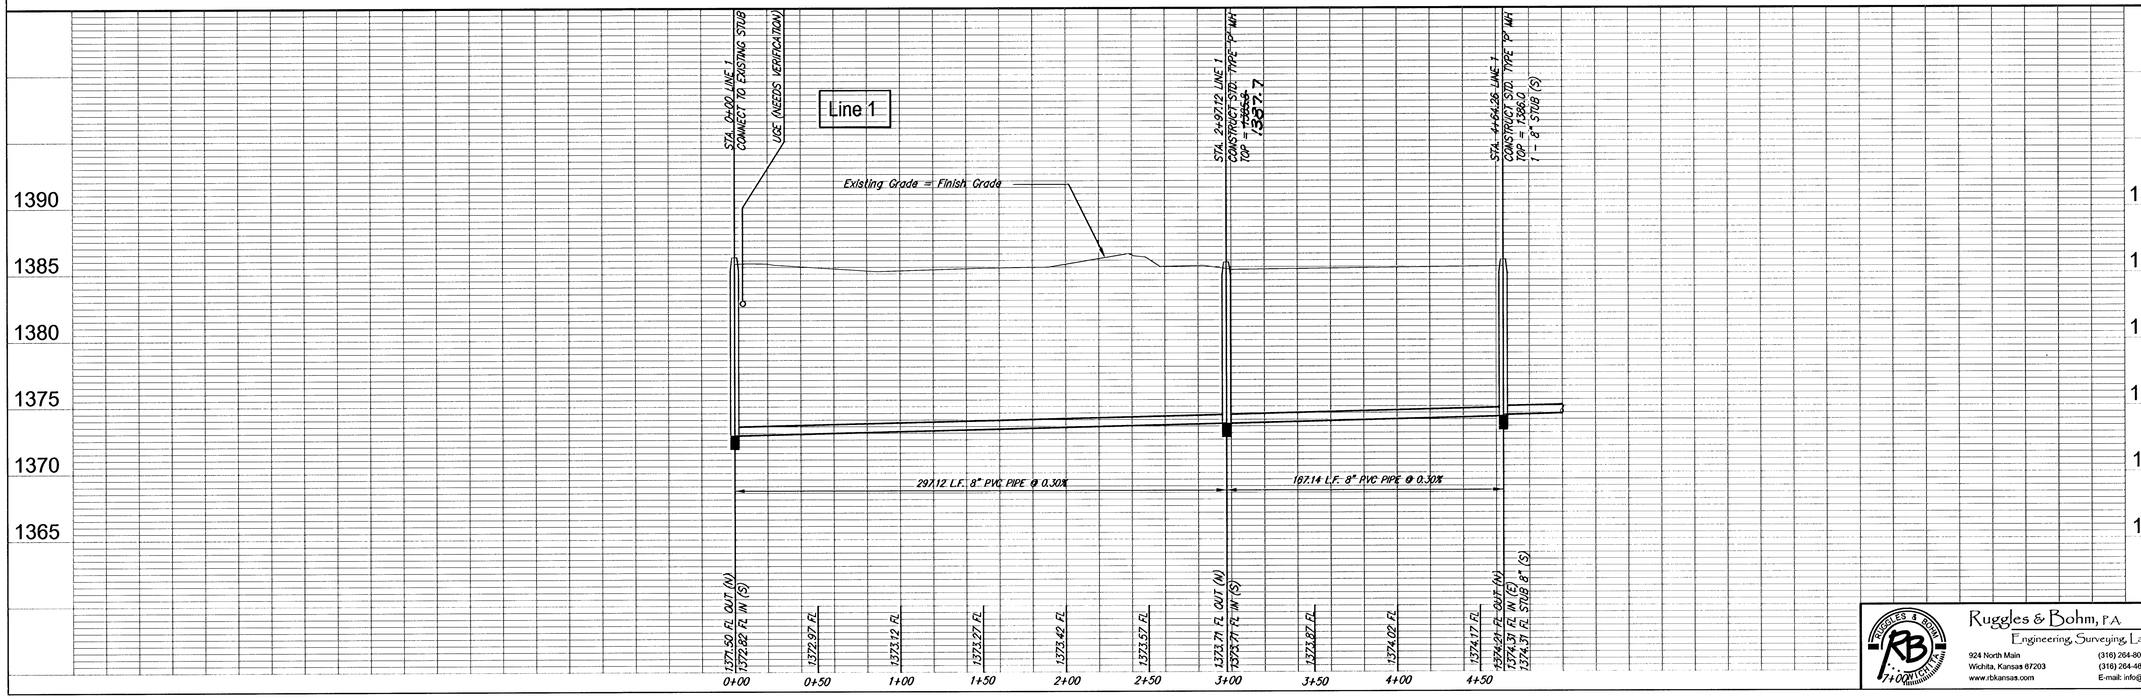

DESIGN KWL | DRAWN RLS | REVISED
UTILITY | DATE | REVIEW

PROJECT NUMBER .
DRAWING FILE Sanitary Sewer [Line 1]

Brentwood South Addition
Line 1
WICHITA, KANSAS

Ruggles & Bohm, P.A.
Engineering, Surveying, Land Planning
924 North Main
Wichita, Kansas 67203
www.rbkansas.com
(316) 264-8009
(316) 264-4821 fax
E-mail: info@rbkansas.com

RB JOB 2738E
SHEET 2 OF 14