BRENTWOOD SOUTH

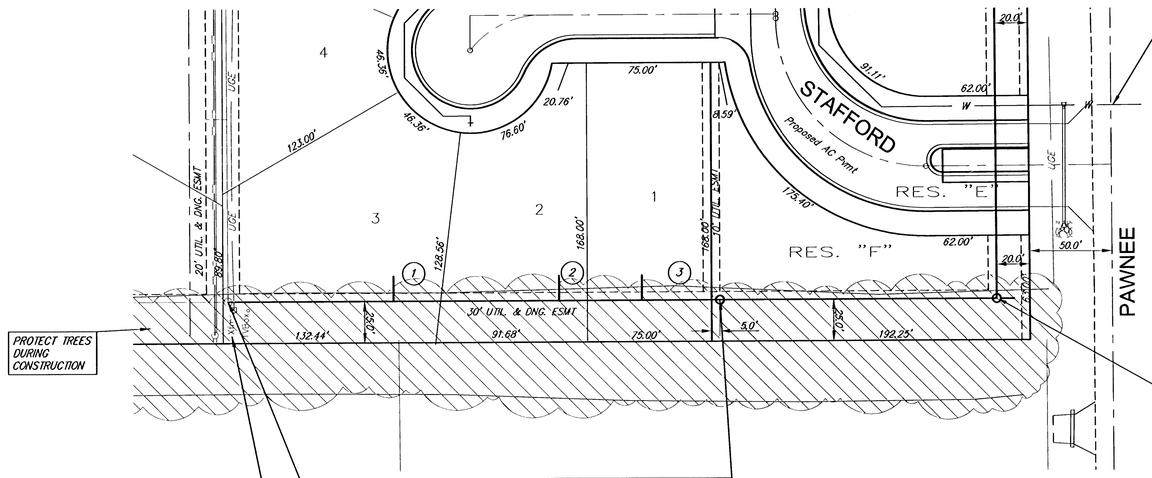

SCALE 1" = 40'
IRON = ●

SEWER SERVICE TABLE

NUMBER	TYPE	LOCATION			STATION/ DIRECTION	FOR INFORMATION ONLY	
		LOT NO.	BLOCK NO.	LINE NO.		APPROXIMATE LENGTH 4" PIPE VERTICAL	HORIZONTAL
1	8" X 4" Tee Saddle	3	7	1	~~1+00~~/E 0+95	12.1'	~~15'~~ 14.5'
2	8" X 4" Tee Saddle	2	7	1	2+00/E	12.3'	15'
3	8" X 4" Tee Saddle	1	7	1	2+50/E	12.5'	~~18'~~ 16'

NOTE: Vertical Riser Pipe shall be extended to 2' minimum above ground water elevation and 4' maximum below proposed ground elevation.

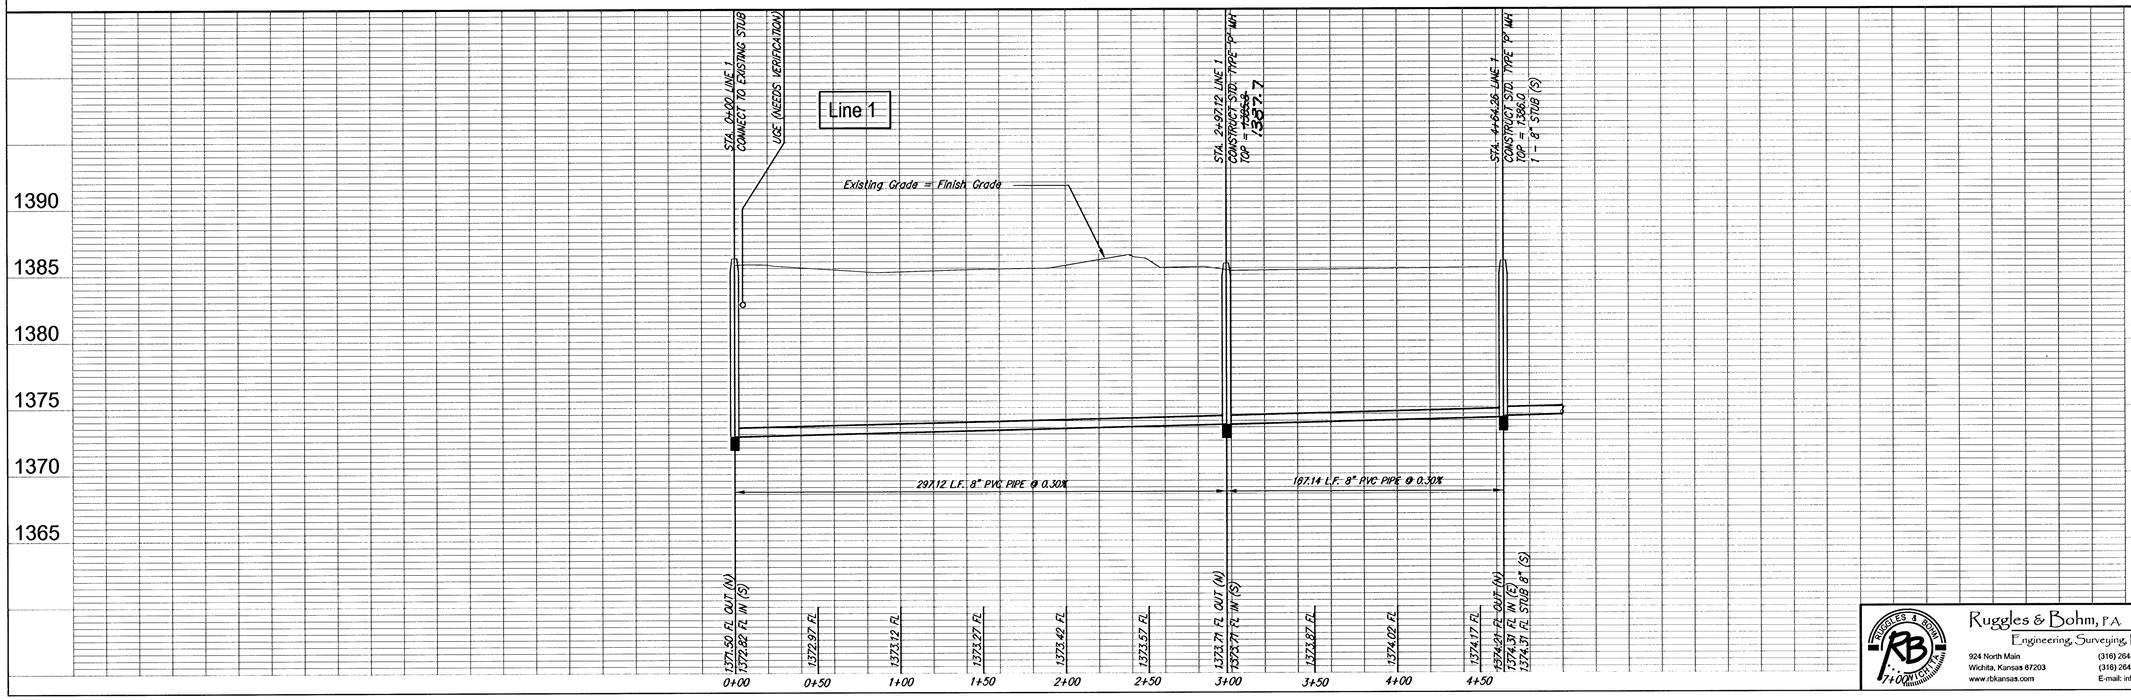

DESIGN KWL
DRAWN RLS
REVISED
UTILITY
DATE
REVIEW

PROJECT NUMBER
DRAWING FILE Sanitary Sewer (Line 1)

Brentwood South Addition
Line 1
WICHITA, KANSAS

Ruggles & Bohm, P.A.
Engineering, Surveying, Land Planning
924 North Main
Wichita, Kansas 67203
www.rbkansas.com
(316) 264-8009
(316) 264-4821 fax
E-mail: info@rbkansas.com

RB JOB 2738E