
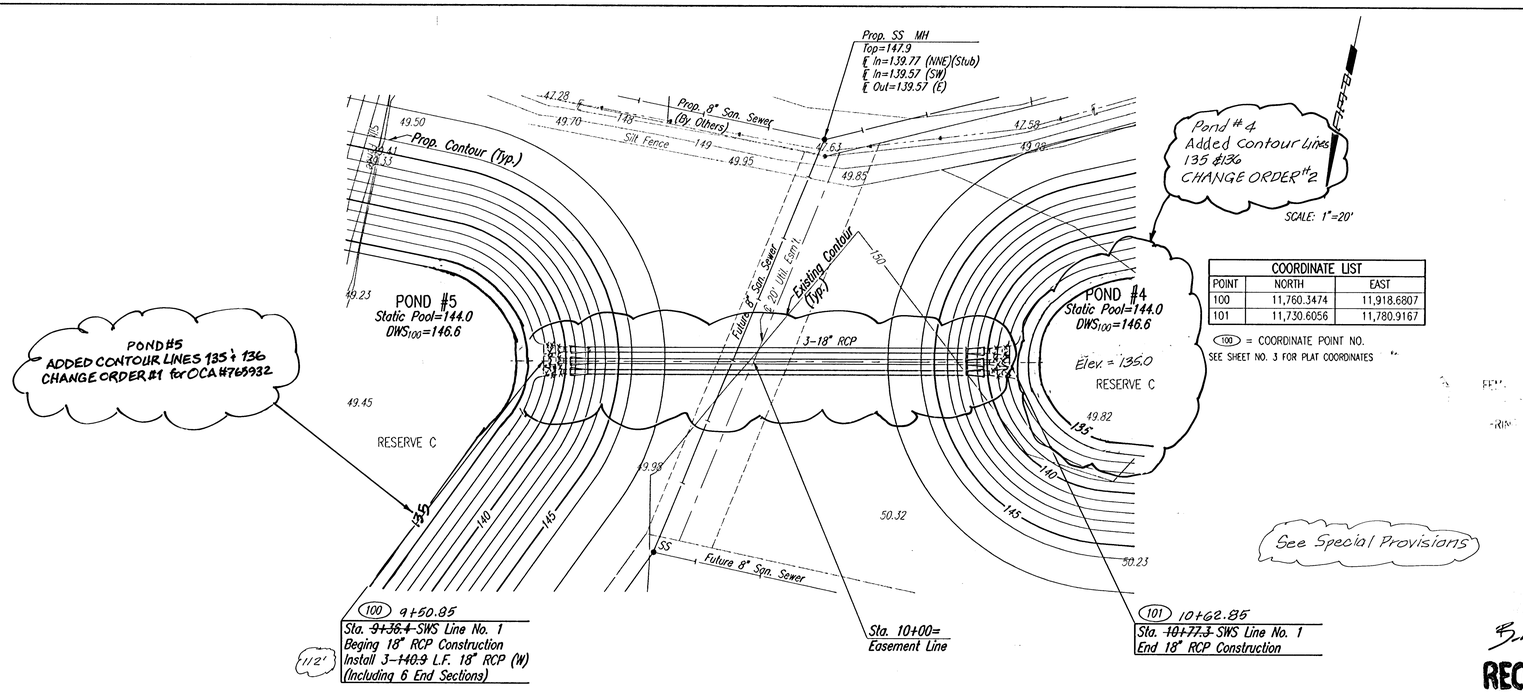


COORDINATE LIST		
POINT	NORTH	EAST
100	11,760.3474	11,918.6807
101	11,730.6056	11,780.9167

(100) = COORDINATE POINT NO.
SEE SHEET NO. 3 FOR PLAT COORDINATES

02 OCT 06
RECORD DRAWING

BRIAN D. BOUTWELL LICENSED PROFESSIONAL ENGINEER 10389 6-15-05

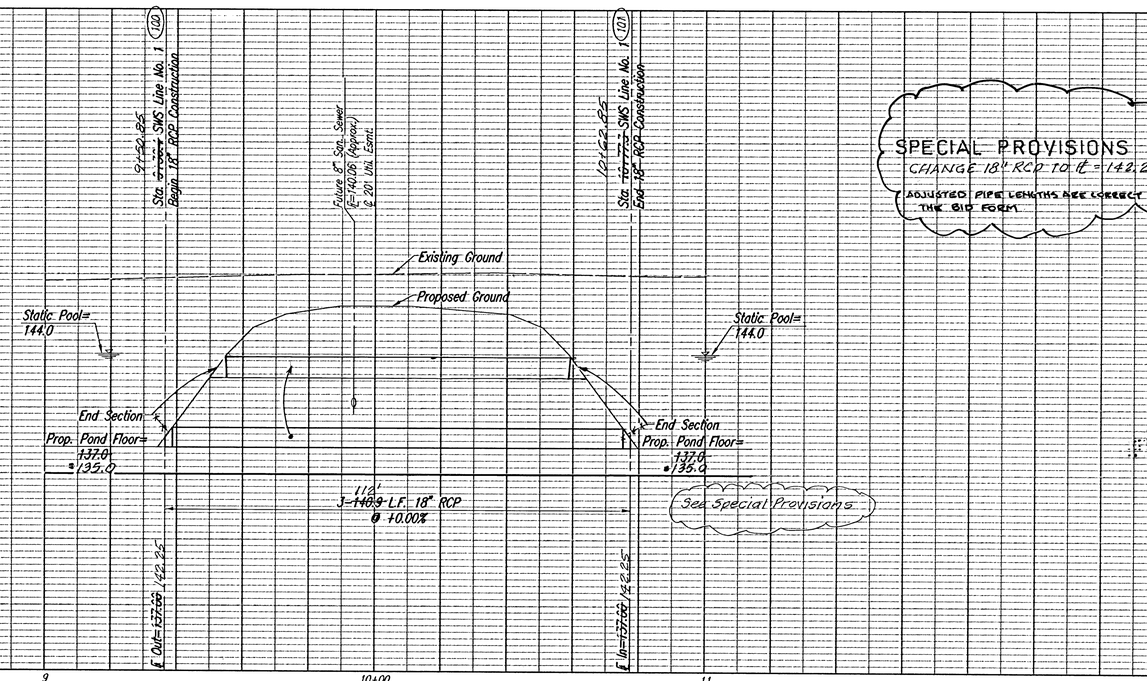

PLAN — CHECKED — CHECKED — BY — DATE

PROFILE — CHECKED — CHECKED — BY — DATE

DSNR: BJB OPER: BJS SCALE: 1=20.00
Q:\2005\05257\05257-C-SWSLINE 06-16-2005 12:10:29 cm

AVALON PARK 3RD
STORM WATER DRAIN NO. 264

SWS LINE NO. 1

JAMES L. ARMOUR, P.E.-CITY ENGINEER
CITY OF WICHITA PROJECT NO. 468-84011

Professional Engineering Consultants, P.A.
303 S. TOPEKA • WICHITA, KANSAS 67202
316-262-2691 • FAX 316-262-5063

Designed By	BDB, BJB	Job No.	35-05257
Drawn By	BJS	Date	February 2005

Sheet 9 of 31