

Sedgwick County East Yard Add.

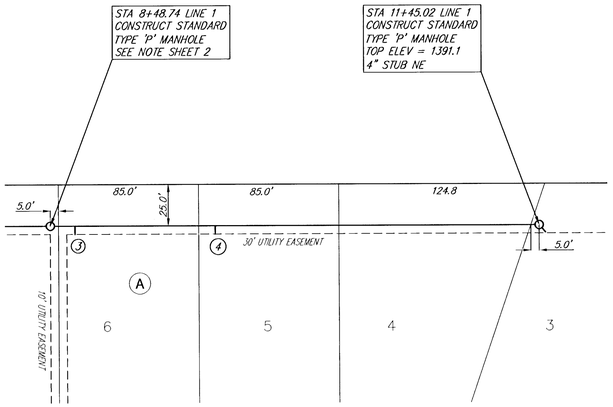

SCALE: Plan 1" = 40'
Profile 1" = 40' (Horiz.)
1" = 5' (Vert.)

Brentwood South 2nd Add.

Brentwood South Add

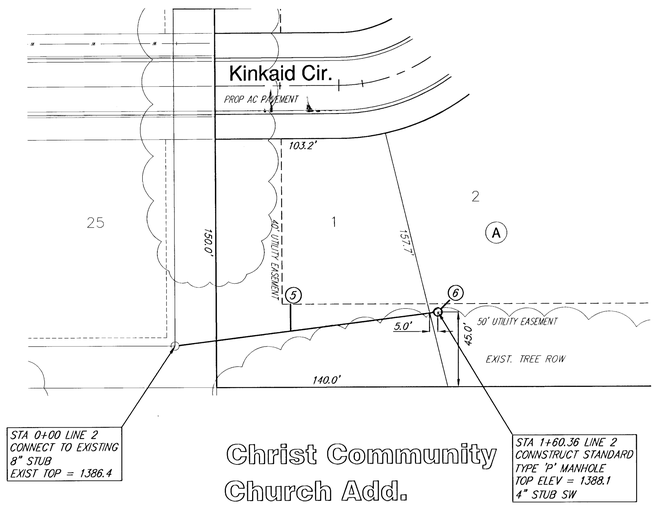

Christ Community Church Add.

SEWER SERVICE TABLE

NUMBER	TYPE	LOCATION			STATION\ DIRECTION	FOR INFORMATION ONLY	
		LOT NO.	BLOCK NO.	LINE NO.		APPROXIMATE LENGTH 4" PIPE	
						VERTICAL	HORIZONTAL
3	8" X 4" Inline Wye	6	A	1	8+~~63.74~~64/E	11'	~~5~~6'
4	8" X 4" Inline Wye	5	A	1	9+~~18.74~~29/E	11'	5'
5	8" X 4" Inline Wye	1	A	2	0+70.~~5~~/S	11'	~~17~~18'
6	4" MANHOLE	2	A	2	1+60.~~36~~/S	11' MH~~Stub~~ ~~10'~~	

NOTE: Vertical Riser Pipe shall be extended to 2' minimum above ground water elevation and 4' maximum below proposed ground elevation.

SCALE: Plan 1" = 40'
Profile 1" = 40' (Horiz.)
1" = 5' (Vert.)

TRIM OR REMOVE TREES ONLY AS NECESSARY FOR CONSTRUCTION COST SUBSIDIARY TO BID THEM FOR SITE CLEARING AND RESTORATION



REVISED	
DRAWN	EJG
DESIGN	CWB
DATE	July 13, 2004
UTILITY	
REVIEW	
PROJECT NUMBER	468-83802
DRAWING NO.	SS {SSD1}

BRENTWOOD SOUTH 2ND ADDITION
SANITARY SEWER
WICHITA, KANSAS

Ruggles & Bohm, P.A.
Engineering, Surveying, Land Planning
924 North Main
Wichita, Kansas 67203
www.rbkansas.com
(316) 264-8008
(316) 264-4621 fax
E-mail: info@rbkansas.com

RB JOB 2585E
SHEET 3 of 13